


PLAN
 SHEET NO. 77
 PROJECT NO. 101
 DATE 3-85

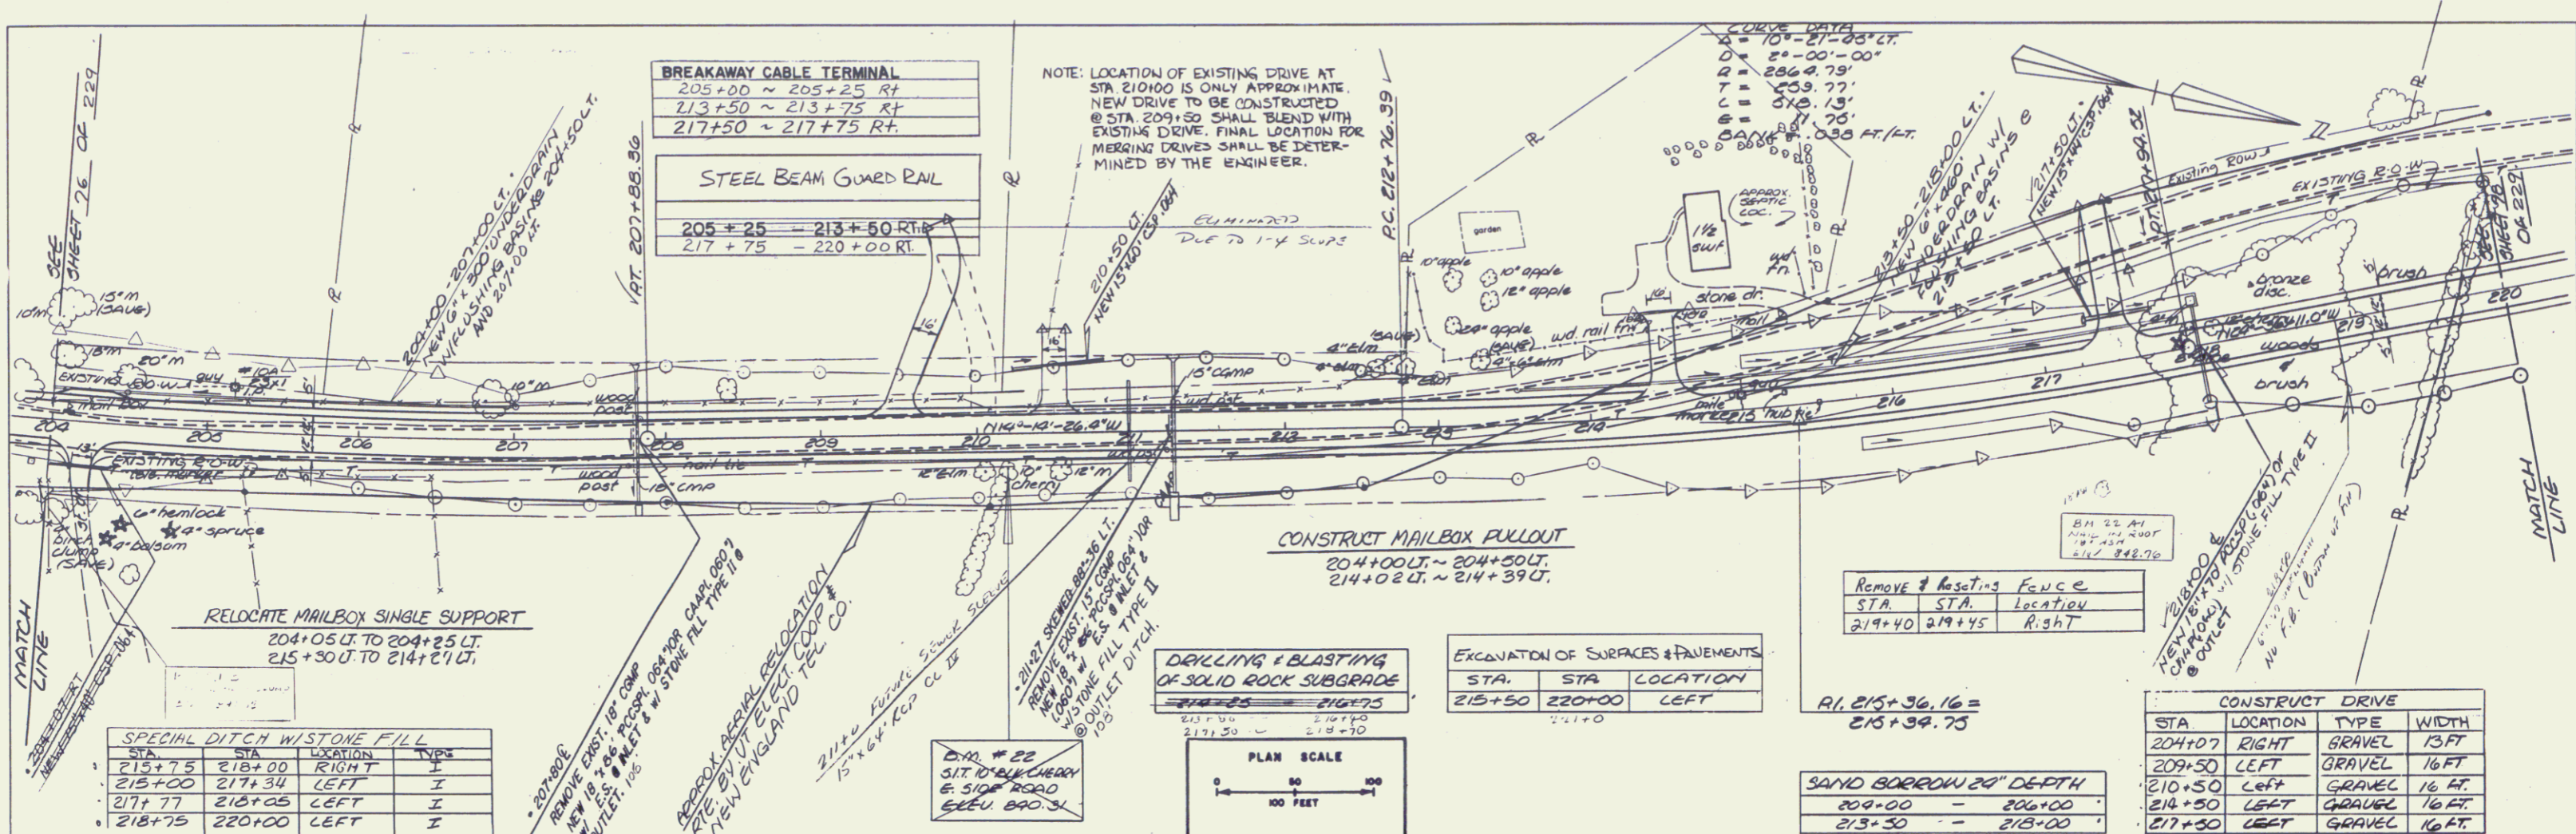

STA.	STA.	LOCATION	TYPE
215+75	218+00	RIGHT	I
215+00	217+34	LEFT	I
217+77	213+05	LEFT	I
218+75	220+00	LEFT	I

STA.	STA.	LOCATION
215+50	220+00	LEFT


RI. 215+36.16 = 213+39.75

SAND BORROW 20" DEPTH
 209+00 - 206+00
 213+30 - 213+00

STA.	LOCATION	TYPE	WIDTH
204+07	RIGHT	GRAVEL	13 FT
209+50	LEFT	GRAVEL	16 FT
210+50	LEFT	GRAVEL	16 FT
214+50	LEFT	GRAVEL	16 FT
217+50	LEFT	GRAVEL	16 FT



DATUM: NATIONAL GEODETIC VERTICAL DATUM 1929
 HORIZONTAL: VT. STATE COORDINATE SYSTEM

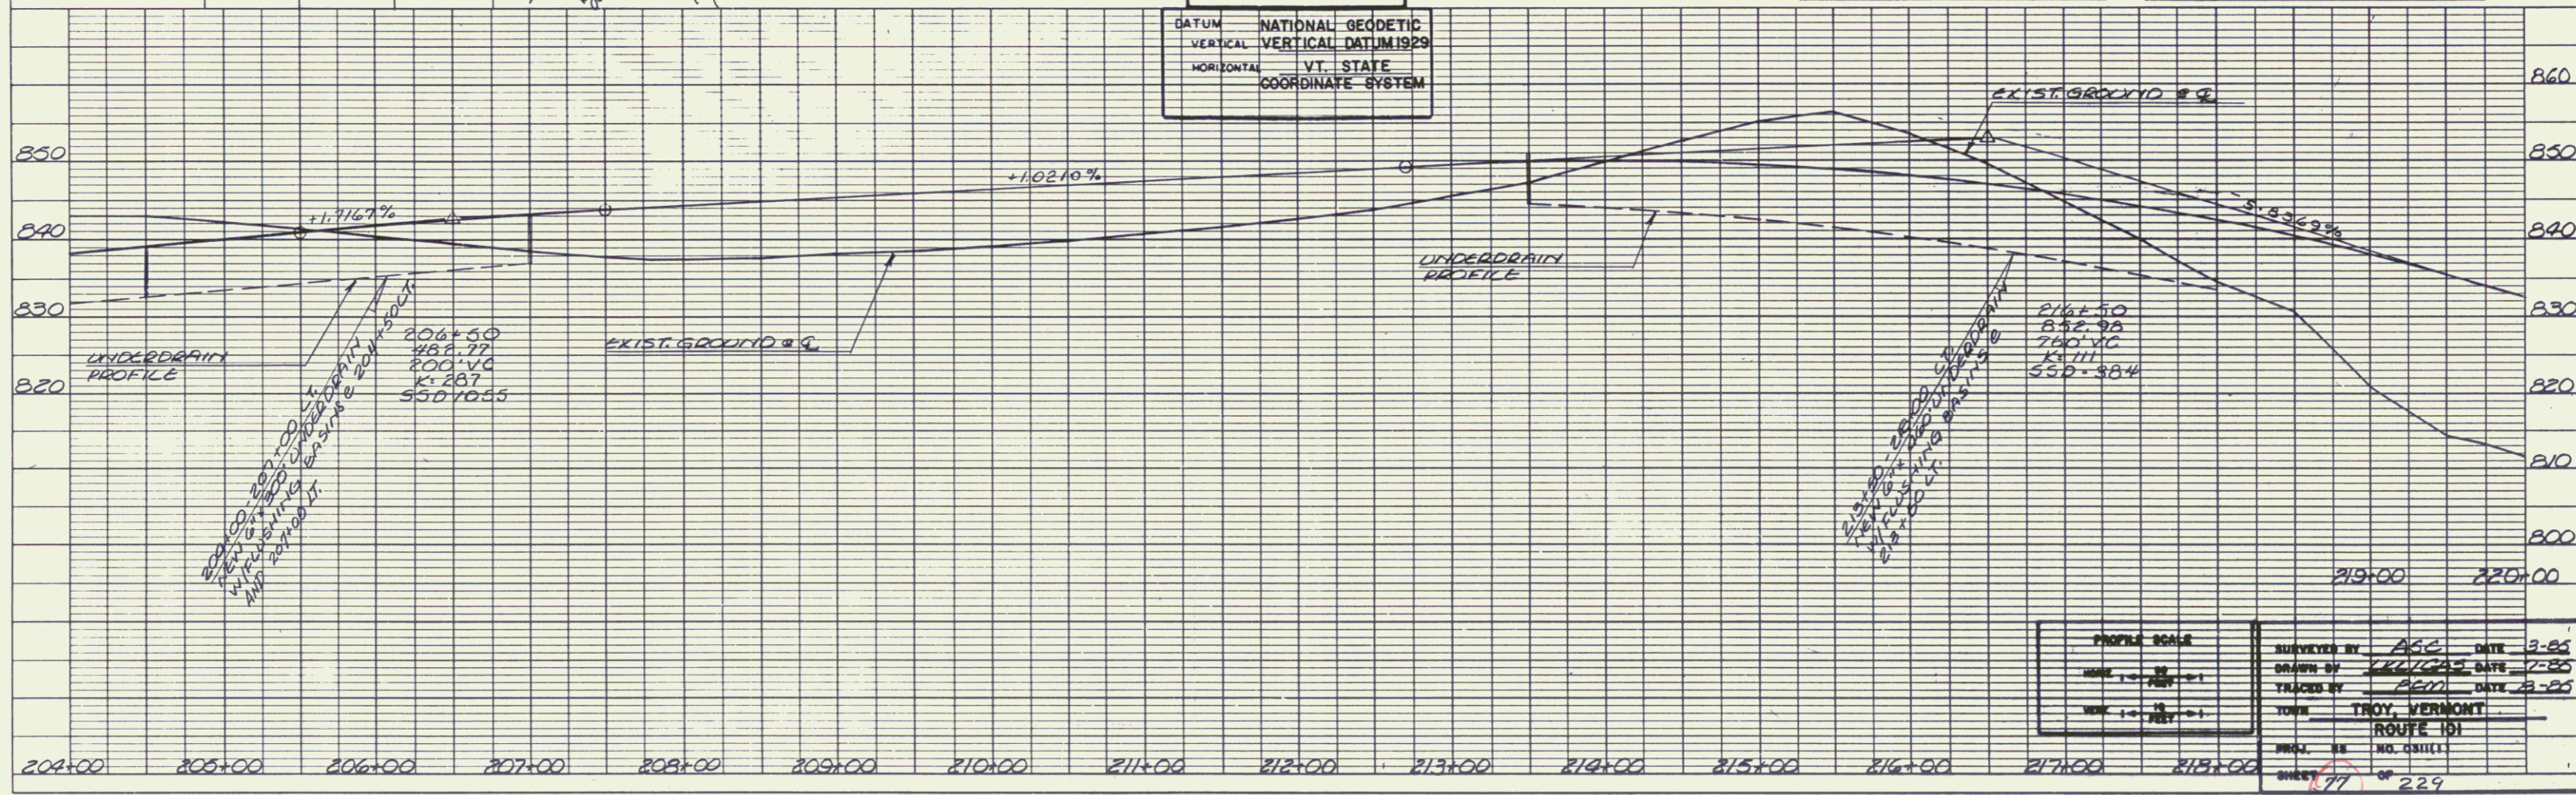

PROFILE
 SHEET NO. 77
 PROJECT NO. 101
 DATE 3-85

PROFILE SCALE: 1 inch = 10 feet
 SURVEYED BY: ASC DATE: 3-85
 DRAWN BY: K. G. DATE: 7-85
 CHECKED BY: ACN DATE: 3-85
 TOWN: TROY, VERMONT
 ROUTE: 101
 PROJ. NO.: 101
 SHEET: 77 OF 229

MAR 29 1995 7:47