
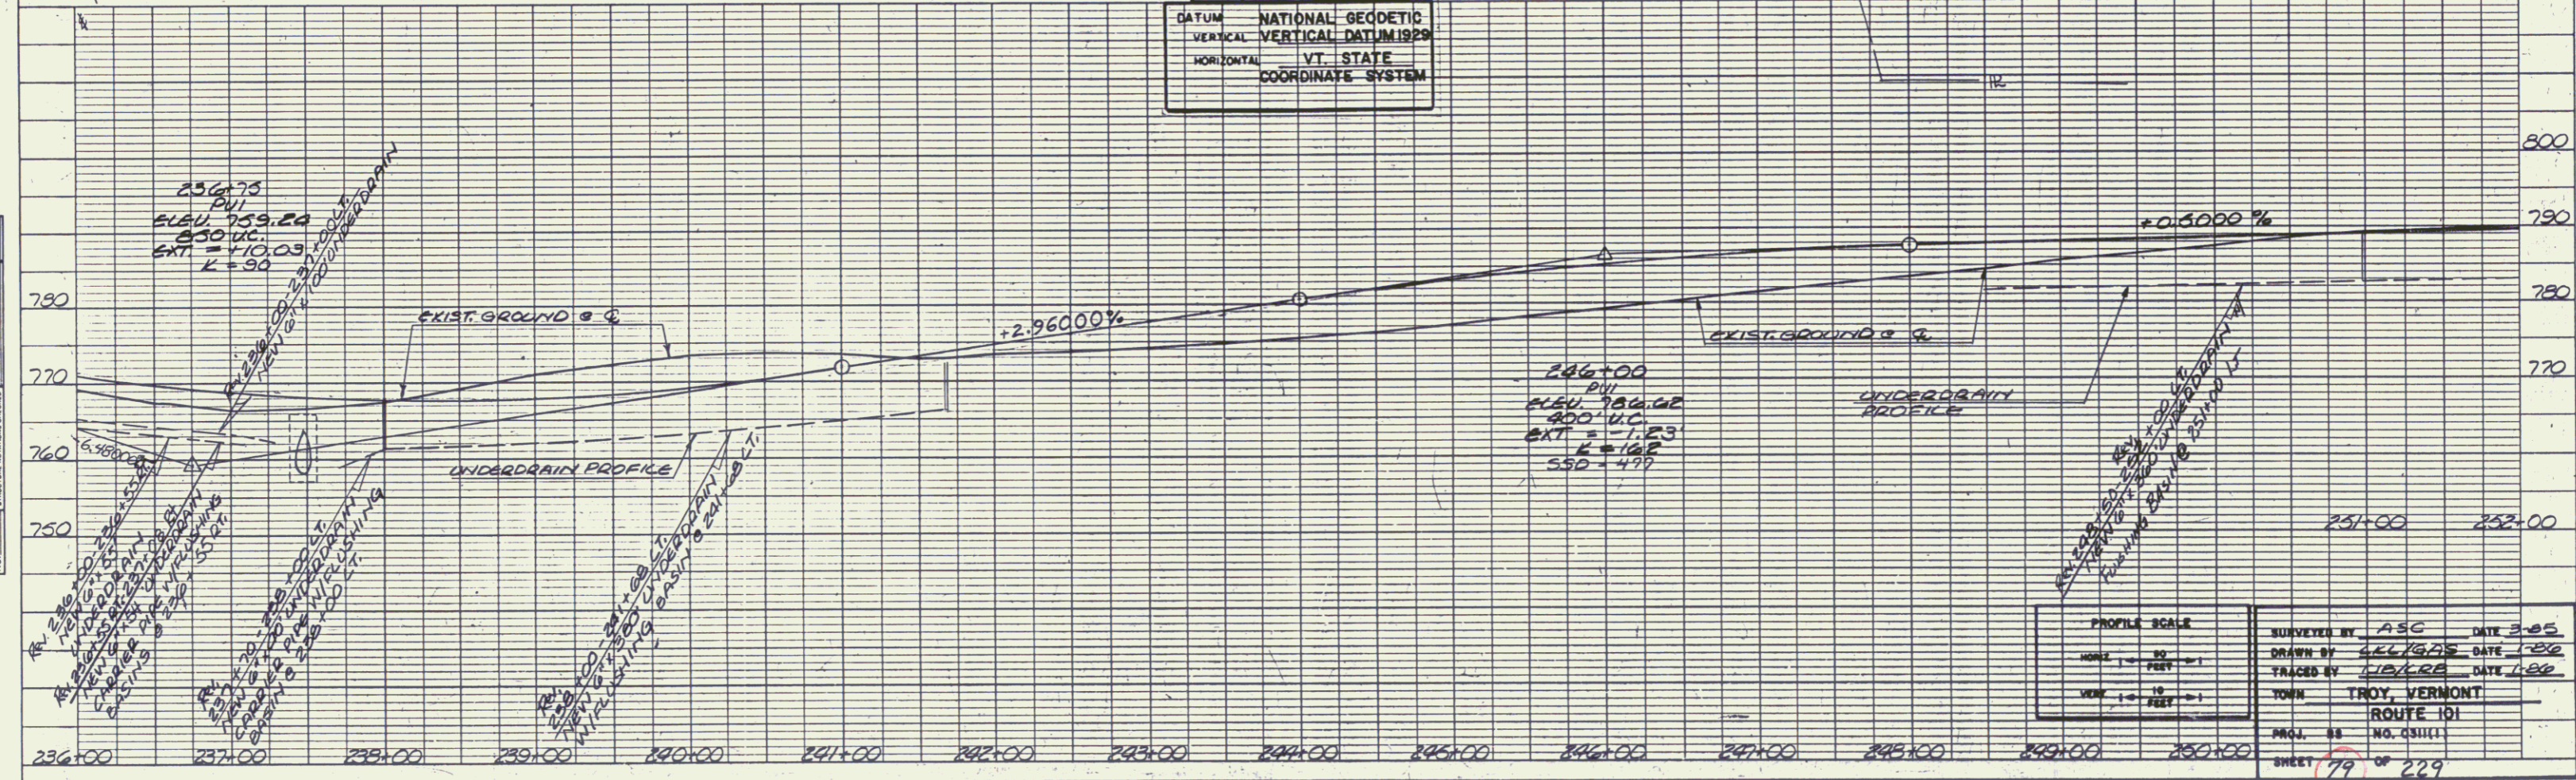


PLAN	DATE	BY
NOTE BOOK		

PROFILE	DATE	BY
NOTE BOOK		

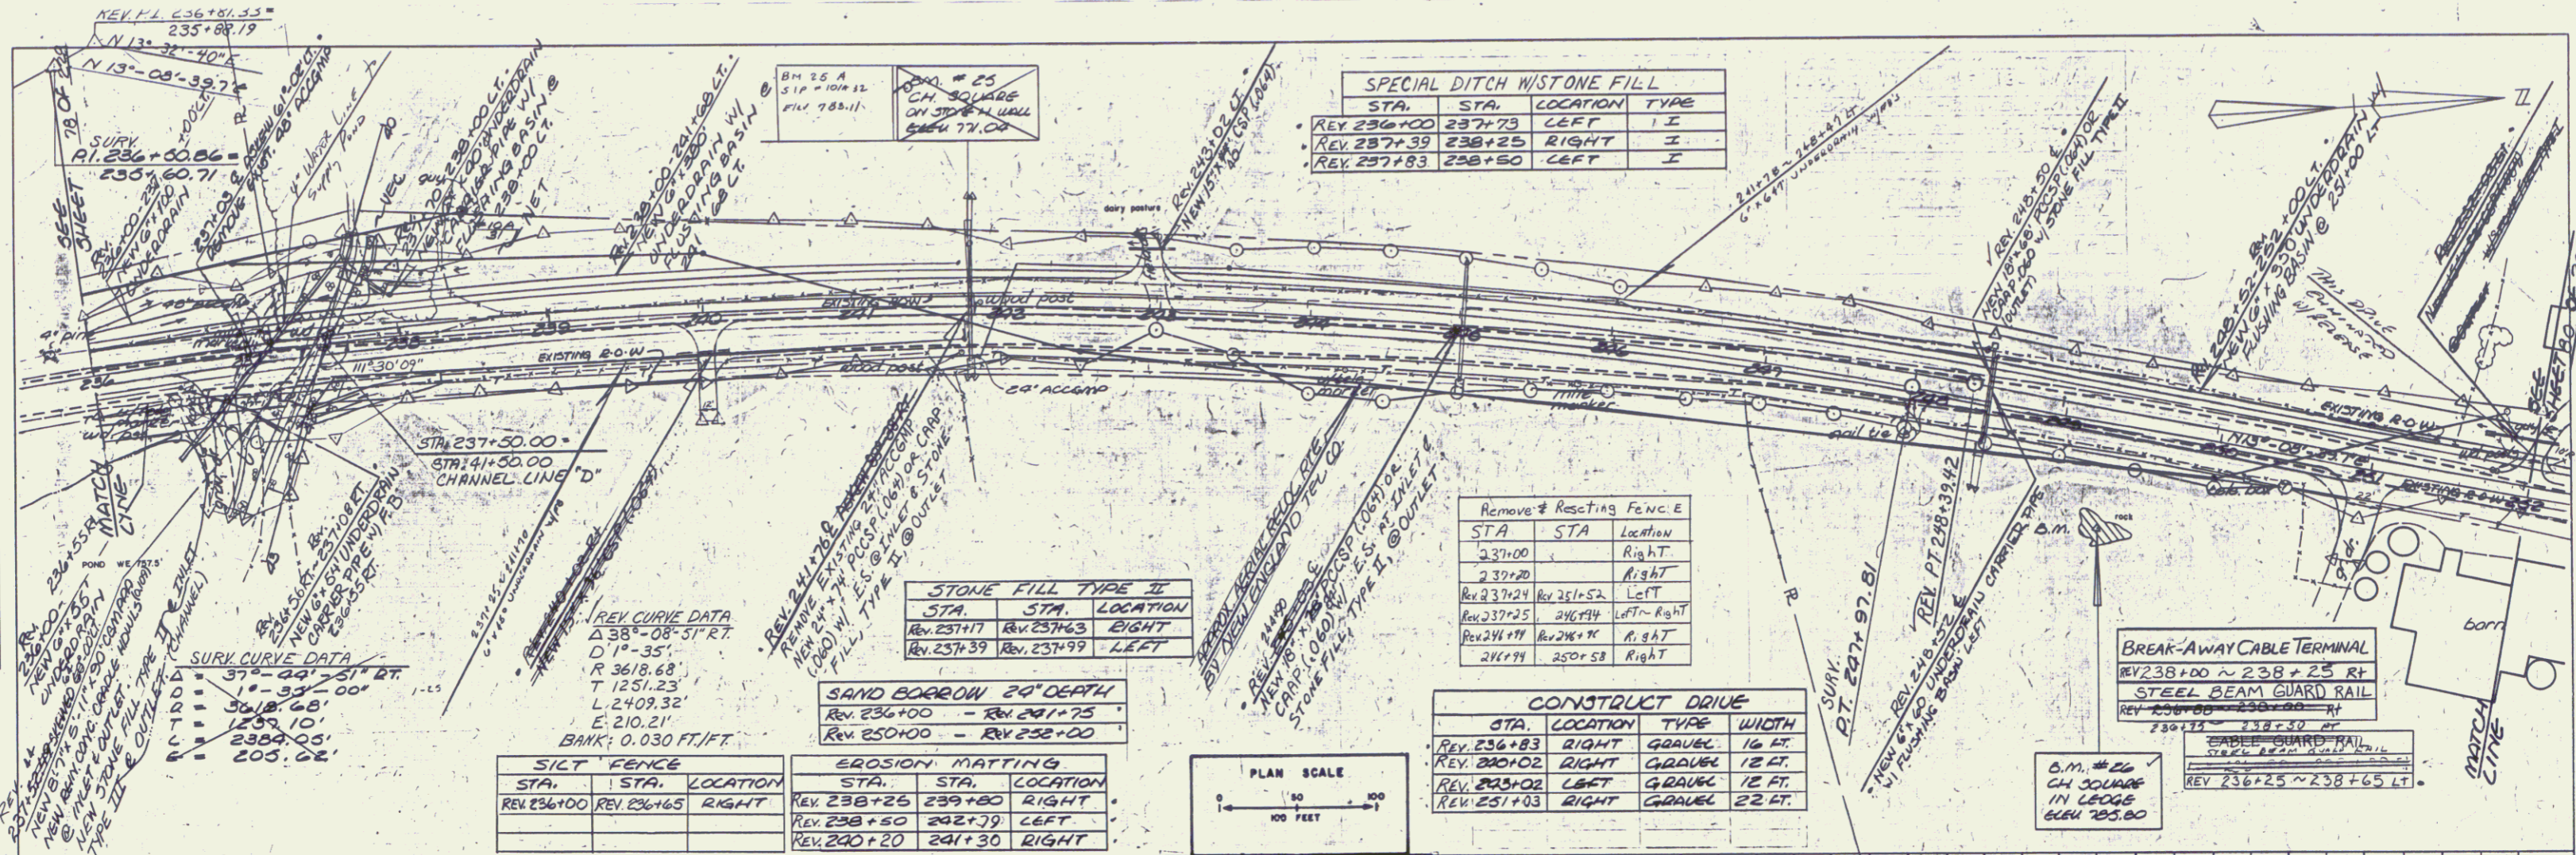

SURVEYED BY	ASC	DATE	3-85
DRAWN BY	WELLS	DATE	1-86
TRACED BY	WELLS	DATE	1-86
TOWN	TROY, VERMONT	ROUTE	101
PROJ.	88	NO.	23111
SHEET	79	OF	229

PLATE 1 PLAN-PROFILE OF R.S.S. STANDARD  
 REVISION CORPORATION  
 BOSTON & N.H.

MAR 29 1995 76