


PLAN
 SHEET NO. 80 OF 229
 DATE 3-25-85

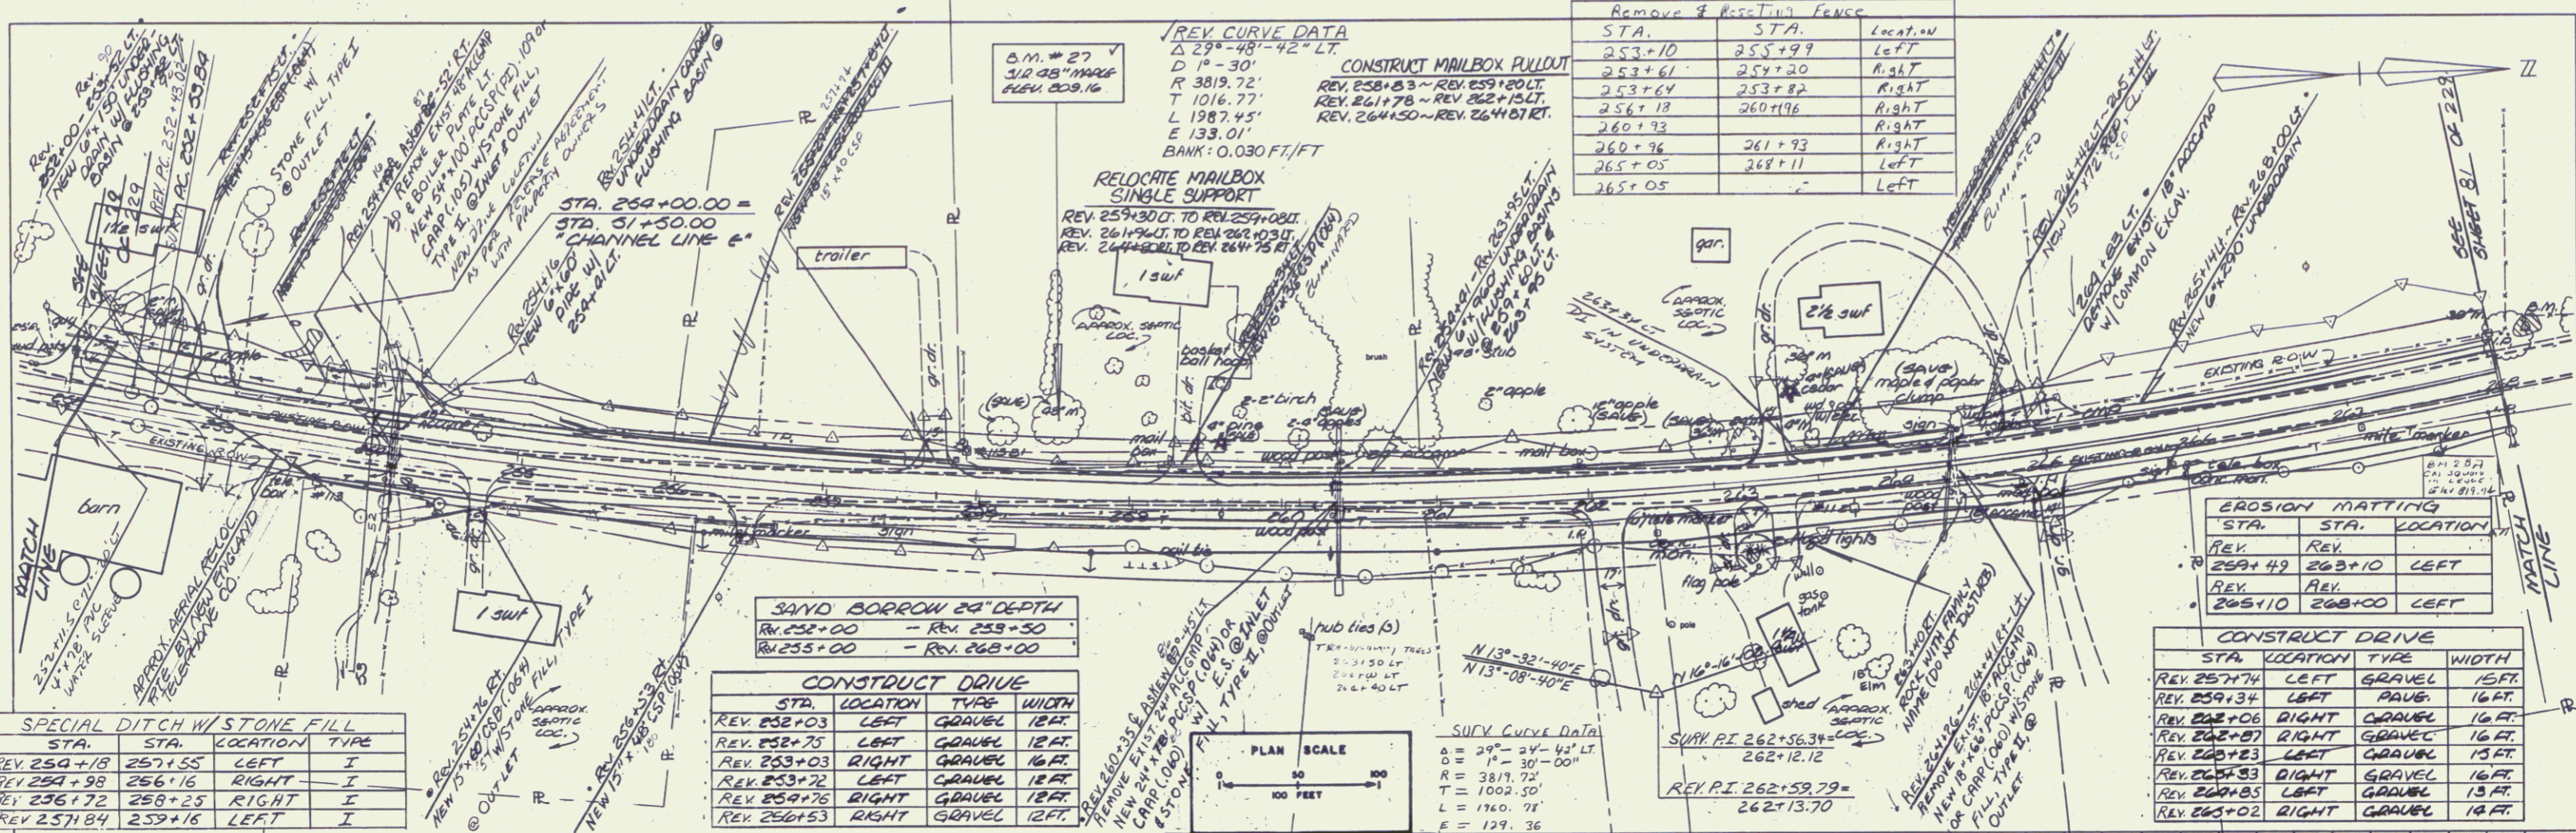

SPECIAL DITCH W/ STONE FILL

STA.	STA.	LOCATION	TYPE
REV 250+18	257+55	LEFT	I
REV 259+98	256+16	RIGHT	I
REV 256+72	258+25	RIGHT	I
REV 257+84	259+16	LEFT	I

CONSTRUCT DRIVE

STA.	LOCATION	TYPE	WIDTH
REV 252+03	LEFT	GRAVEL	12 FT.
REV 252+75	LEFT	GRAVEL	12 FT.
REV 253+03	RIGHT	GRAVEL	16 FT.
REV 253+72	LEFT	GRAVEL	12 FT.
REV 254+76	RIGHT	GRAVEL	12 FT.
REV 256+53	RIGHT	GRAVEL	12 FT.

EROSION MATTING


STA.	STA.	LOCATION
REV 259+49	263+10	LEFT
REV 265+10	268+00	LEFT

CONSTRUCT DRIVE

STA.	LOCATION	TYPE	WIDTH
REV 257+74	LEFT	GRAVEL	15 FT.
REV 259+134	LEFT	PAVE.	16 FT.
REV 262+06	RIGHT	GRAVEL	16 FT.
REV 262+87	RIGHT	GRAVEL	16 FT.
REV 265+23	LEFT	GRAVEL	13 FT.
REV 265+33	RIGHT	GRAVEL	16 FT.
REV 266+85	LEFT	GRAVEL	13 FT.
REV 266+02	RIGHT	GRAVEL	14 FT.

DATUM NATIONAL GEODETIC
 VERTICAL DATUM 1929
 HORIZONTAL VT. STATE
 COORDINATE SYSTEM

PROFILE
 SHEET NO. 80 OF 229
 DATE 3-25-85

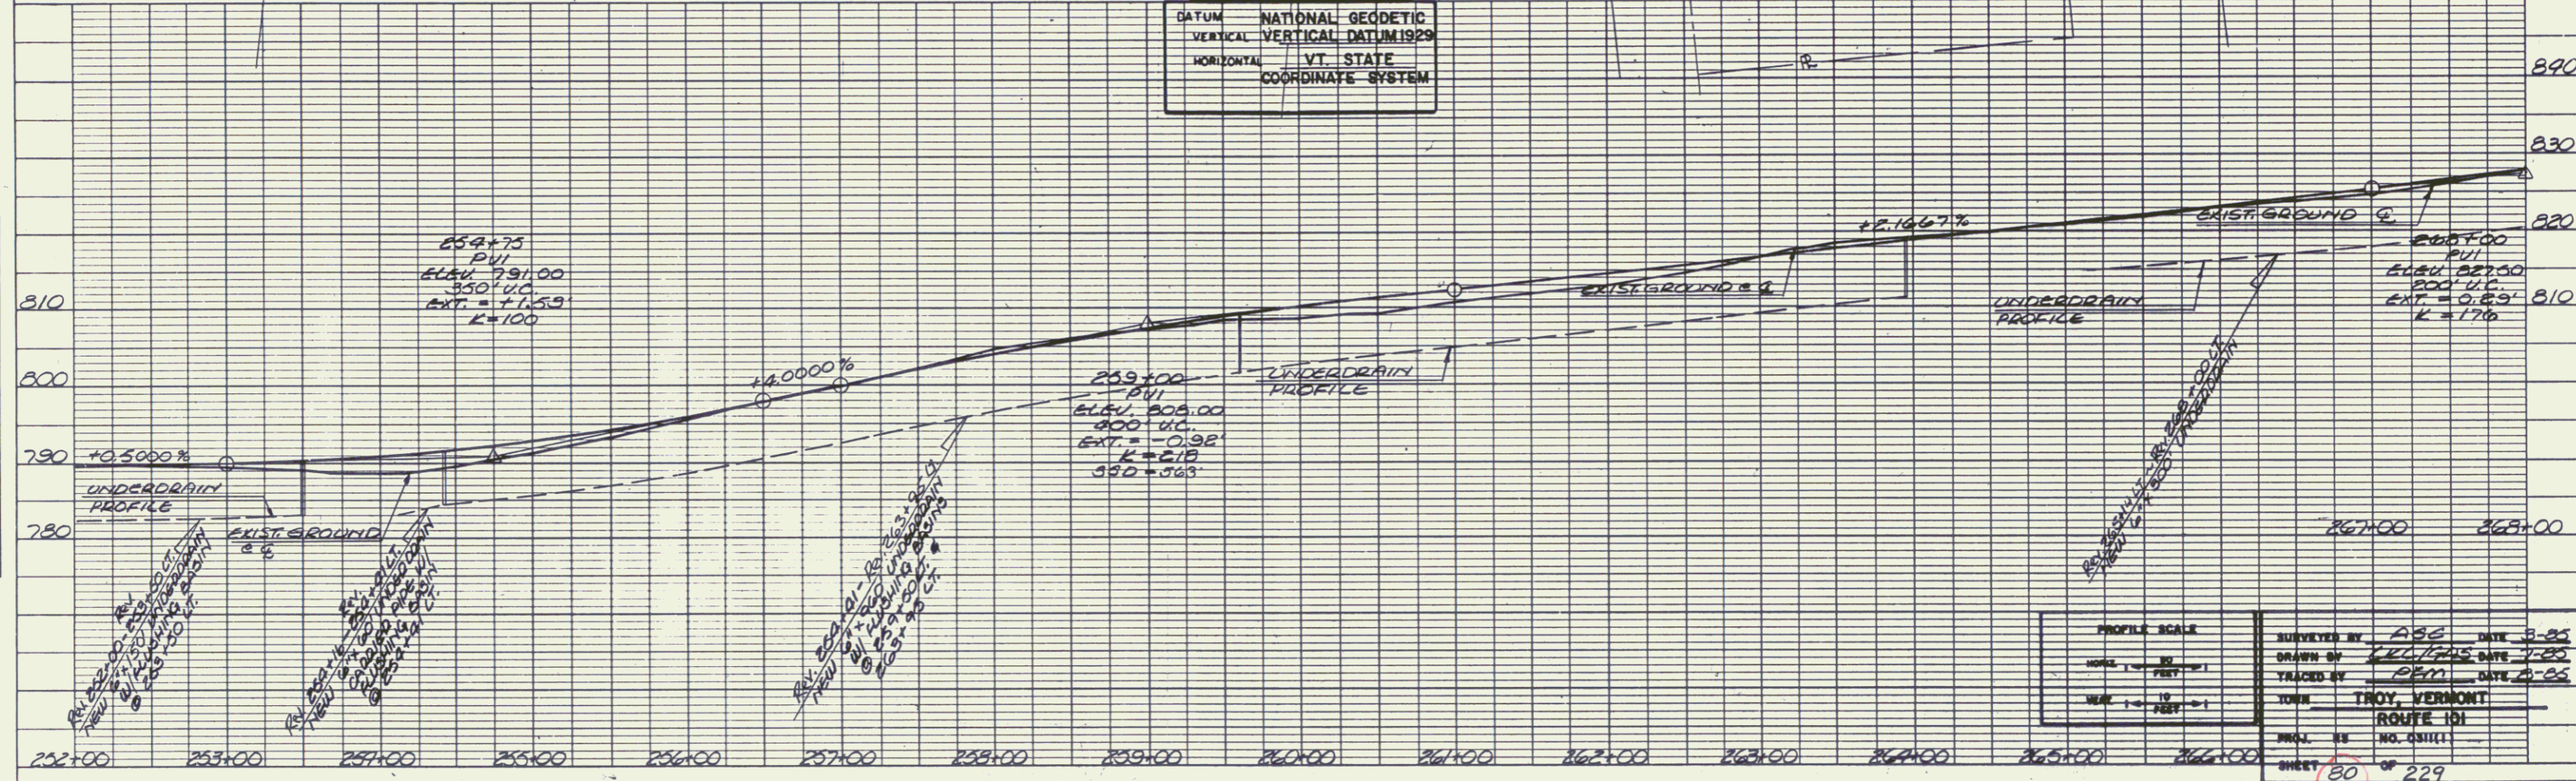

PROFILE SCALE
 HORIZ. 1" = 40'
 VERT. 1" = 10'

SURVEYED BY ASD DATE 3-85
 DRAWN BY JEC/STG DATE 7-85
 CHECKED BY JEM DATE 2-85
 TOWN TROY, VERMONT
 ROUTE 151
 SHEET 80 OF 229