


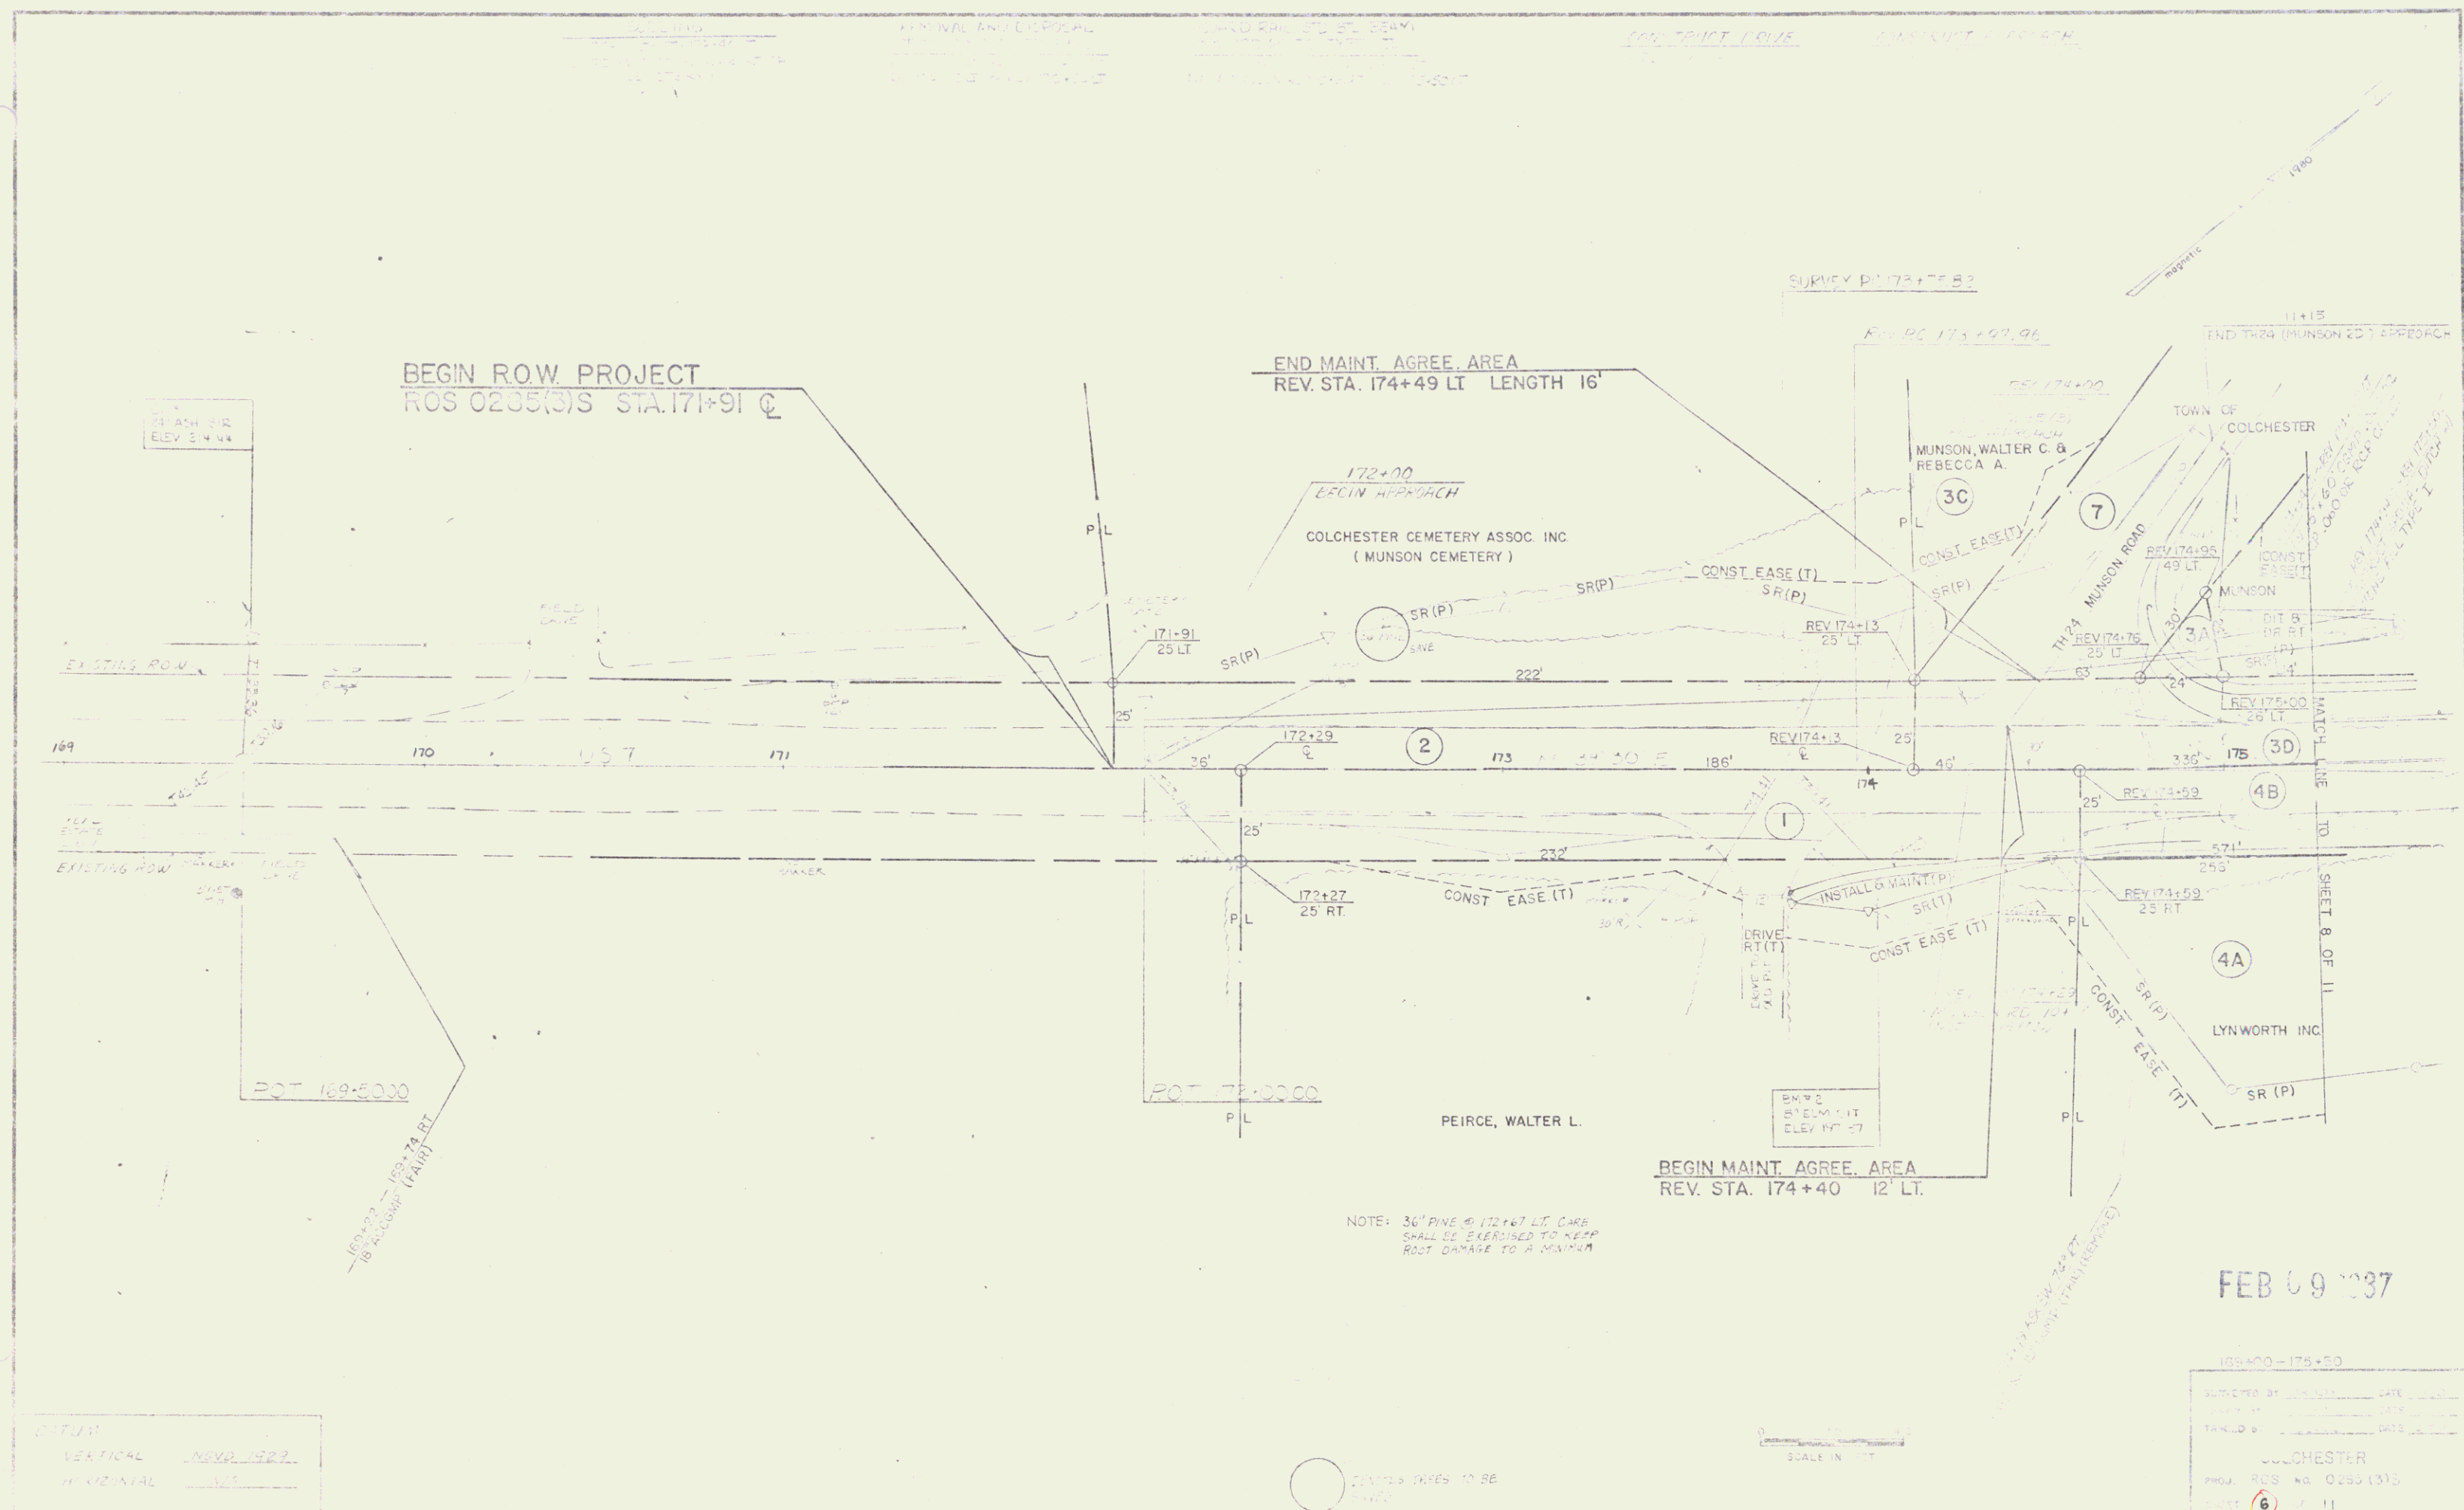

VERTICAL NOV 1937
HORIZONTAL NOV 1937

SUBMITTED BY	DATE
THROU	DATE
APPROVED	DATE
PROJECT NO.	DATE
PROJECT	DATE

COLCHESTER
PROJECT NO. 0235(3)S
SHEET 6 OF 11

3