
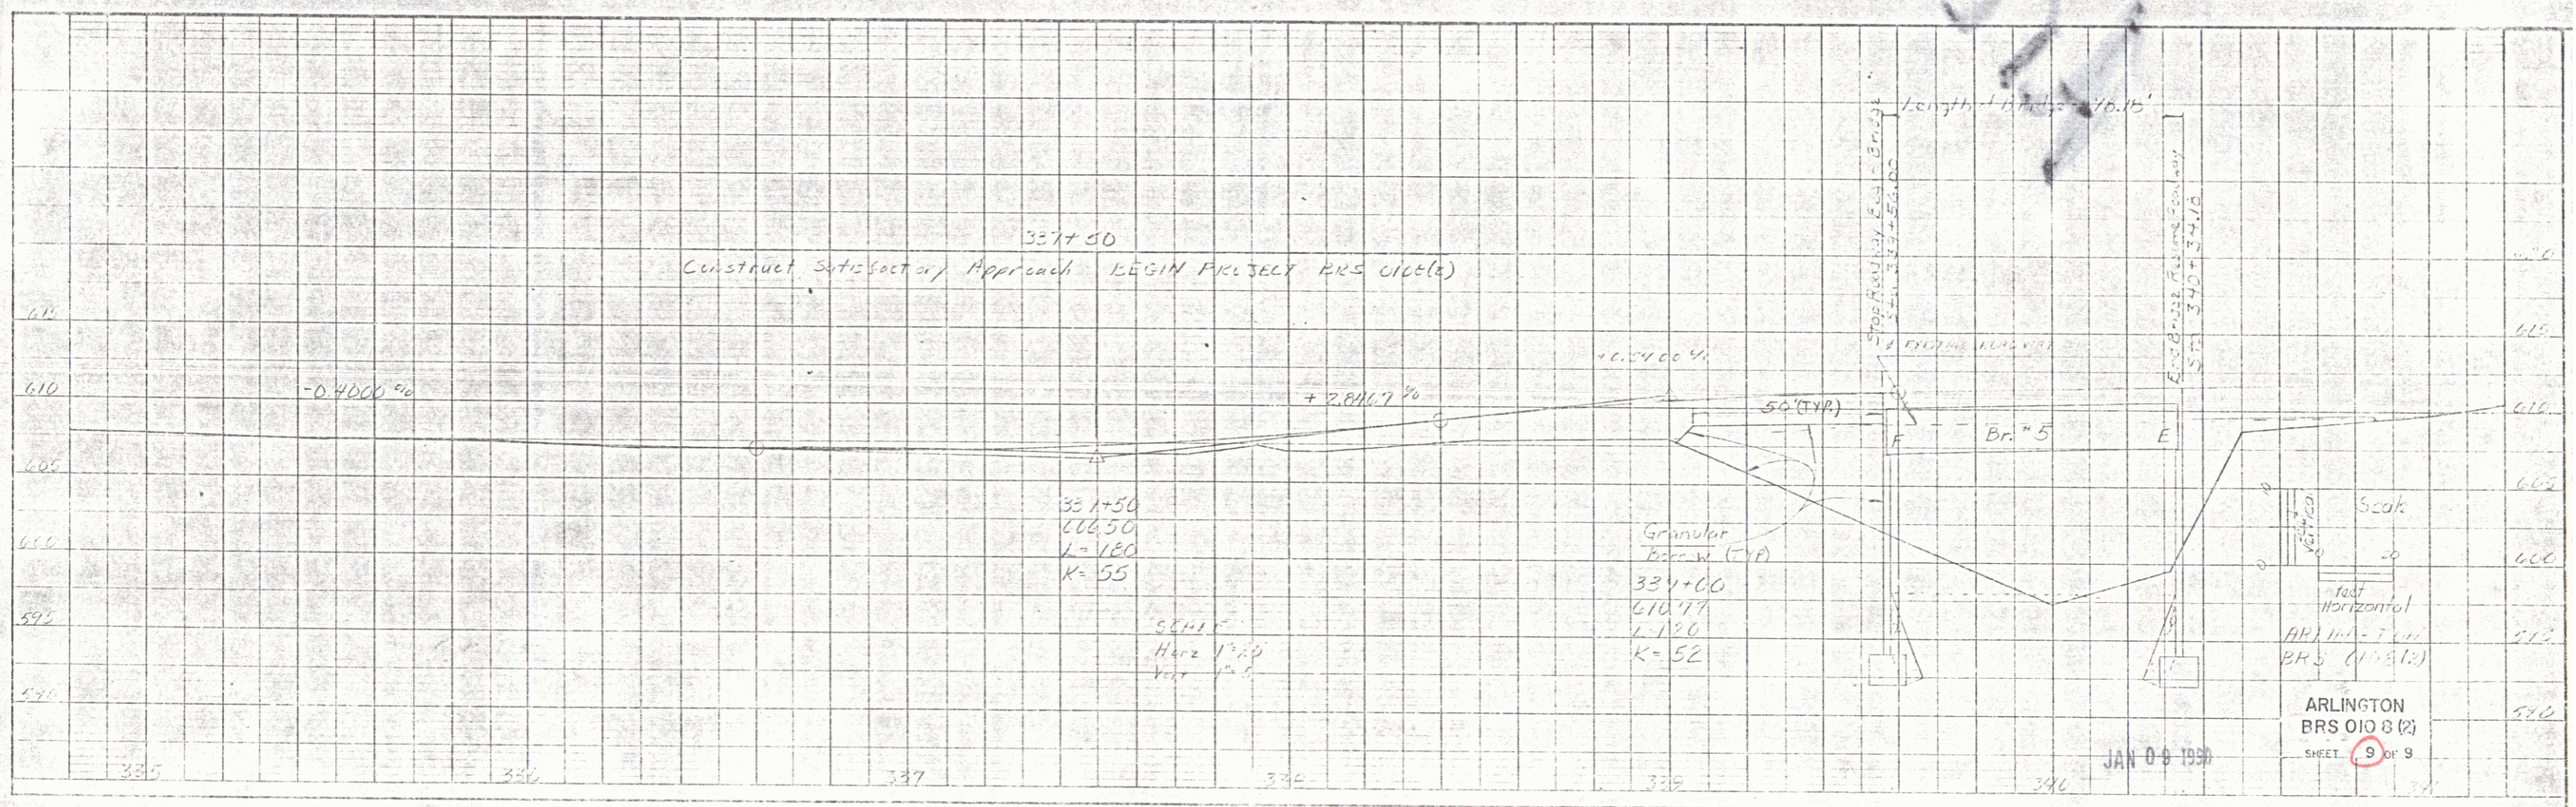


POOR ORIGINAL COPY

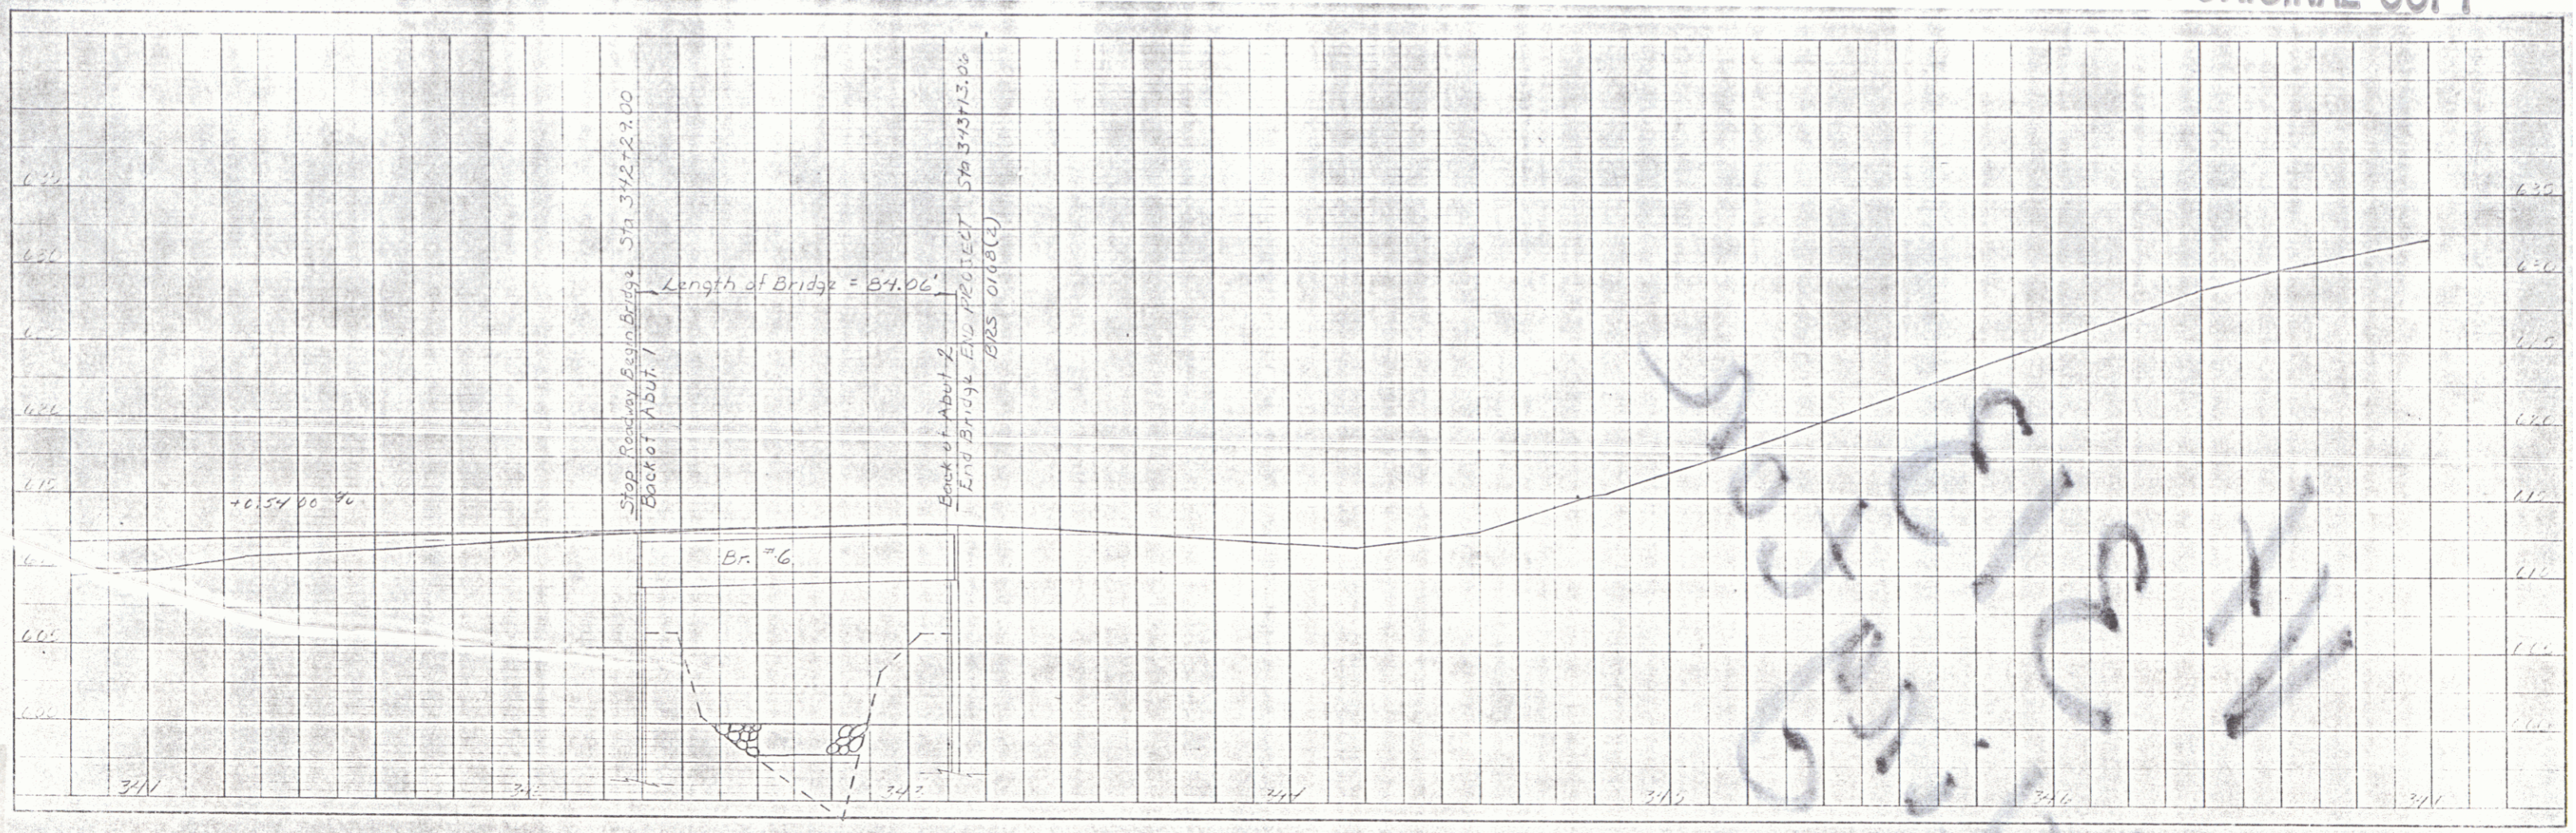

ARLINGTON  
BRS 010 B (2)  
SHEET 9 OF 9

JAN 0 9 1999

K&E PLATE & SIGN FOLDER  
MAYNARD & BERRY CO.

5