
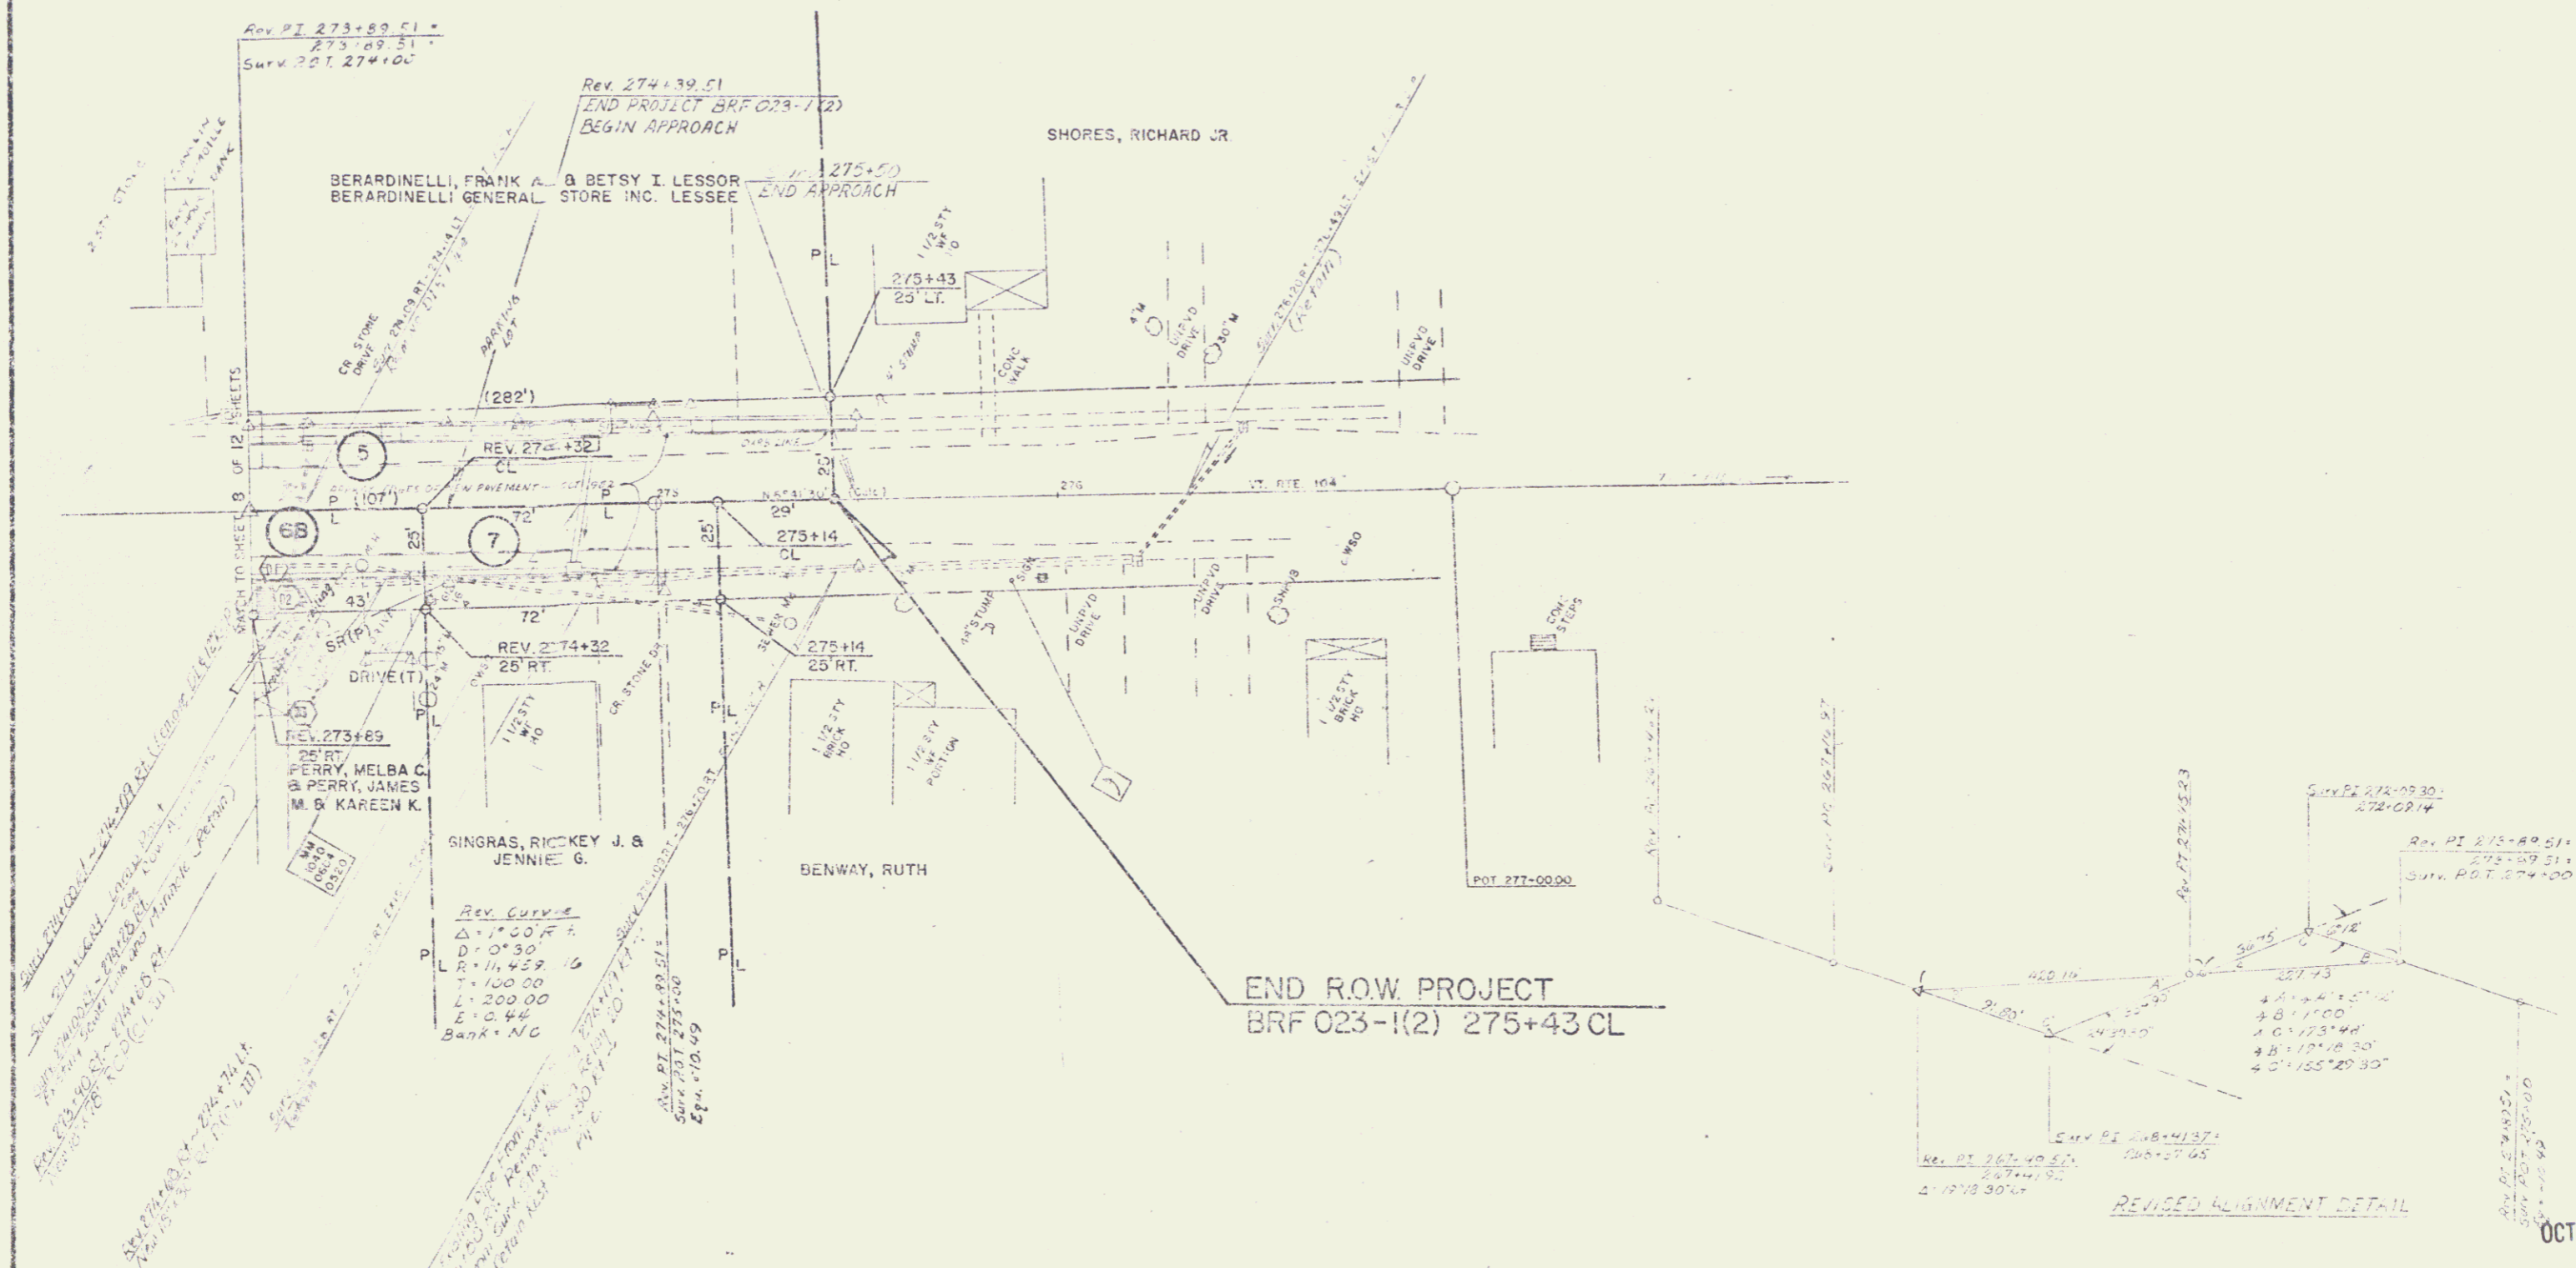


CONSTANT GRADE CONCRETE SHOULDER
 TO 275+00 LT - 275+00 RT
 Rev. 274+13 LT (Gravel)
 Rev. 274+03 LT (Gravel)
 SURV. 275+00 LT - 275+00 RT

CONSTANT GRADE
 REV. 274+13 LT (Gravel)
 REV. 274+03 LT (Gravel)
 REV. 274+09 LT (Gravel)

ENTRANCING CONCRETE SHOULDER (4")
 REV. 275+00 LT - 275+00 RT

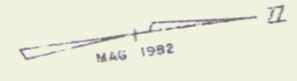

DATUM
 VERTICAL: NAD 83
 HORIZONTAL: N/A

NOTE
 SEE PROFILE SHEETS FOR ALIGNMENT TIES
 SCALE IN FEET
 0 10 20 30 40 50

SURVEYED BY: BERRY DATE: 1-82
 DRAWN BY: SK JANOWICZ DATE: 1-82
 TRACED BY: SK JANOWICZ DATE: 5-82
 FORTRAN
 PROJ. BRT NO. 023-1(2)
 SHEET 9 OF 12

OCT 3 1986

4