


PLAN
 NOTE BOOK
 NO. OF SHEETS
 NO.

PROFILE
 NOTE BOOK
 NO. OF SHEETS
 NO.

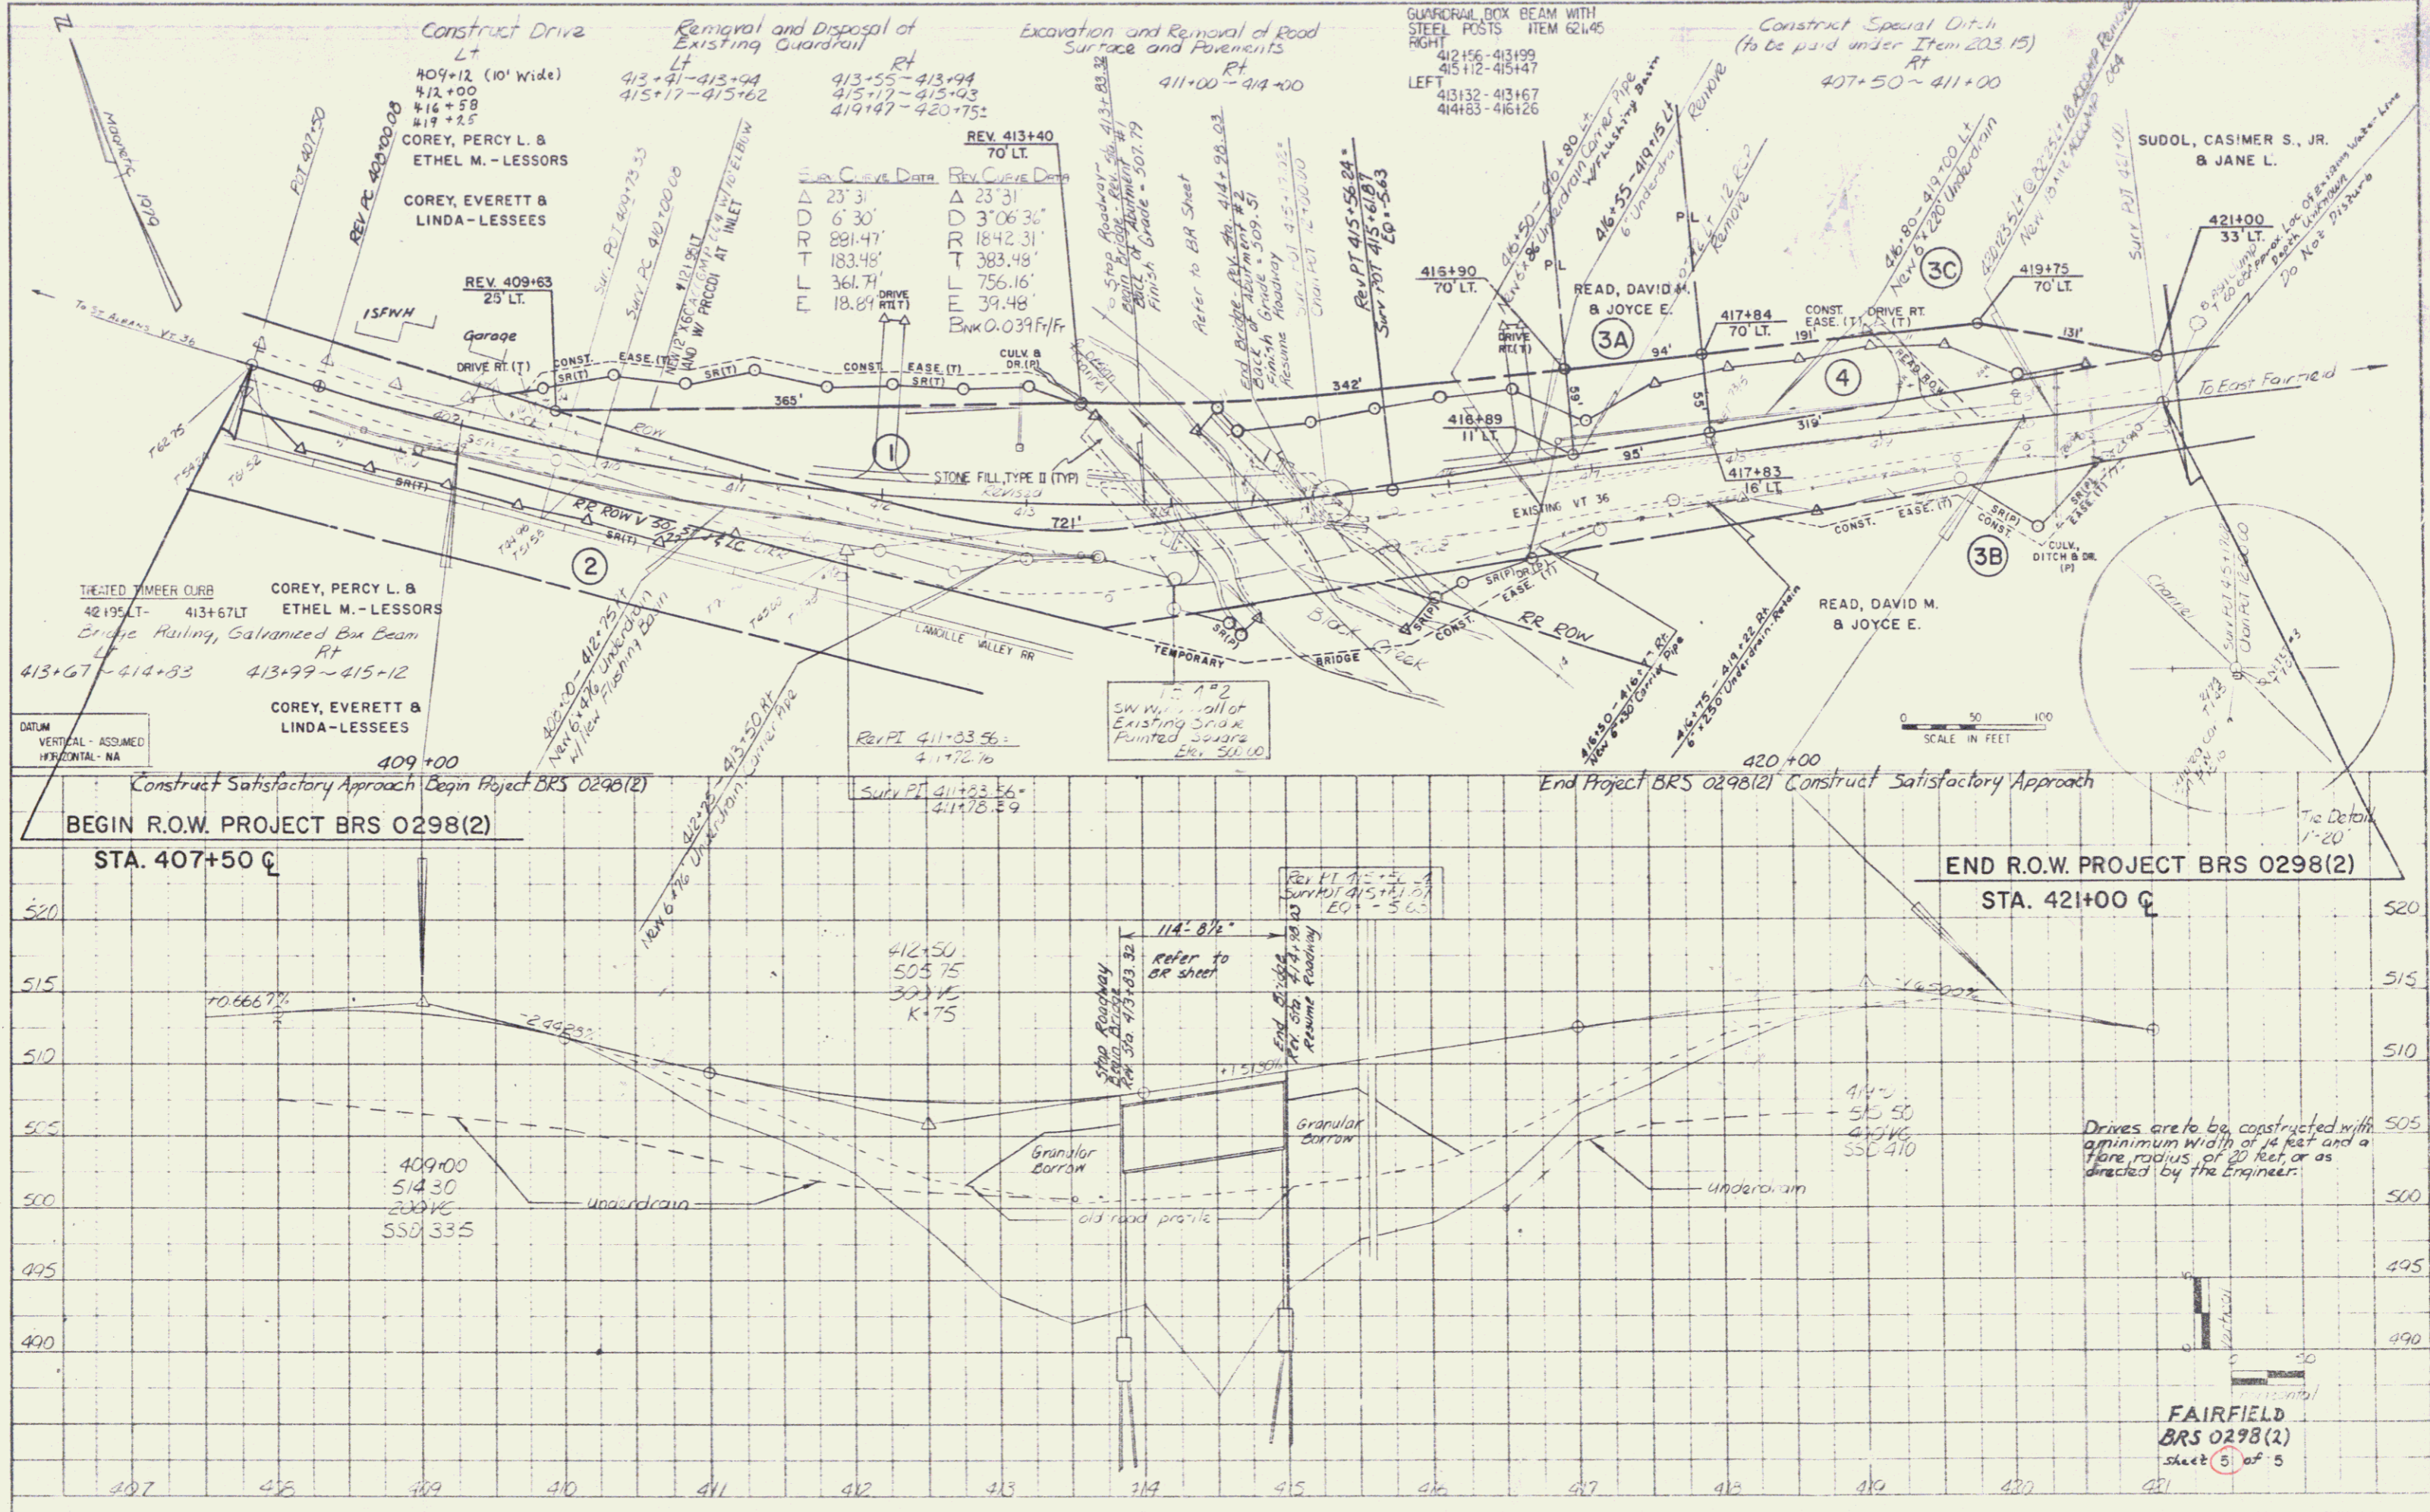

K&E PLATE 1, PLAN/PROFILE
 10/19/84 & 1/14/85

FAIRFIELD
 BRS 0298(2)
 sheet 5 of 5