


INDEX OF SHEETS



# STATE OF VERMONT AGENCY OF TRANSPORTATION



## PROPOSED IMPROVEMENT TOWN OF FAIRFIELD COUNTY OF FRANKLIN VERMONT RTE. 36

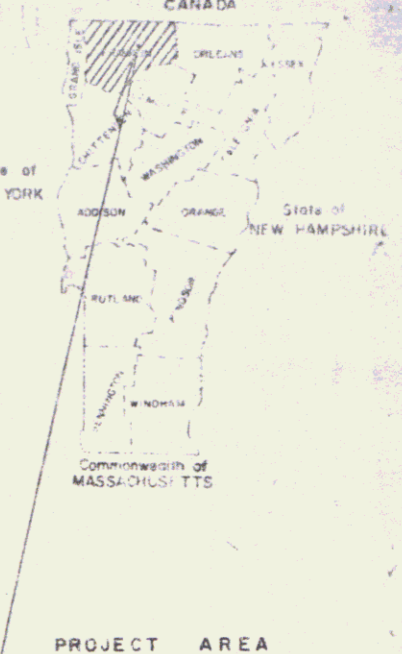


### R.O.W. PLANS

BEGINNING AT A POINT APPROXIMATELY 2.263 MILES WESTERLY OF THE FAIRFIELD-BAKERSFIELD TOWN LINE AND EXTENDING EASTERLY 0.207 MILES

LENGTH OF ROADWAY 879.66 FEET 0.185 MILES  
 LENGTH OF BRIDGE 114.71 FEET 0.022 MILES  
 LENGTH OF PROJECT 1094.37 FEET 0.207 MILES  
 LENGTH OF R.O.W. PROJECT = 1344.37 FEET = 0.255 MILES

EST. 1982 AADT = 890  
 EST. 2002 AADT = 1200  
 EST. 1982 DHV = 125  
 D = 5.2%  
 T = 5%  
 V = 40 M.P.H.

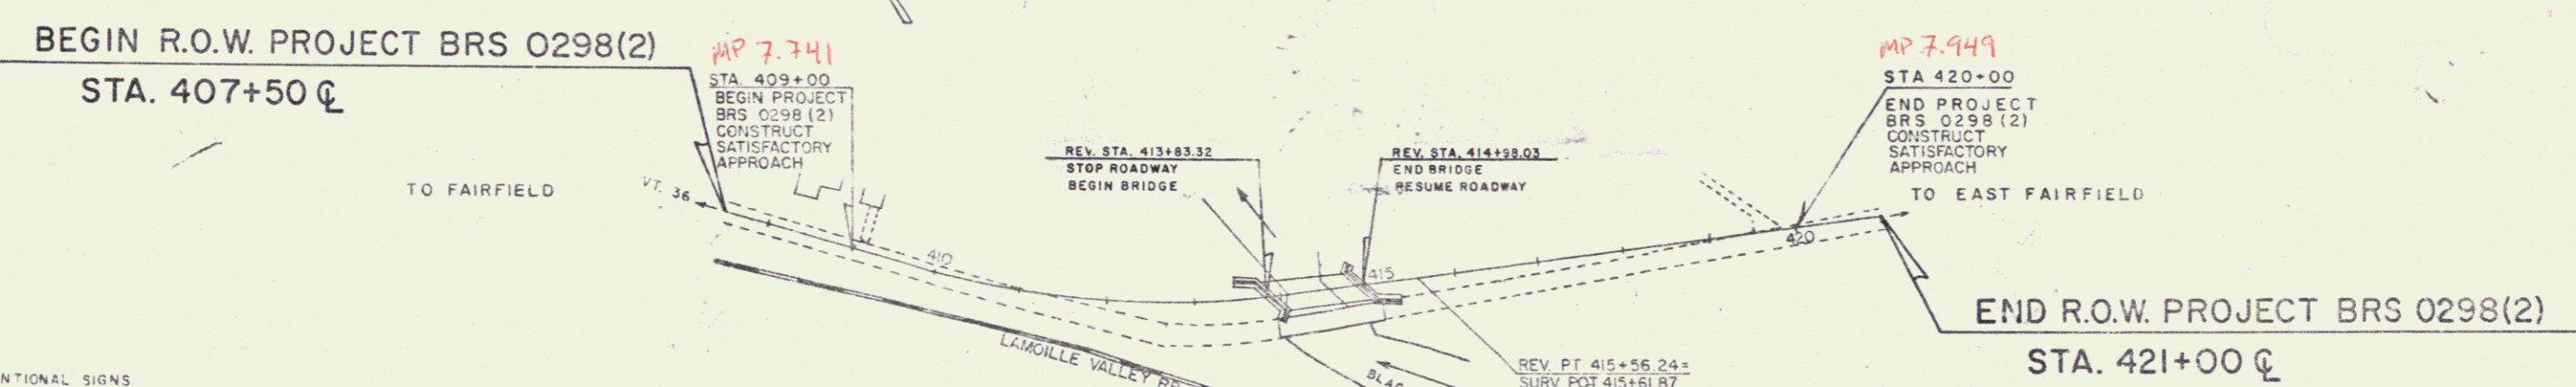

CONVENTIONAL SIGNS

COUNTY LINE	---
TOWN LINE	- - - -
LIMITS OF ACCESS	—○—
POINT OF ACCESS	X
FENCE LINE	—•—•—
STONE WALL	—•••••
TRAVELED WAY	—•••••
GUARD RAIL	—•••••
RAILROAD	—+—+—
SURVEY LINE	—•••••
CULVERT	—•••••
POWER POLE	•
TELEPHONE POLE	○
LES	○
CONTROL OF ACCESS	—•••••
PROPERTY LINE	—•••••
R.O.W. TAKING LINE	—•••••
SLOPE RIGHTS	—•••••
TOP OF CUT	—•••••
TOE OF SLOPE	—•••••

DATUM  
 VERTICAL ASSUMED  
 HORIZONTAL N/A



These plans are subject to such engineering changes as may be required by the Federal Highway Administration or the Director of Engineering and Construction. Construction is to be carried on in accordance with these plans and the Standard Specifications for Highway and Bridge Construction dated March, 1975, as approved by the Federal Highway Administration on October 27, 1975 for use on this project, including all subsequent revisions and such revised specifications and special provisions as are incorporated in these plans.

APPROVED: *[Signature]*  
 CHIEF, PROPERTY ADMINISTRATION  
 DATE: 10-20-81

Pin # 78F169

SUBMITTED BY ORDER OF THE STATE TRANSPORTATION BOARD  
 DATE: OCT 20 1981

APPROVED: *[Signature]*  
 DEPARTMENT OF TRANSPORTATION  
 FEDERAL HIGHWAY ADMINISTRATION

APPROVED: *[Signature]*  
 DIVISION ADMINISTRATOR

PROJECT BRS # 0298(2)  
 SHEET 1 OF 5 SHEETS  
 DATE 10/20/81

PLAN  
 NOTE BOOK  
 DRAWING CENTER  
 NO. OF SHEETS  
 SHEET NO.

PROFILE  
 NOTE BOOK  
 DRAWING CENTER  
 NO. OF SHEETS  
 SHEET NO.

