

Vt. Rte #30

INDEX OF SHEETS



# STATE OF VERMONT AGENCY OF TRANSPORTATION



## PROPOSED IMPROVEMENT

### TOWN OF JAMAICA


P.O.# 78F173

### COUNTY OF WINDHAM

### VT. RTE. 30 (F.A.P.)

BEGINNING ON VT. ROUTE 30 AT A POINT APPROXIMATELY 1.97 MILES WEST OF THE TOWNSHEND - JAMAICA TOWN LINE AND EXTENDING NORTHWESTERLY 0.369 MILES. LENGTH OF ROW PROJECT 2547.25 FT. = 0.482 MILES  
LENGTH OF ROADWAY 1788.06 FT. = 0.329 MILES  
LENGTH OF BRIDGE 209.78 FT. = 0.040 MILES  
LENGTH OF PROJECT 1947.84 FT. = 0.369 MILES

WORK TO BE PERFORMED UNDER THIS PROJECT INCLUDES REPLACING EXISTING BRIDGE NO. 29 OVER WEST RIVER WITH A NEW STRUCTURE AND IMPROVING APPROACH ALIGNMENT.

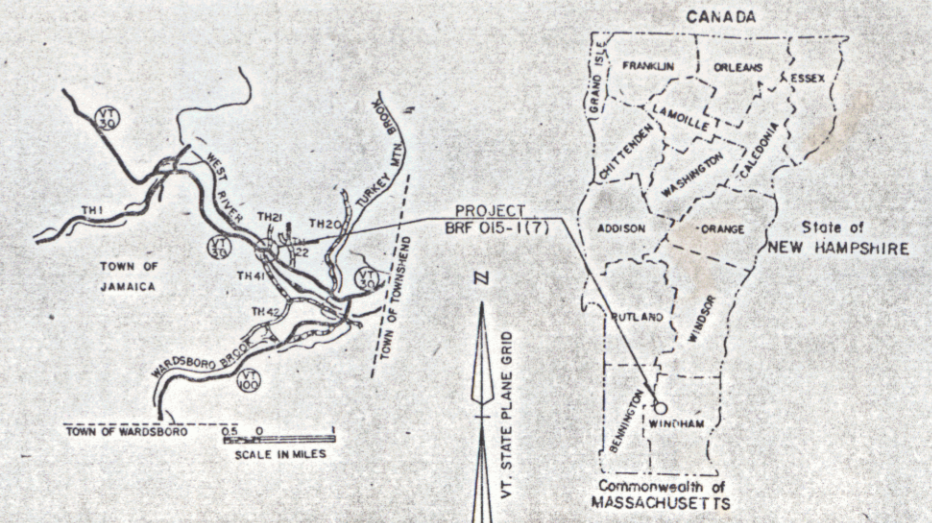

BEGIN ROW PROJECT  
BRF 015-1(7) STA. 86+00 C

### ROW PLANS

BEGIN MAINT. AGREE. AREA NO. 2  
REV. STA. 102+57 12' LT. (LENGTH 31')

END ROW PROJECT  
BRF 015-1(7) STA. 111+50 C

CONVENTIONAL SIGNS

COUNTY LINE	---
TOWN LINE	---
LIMITS OF ACCESS	---
POINT OF ACCESS	X
FENCE LINE	---
STONE WALL	---
TRAVELLED WAY	---
GUARD RAIL	---
RAILROAD	---
SURVEY LINE	---
CULVERT	---
POWER POLE	○
TELEPHONE POLE	○
TREES	✱
CONTROL OF ACCESS	---
PROPERTY LINE	---
ROW TAKING LINE	---
SLOPE RIGHTS	○ S.R. △
TOP OF CUT	△
TOE OF SLOPE	○

DATUM


VERTICAL	NGVD 1929
HORIZONTAL	N/A

BEGIN RELINQUISHMENT NO. I  
REV. STA. 99+35 103' RT.

END MAINT. AGREE. AREA NO. I  
REV. STA. 100+00 115' RT. (LENGTH 105')

END MAINT. AGREE. AREA NO. 2  
REV. STA. 102+57 43' LT.

END RELINQUISHMENT NO. I  
REV. 100+34 208' RT. (LENGTH 147')

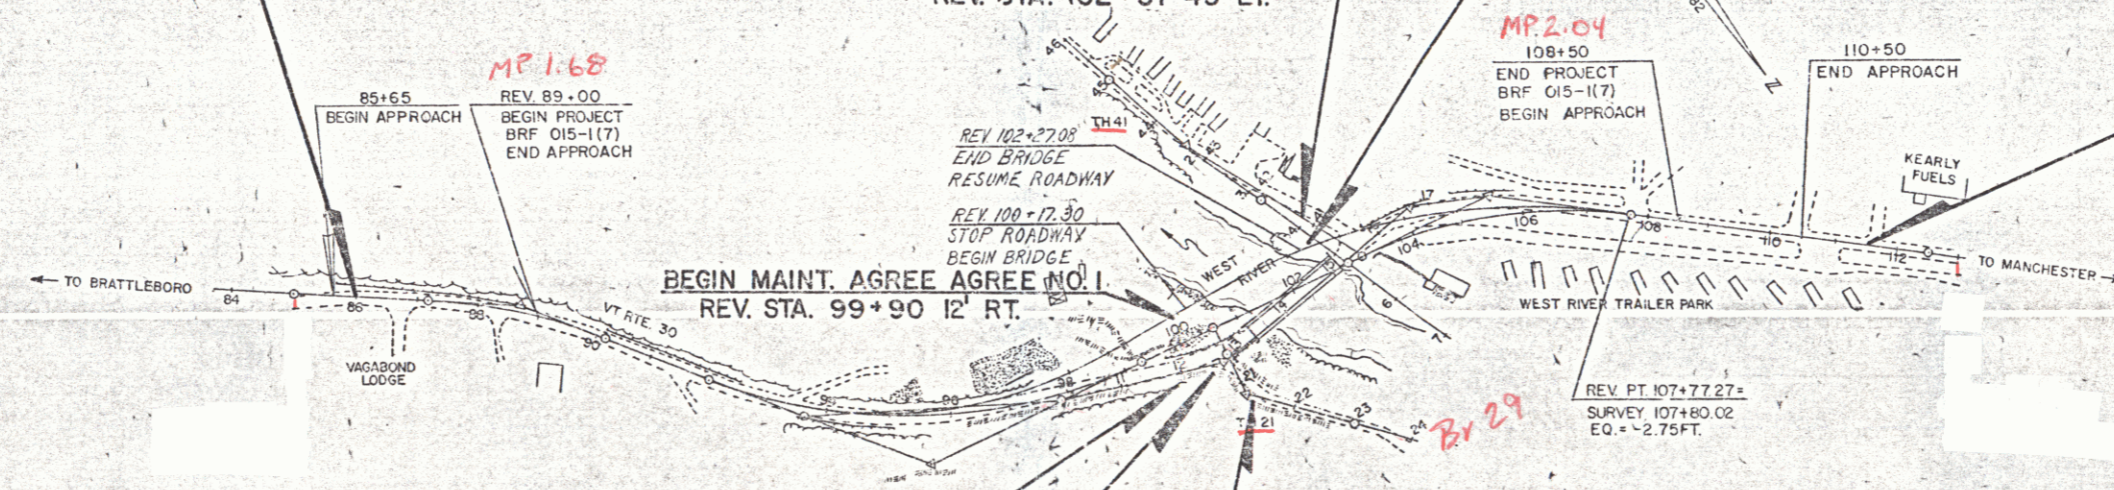

ALL DRIVES AS INDICATED ON PLANS ARE SUBJECT TO PERMITS PURSUANT TO TITLE 19, SECTION 43, V.S.A.

These plans are subject to such engineering changes as may be required by the Federal Highway Administration or the DIRECTOR OF ENGINEERING  
Construction is to be carried on in accordance with these plans and the Standard Specifications for Highway and Bridge Construction dated March, 1976, as approved by the Federal Highway Administration on October 27, 1976 for use on this project, including all subsequent revisions and such revised specifications and special provisions as are incorporated in these plans.

SUBMITTED BY ORDER OF THE STATE TRANSPORTATION BOARD

APPROVED: *[Signature]* DATE: 6/16/76  
DIRECTOR OF ENGINEERING AND CONSTRUCTION

APPROVED: *[Signature]* DATE: 7/1/76  
ACTING CHIEF, PROPERTY ADMINISTRATION

JAMAICA  
BRF 015-1(7)  
SHEET 1 OF 11 SHEETS