



WINDY GARDEN BRIDGE
 ON 11/10/17
 Sta 3+75 to Sta 4+00 Length 24 FT
 Sta 3+33 to Sta 4+00 Length 24 FT

FILE NO.	SHEET NO.	TOTAL SHEETS
FR 25	2	3

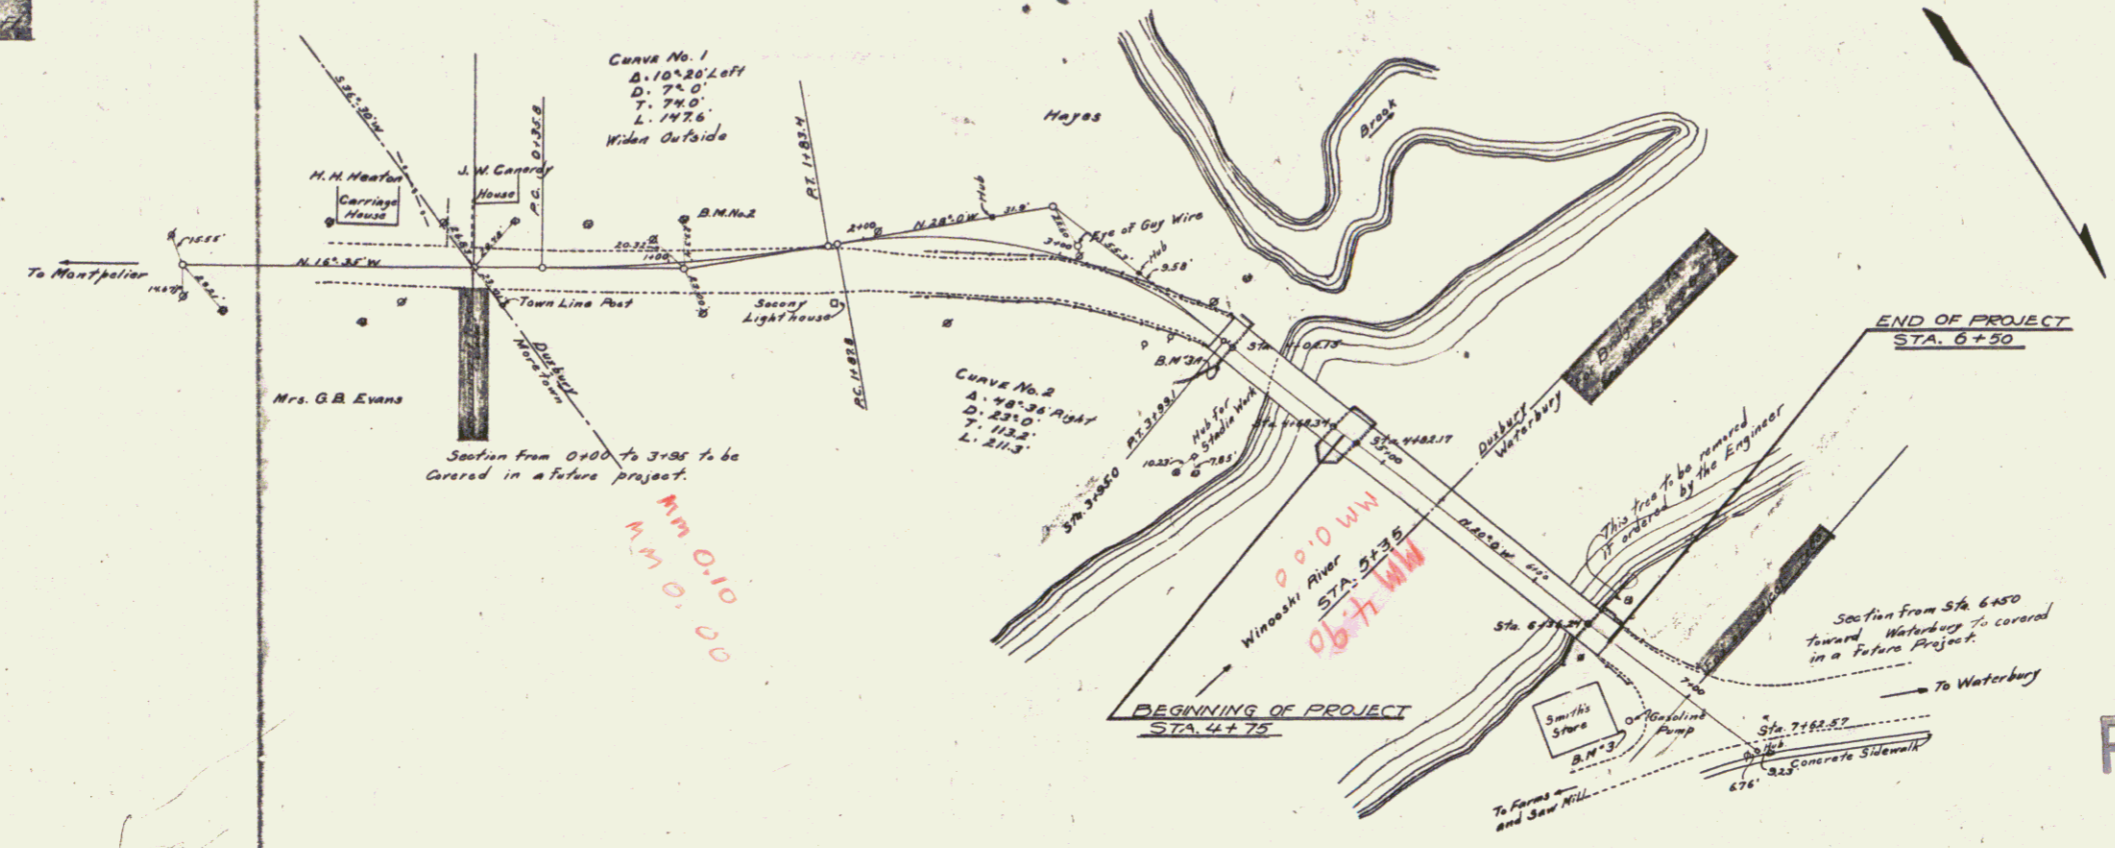

THIS CONTRACT IS TO INCLUDE THE FOLLOWING:
 REPLACING FLOOR OF LONG SPAN
 BACKWALL OF NORTH ABUTMENT
POOR ORIGINAL COPY

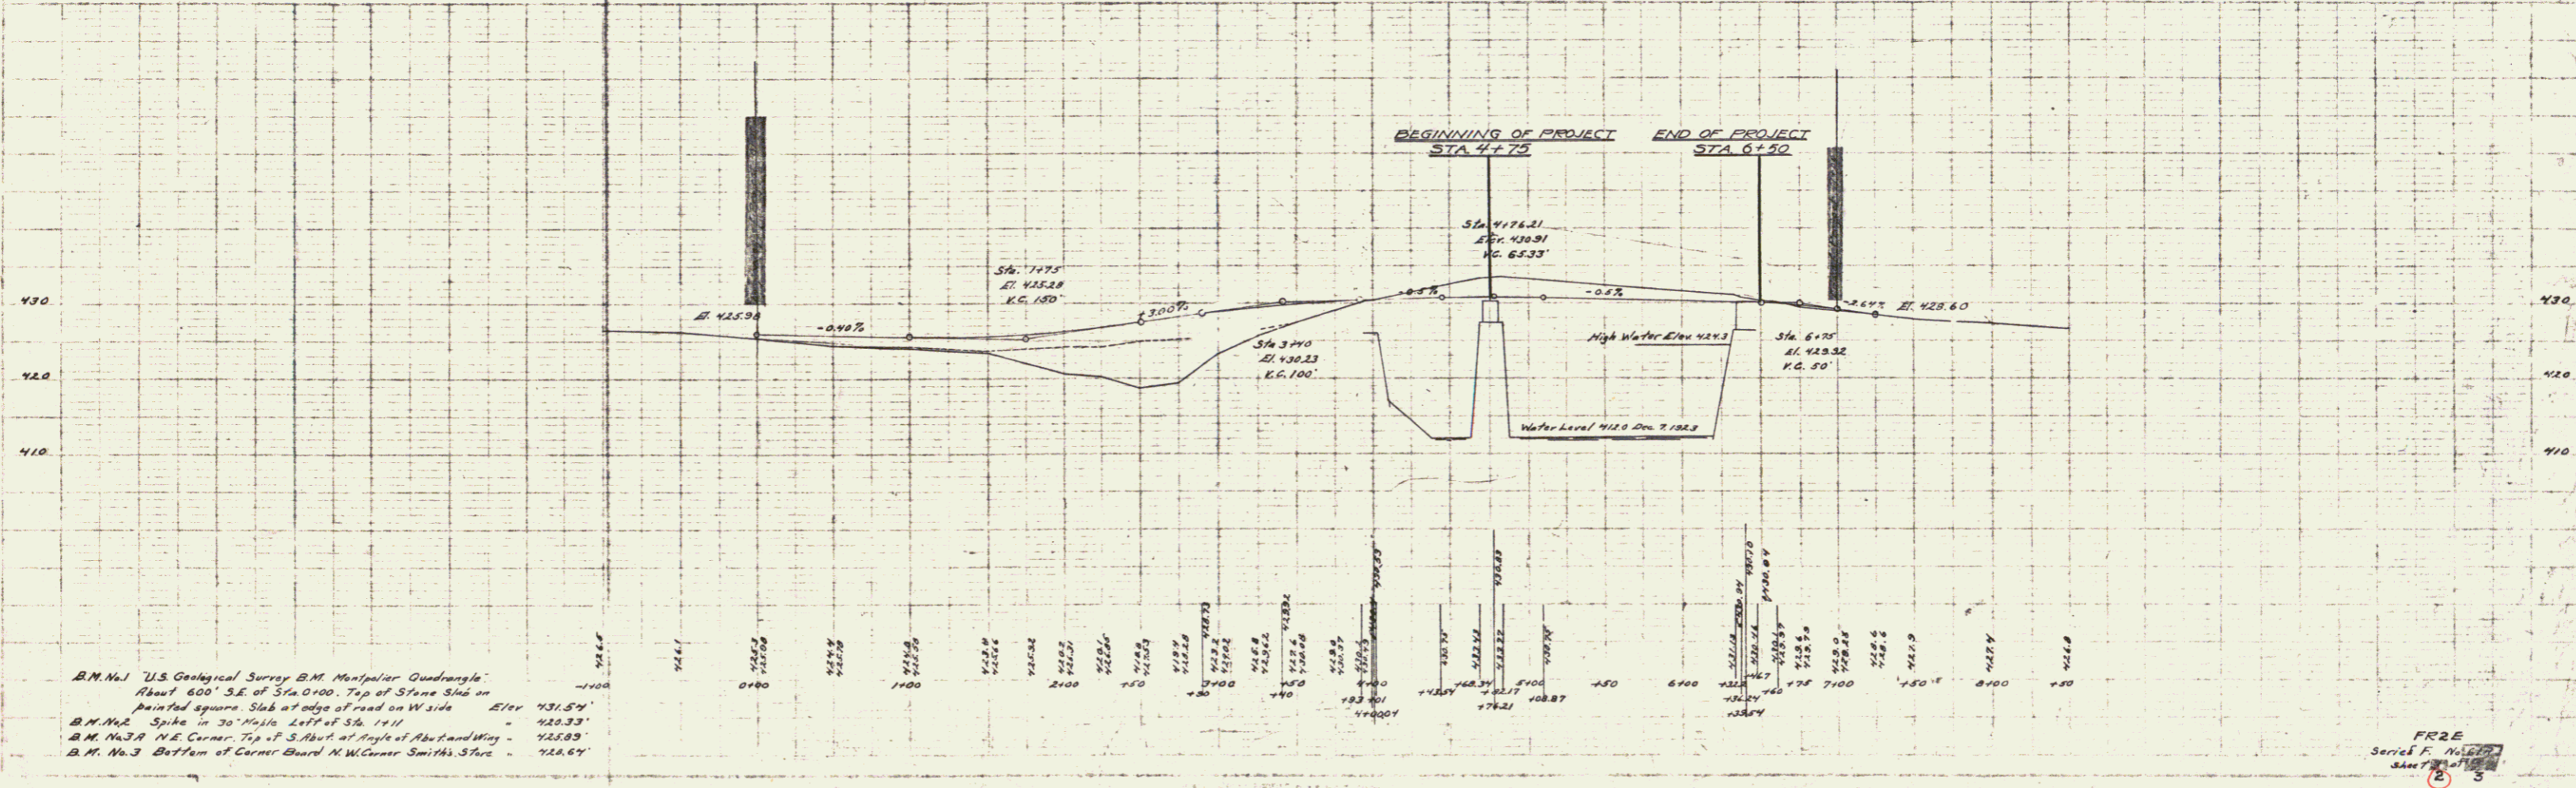

FR 25 Series F. No. 15