


TYPICAL SECTIONS

STA. 416+50-STA. 426+00

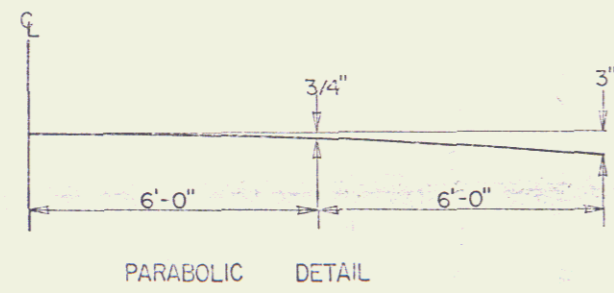

3" BITUMINOUS CONCRETE PAVEMENT, ITEM 406.25 (TWO COURSES-1-1/4" III OVER 1-3/4" II)
 5" PLANT MIXED BASE COURSE, ITEM 303.25 (TWO COURSES)
 24" SUB-BASE OF GRAVEL, ITEM 301.15

SHOULDERS: 1-1/4" BITUMINOUS CONCRETE PAVEMENT, ITEM 406.25



0'-12" GRANULAR BORROW, ITEM 203.32 (IN FILL.)
 0'-24" SAND BORROW, ITEM 203.31 (IN CUT) } AS INDICATED ON THE PLANS OR AS DIRECTED BY THE ENGINEER.

GENERAL NOTES

RURAL SEED FORMULA				
% WGT	LBS/A	NAME	PUR %	GERM %
3.33	2	CROWN VETCH	97	75
50.00	30	CREeping RED FESCUE	98	85
8.33	5	TIMOTHY	99	85
16.67	10	PERENNIAL RYE GRASS (VAR. PENNFINNE)	95	85
8.34	5	ALFALFA (VAR. SARANAC)	99	85
8.33	5	BIRDSFOOT TREFOIL (VAR. EMPIRE)	98	85
5.00	3	HIGHLAND BENT GRASS	92	85
100.00	60			

URBAN SEED FORMULA				
% WGT	LBS/A	NAME	PUR %	GERM %
37.50	30	CREeping RED FESCUE (VAR. PENNLANW)	98	85
31.25	25	KENTUCKY BLUEGRASS (COMMON)	85	75
31.25	25	PERENNIAL RYE GRASS (VAR. PENNFINNE)	95	80
100.00	80			

SEED, ITEM 651.10, MIXTURE SHALL NOT HAVE A WEED CONTENT EXCEEDING 0.40% BY WEIGHT AND SHALL BE FREE OF ALL NOXIOUS WEED SEED.
 FERTILIZER, ITEM 651.15, FORMULA 10-20-10 TO BE USED WITH SEED AT THE RATE OF 500 LBS/ACRE.
 AGRICULTURAL LIMESTONE, ITEM 651.20, TO BE APPLIED AT THE RATE OF 2 TONS OR AS DIRECTED BY THE ENGINEER.
 HAY MULCH, ITEM 651.25, TO BE PLACED ON EARTH SLOPES AT THE RATE OF 2 TONS/ACRE.
 TOPSOIL, ITEM 653.10, TO BE PLACED AS SHOWN ON THE PLANS OR AS DIRECTED BY THE ENGINEER.
 MARKER POSTS (WOOD OR STEEL /3 SPECIFIED) TO BE PLACED AS DIRECTED BY THE ENGINEER.
 SEE STANDARD SHEET B-5 FOR TYPICAL SLOPE ROUNDING.
 SEE STANDARD SHEET D-2 FOR PAY LIMITS OF SAND BORROW WHEN USED IN CONJUNCTION WITH UNDERDRAIN.
 ALLOWABLE THICKNESS TOLERANCES
 SUB-BASE ± 1"
 CONTROLLED MATERIAL ± 1"
 PAVEMENT ± 1/4"
 BASE COURSE ± 1/2"

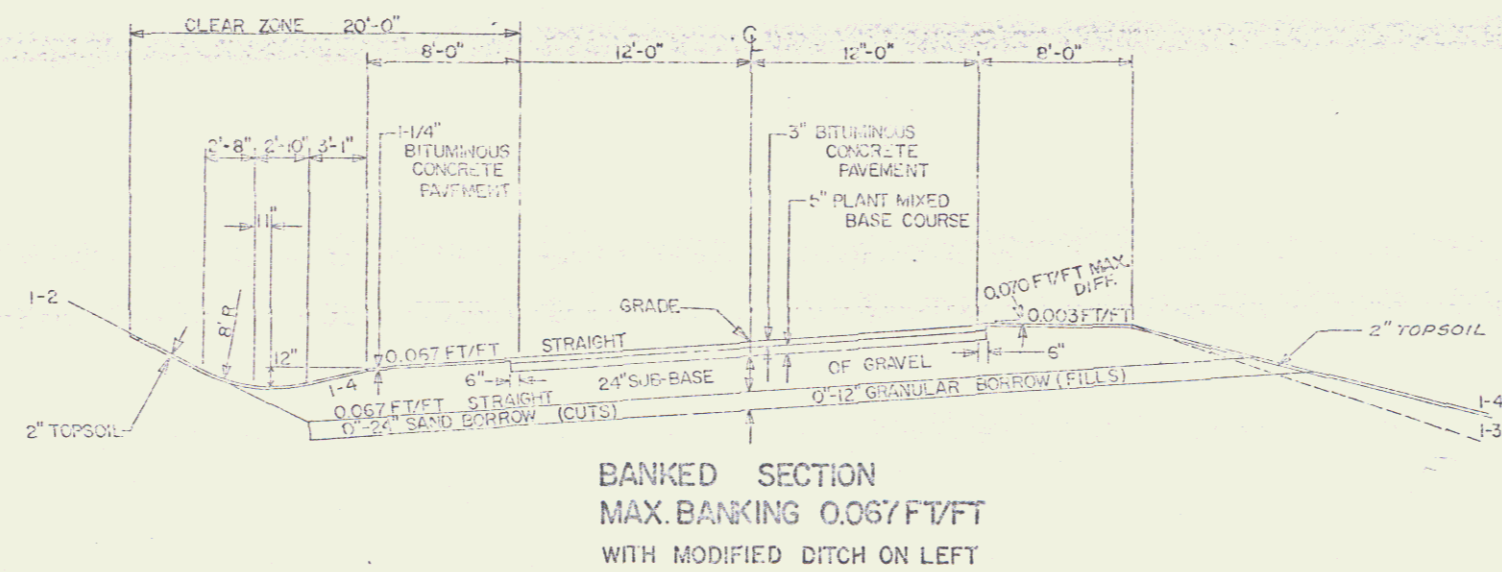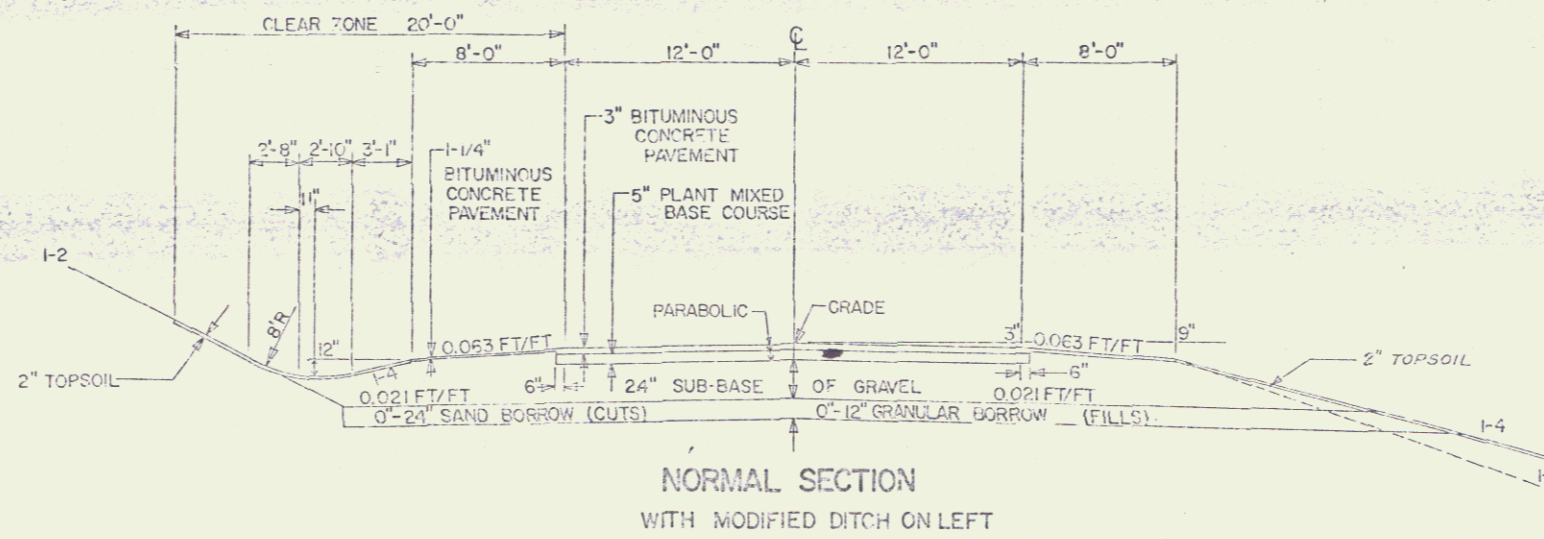

WESTMINSTER-ROOKINGHAM DRS 0113(15)

DRAWN BY RJT DATE 12-83

SHEET 2 OF 27