


- SPECIAL DITCH / STONE FILL, TYPE I
 TRK #1 21+50 RT ~ 23+02 RT.
 TRK #1 21+40 LT ~ TRK #2 23+72 LT.
- SPECIAL DITCH TO BE PAID FOR UNDER ITEM 203.10
 TRK #3 59+25 LT ~ 60+50 LT.
- GUARD RAIL, STANDARD STEEL BEAM, W/ WOOD POSTS, TYPE II
 TRK #1 24+05 RT ~ 25+67 RT.
- CONSTRUCT DRIVE
 TRK #1 26+11 LT ~ 26+50 LT.
 TRK #3 58+90 LT (40' wide)
 TRK #1 25+18 LT (16' wide)
 TRK #1 25+65 LT.
 TRK #1 24+04 LT (12' wide).
- FRONT MATCHING
 TRK #3 59+25 LT ~ 60+50 LT.
- WHITE CEDAR (B/B) (6" x 8")
 TRK #1 21+35 LT ~ 20+70 LT.
 3 EA.
- CHAIN-LINK FENCE, 6 FEET
 TRK #1 21+35 LT ~ 21+81 LT.

TRK 3 CURVE DATA

Δ	80°04'00" LT
D	51'06'25"
R	112.00'
T	110.14'
L	174.10'
E	45.04'
BM	O.O. FWT

DATUM

VERTICAL	NVD 1929
HORIZONTAL	N.A.

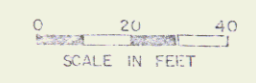

SURVEYED BY: FALL DATE: 8-82
 DRAWN BY: DATE: 11-82
 CHECKED BY: DATE: 11-82
 WESTMIN SVER-ROCKINGHAM
 PROJ. ENG. NO. 012151
 SHEET 17 OF 27