

DEMOLITION & DISPOSAL OF BUILDINGS

② TRK #1 22+00
 ③ TRK #1 22+80

SPECIAL DITCH w/ STONE FILL, TYPE I

TRK #1 21+50 RT. ~ 23+02 RT.
 TRK #1 21+40 LT. ~ TRK #2 23+72 LT.

SPECIAL DITCH TO BE PAID FOR UNDER ITEM 203.12

TRK #3 54+25 LT. ~ 60+50 LT.

GLARD PAIL, STANDARD STEEL BEAM w/ WOOD POSTS, TYPE II

TRK #1 24+05 RT. ~ 25+07 RT.

CONSTRUCT DRIVE

TRK #1 26+11 LT. ~ 26+50 LT.
 TRK #3 58+90 LT. (40' wide)
 TRK #1 25+18 LT. (16' wide)
 TRK #1 25+65 LT.
 TRK #1 24+04 LT. (16' wide)


Erosion Matting

TRK #3 51+25 LT. ~ 60+30 LT.

WHITE CEDAR (4x8 @ 6\"/>

NOTE:
 CHAIR - THE CONTRACTOR SHALL BE RESPONSIBLE FOR OBTAINING ALL NECESSARY PERMITS AND RIGHTS OF WAY FROM THE APPROPRIATE AGENCIES AND FOR OBTAINING ALL NECESSARY MATERIALS AND QUANTITIES PRIOR TO ORDERING.

ADDITIONAL GENERAL NOTE
 LOCATION OF EXISTING AND NEW WATER MAINS AND APPURTENANCES PROVIDED BY D.C.R.B., INC., P.O. BOX 514, LEBANON, NEW HAMPSHIRE 03768 - JUNE, 1985

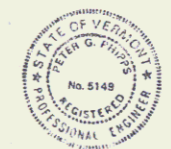

DATE: 11-82
 DRAWN BY: [Signature]
 CHECKED BY: [Signature]
 PROJECT: WESTMINSTER-ROCKINGHAM
 SHEET 59 OF 72

- INTERCONNECTION**
- 8" GATE VALVE, MJ W/BOX
 - 8" PIPE, 3' ± LONG
 - 8" X 6" TEE, MJ
 - 8" PIPE, 3' ± LONG
 - 8" X 6" TEE, MJ
 - 8" PIPE, 3' ± LONG
 - 8" GATE VALVE, MJ W/BOX
 - 8" PIPE, 3' ± LONG
 - 8" X 12" REDUCER, MJ
 - 12" SOLID SLEEVE CONNECTION TO EXISTING MAIN
- EXPLORATORY EXCAVATION REQUIRED TO VERIFY PIPE LOCATIONS AND SIZES**

HYDRANT

- 6" PIPE, 3' ± LONG
- 6" GATE VALVE, MJ W/BOX
- 6" PIPE, AS NEEDED

TRK 3 CURVE DATA

Δ 80°04'00" LT
 D 31+09.25'
 P 112.00'
 T 110.14'
 L 174.10'
 E 45.08'
 DIR 0.0' ± T/FT

TRK 2 CURVE DATA

Δ 152°-13'-00" LT
 D 114'-35'-30"
 P 30.00'
 T 202.77'
 L 132.83'
 E 158.22'

TRK 1 CURVE 2 DATA

Δ 61°57' 00" LT
 D 85+11' 50"
 P 150.00'
 T 88.66'
 L 160.44'
 E 24.34'

DATE: 11-82
 DRAWN BY: [Signature]
 CHECKED BY: [Signature]

SCALE IN FEET
 0 20 40