

INDEX OF SHEETS

1. GENERAL NOTES
2. PLAN SHEETS
3. PROFILE SHEETS
4. SPECIAL NOTES
5. SPECIAL NOTES
STATE OF VERMONT  
AGENCY OF TRANSPORTATION



PROPOSED IMPROVEMENT  
**TOWNS OF WILLISTON-ESSEX**  
COUNTY OF CHITTENDEN


**VT. RTE. 2-A**

BEGINNING AT A POINT ON VT. RTE. 2-A IN THE TOWN OF WILLISTON  
0.190 MILES SOUTH OF THE WILLISTON-ESSEX TOWN LINE AND  
EXTENDS NORTHERLY 0.360 MILES.

LENGTH OF ROADWAY 1,276 FT. = 0.241 MILES  
LENGTH OF BRIDGE 220 FT. = 0.041 MILES  
LENGTH OF PROJECT 1,496 FT. = 0.282 MILES

PROJECT CONSISTS OF REPLACING DEFICIENT BRIDGE AND CONSTRUCTING  
NECESSARY ROADWAY APPROACHES.

LENGTH OF ROW PROJ. 2,202 FT. = 0.417 MILES

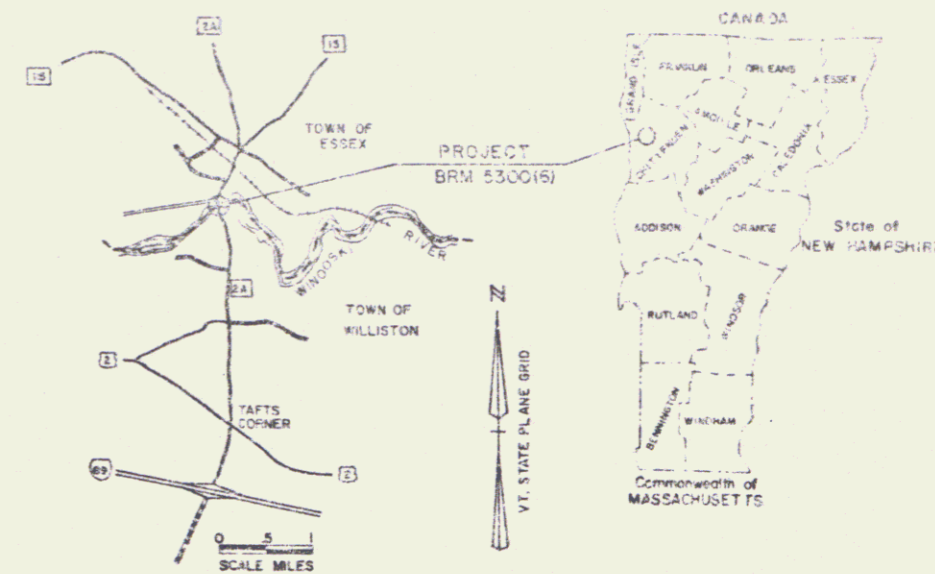

R.O.W. PLANS


BEGIN R.O.W. PROJECT

M-EGC-BRM 5300(6) STA. 301+14

CONVENTIONAL SIGNS

COUNTY LINE	---
TOWN LINE	---
LIMITS OF ACCESS	---
POINT OF ACCESS	X
FENCE LINE	---
STONE WALL	---
TRAVELED RD.	---
GUARD RAIL	---
RAILROAD	---
SURVEY LINE	---
CULVERT	---
POWER POLE	---
TELEPHONE POLE	---
TREES	---
CONTROL OF ACCESS	---
PROPERTY LINE	---
R.O.W. TAKING LINE	---
SLOPE RIGHTS	---
TOP OF CUT	---
TOE OF SLOPE	---

DATUM  
VERTICAL: NGVD 1929  
HORIZONTAL: N/A

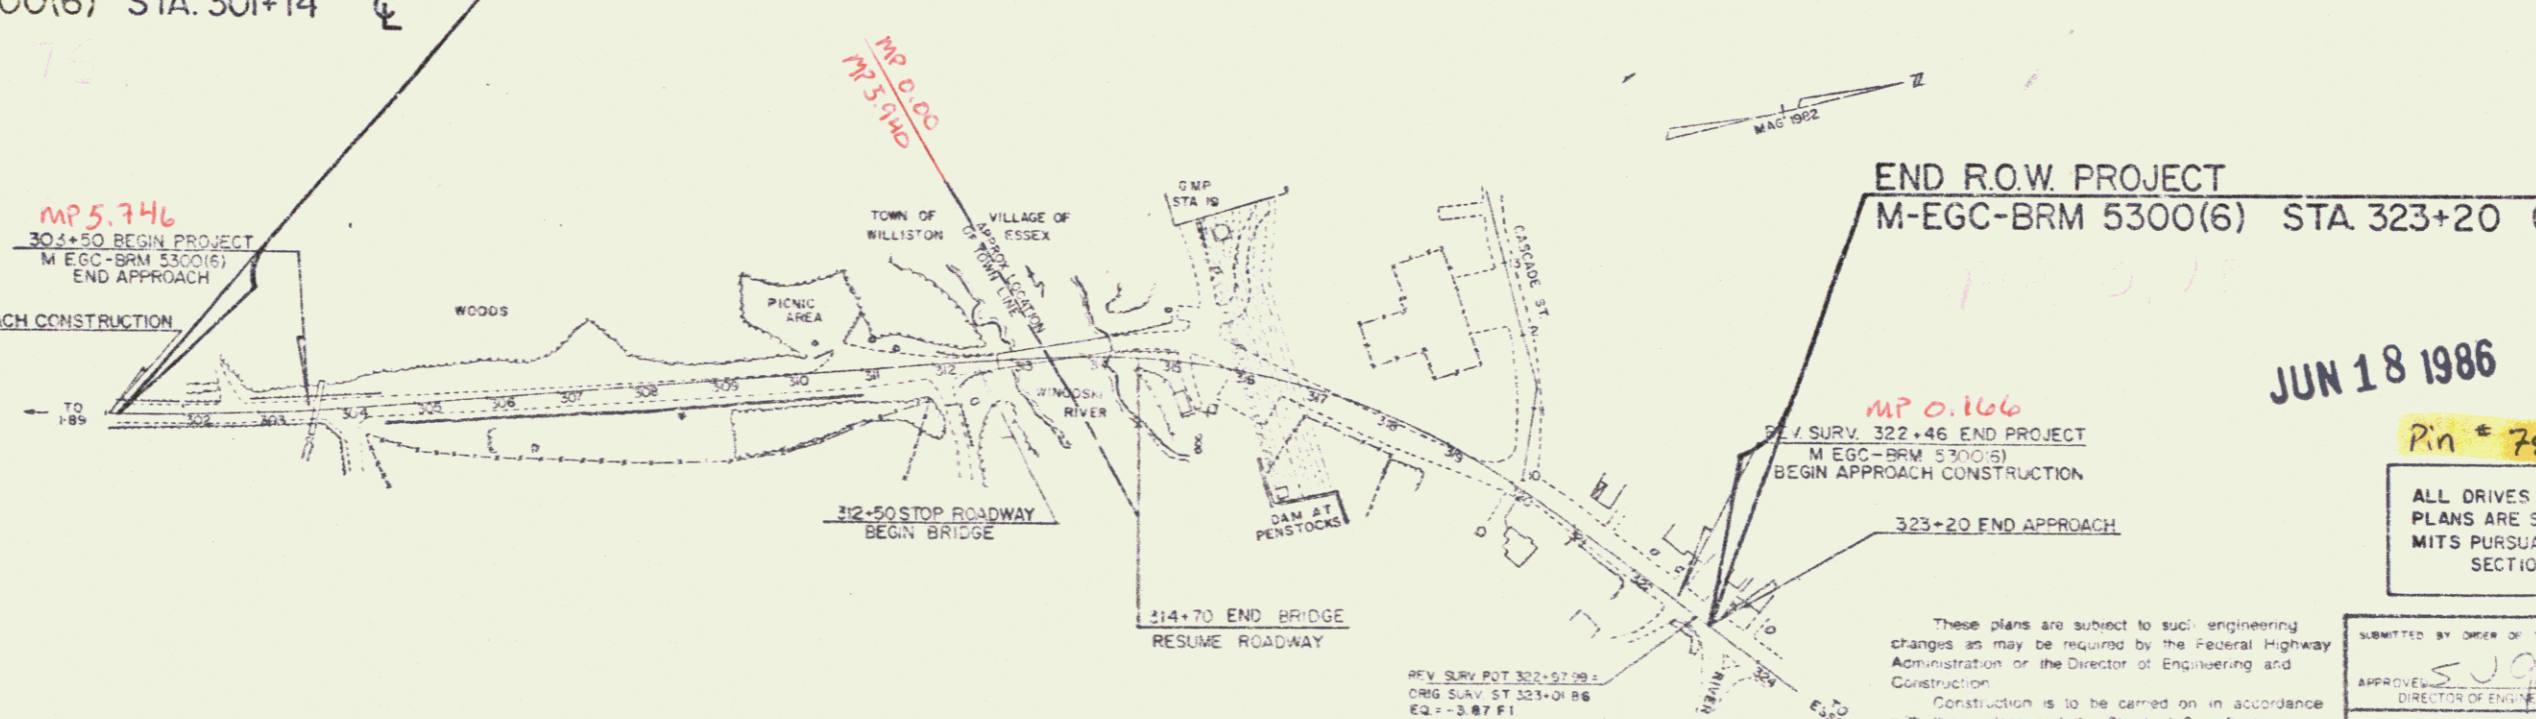

END R.O.W. PROJECT

M-EGC-BRM 5300(6) STA. 323+20

JUN 18 1986

Pin # 78F181

ALL DRIVES AS INDICATED ON  
PLANS ARE SUBJECT TO PER-  
MITS PURSUANT TO TITLE 19,  
SECTION 43, V.S.A.

These plans are subject to such engineering  
changes as may be required by the Federal Highway  
Administration or the Director of Engineering and  
Construction.  
Construction is to be carried on in accordance  
with these plans and the Standard Specifications  
for Highway and Bridge Construction dated  
March, 1976 as approved by the Federal Highway  
Administration on October 27, 1976 for use on  
this project, including all subsequent revisions and  
such revised specifications and special provisions as  
are incorporated in these plans.

SUBMITTED BY ORDER OF THE STATE TRANSPORTATION BOARD  
APPROVED: *S. J. [Signature]* DATE 2-17-86  
DIRECTOR OF ENGINEERING AND CONSTRUCTION

DEPARTMENT OF TRANSPORTATION  
FEDERAL HIGHWAY ADMINISTRATION

APPROVED: *[Signature]* DATE 3-27-86  
CHIEF PROPERTY ADMINISTRATION

WILLISTON-ESSEX  
M-EGC-BRM 5300 (6)  
SHEET 1 OF 13