

Research

Batched 6/9/99

Stamped 11-06-01 Apr

# STATE OF VERMONT AGENCY OF TRANSPORTATION




## PROPOSED IMPROVEMENT **TOWN OF BERLIN** COUNTY OF WASHINGTON **VT. RTE. 12 (FAS) Major Collector**

BEGINNING AT A POINT APPROXIMATELY 5.812 MILES NORTHERLY OF NORTHFIELD - BERLIN TOWN LINE AND CONTINUING NORTHERLY ALONG VT. RTE. 12 FOR A DISTANCE OF 350.00 FEET.

LENGTH OF ROADWAY 244.51 FEET= 0.046 MILES  
LENGTH OF BRIDGE 105.49 FEET= 0.020 MILES  
LENGTH OF PROJECT 350 FEET= 0.066 MILES  
LENGTH OF ROW PROJECT 924 FEET 0.175 MILES


WORK TO BE PERFORMED UNDER THIS PROJECT CONSISTS OF REPLACEMENT OF AN EXISTING BRIDGE AS WELL AS RECONSTRUCTION OF THE APPROACHES.

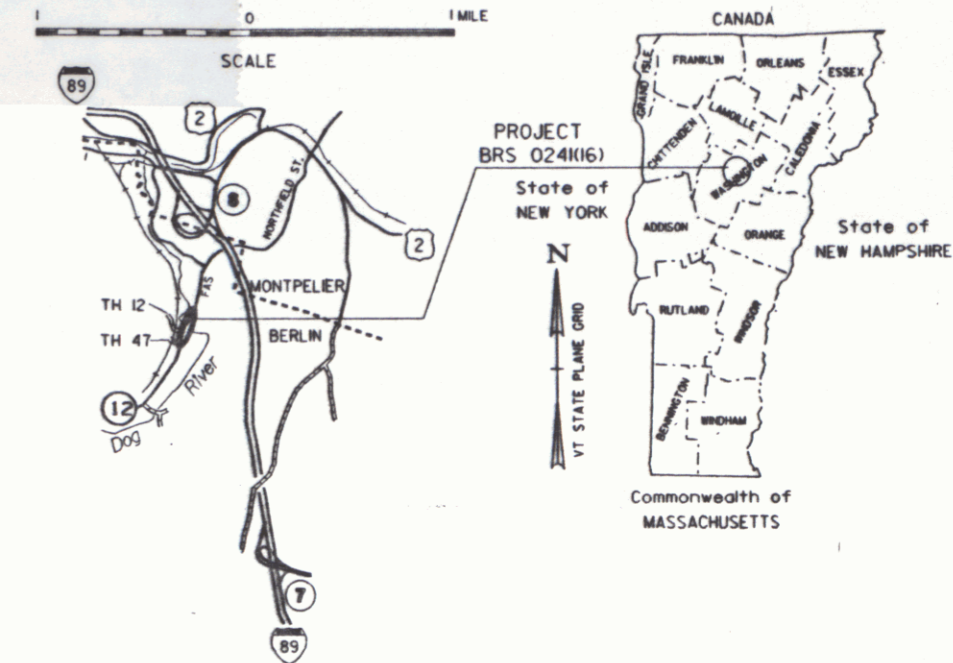

R.O.W. PLANS

**BEGIN ROW PROJECT**  
BRS 0241(16) STA. 304+06 25' RT.

**END MAINT. AGREEMENT AREA NO. 1**  
TH 12 20+42 E (LENGTH 30')

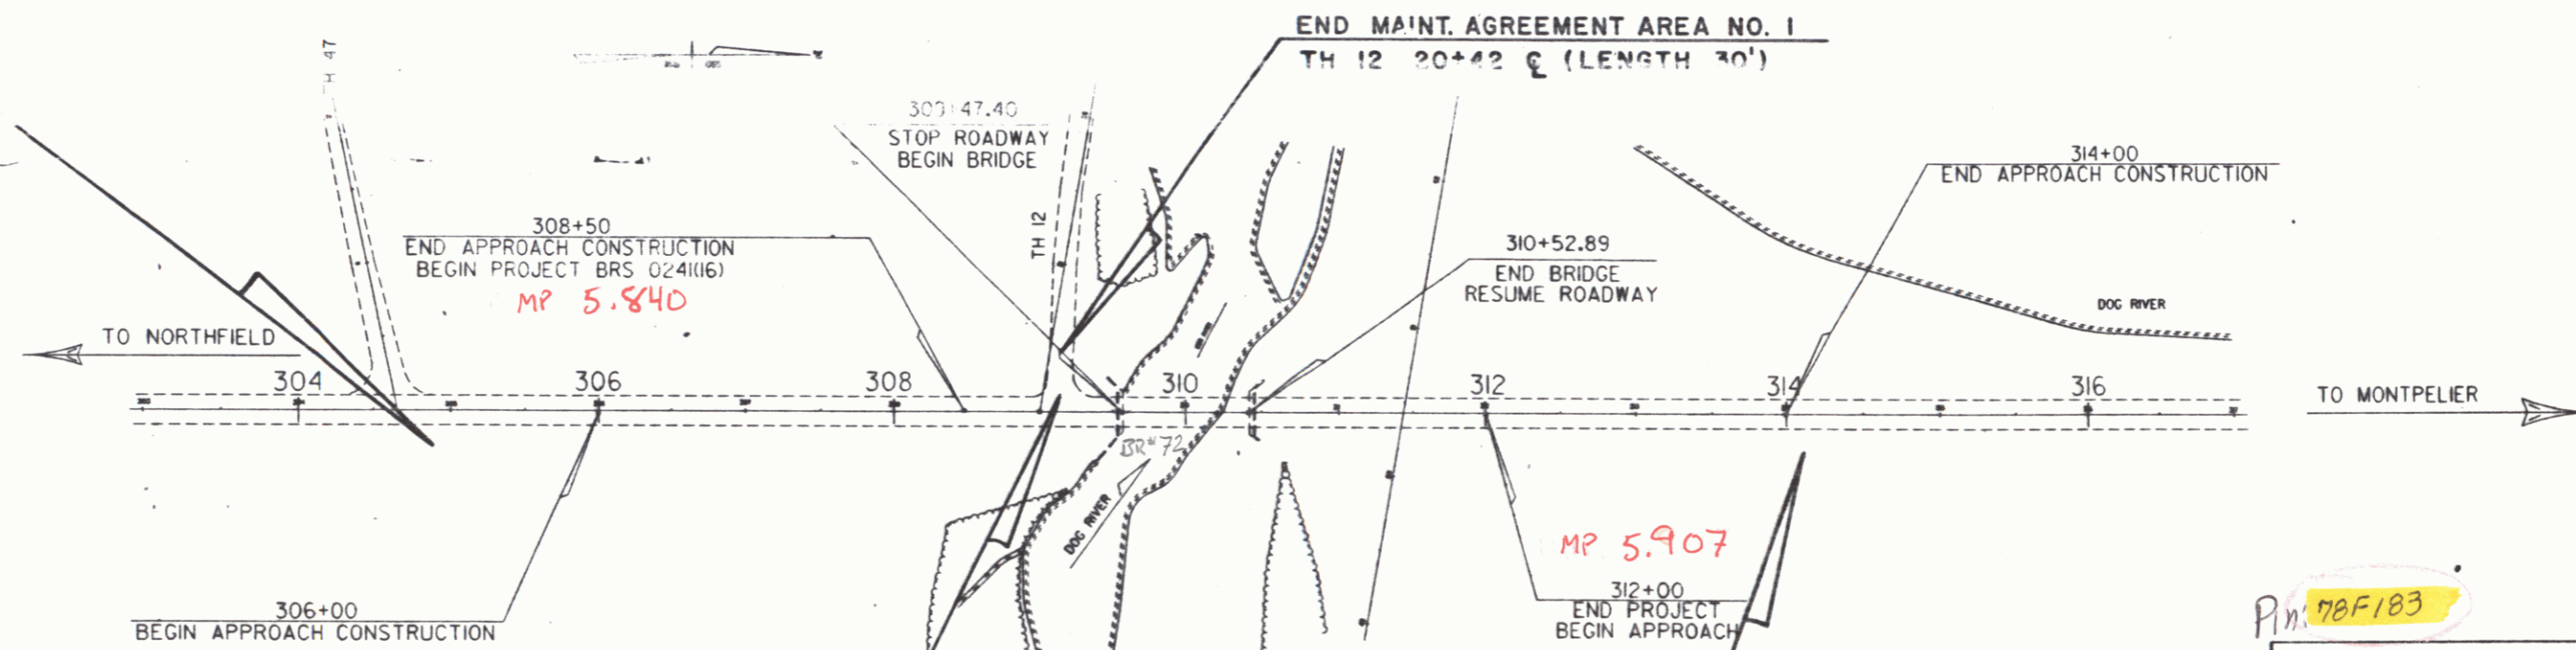

**CONVENTIONAL SIGNS**

COUNTY LINE	---
TOWN LINE	- - - -
LIMITS OF ACCESS	○ ○ ○ ○
POINT OF ACCESS	X
FENCE LINE	- x - x -
STONE WALL	o o o o o o o o
TRAVELED WAY	o o o o o o o o
RAILROAD	o o o o o o o o
SURVEY LINE	o o o o o o o o
CURVE	o o o o o o o o
POWER	⊕
TELEPHONE POLE	⊕
TREES	●
CONTROL OF ACCESS	///
PROPERTY LINE	---
R.O.W. TAKING LINE	---
SLOPE RIGHTS	SR
TOP OF CUT	△
TOE OF SLOPE	○

**DATUM**

VERTICAL	NGVD 1929
HORIZONTAL	N/A

**BEGIN MAINT. AGREEMENT AREA NO. 1**  
STA. 309+17 12' LT.

**END ROW PROJECT**  
BRS 0241(16) STA. 314+10 27' RT.

THESE PLANS ARE SUBJECT TO SUCH ENGINEERING CHANGES AS MAY BE REQUIRED BY THE FEDERAL HIGHWAY ADMINISTRATION OR THE CHIEF ENGINEER. CONSTRUCTION IS TO BE CARRIED ON IN ACCORDANCE WITH THESE PLANS AND THE STANDARD SPECIFICATIONS FOR CONSTRUCTION DATED 1990, AS APPROVED BY THE FEDERAL HIGHWAY ADMINISTRATION ON MARCH 15, 1990 FOR USE ON THIS PROJECT, INCLUDING ALL SUBSEQUENT REVISIONS AND SUCH REVISED SPECIFICATIONS AND SPECIAL PROVISIONS AS ARE INCORPORATED IN THESE PLANS.

APPROVED: *Scott D. Newell* DATE: 7/27/93  
Director of Engineering

APPROVED: \_\_\_\_\_ DATE: 7/24/93  
Chief, Right of Way

**BERLIN**  
**BRS 0241(16)**  
ROW SHEET (1) OF 11 SHEETS

Research Set  
TOWN OF BERLIN

FEB 05 1998