

POOR ORIGINAL COPY

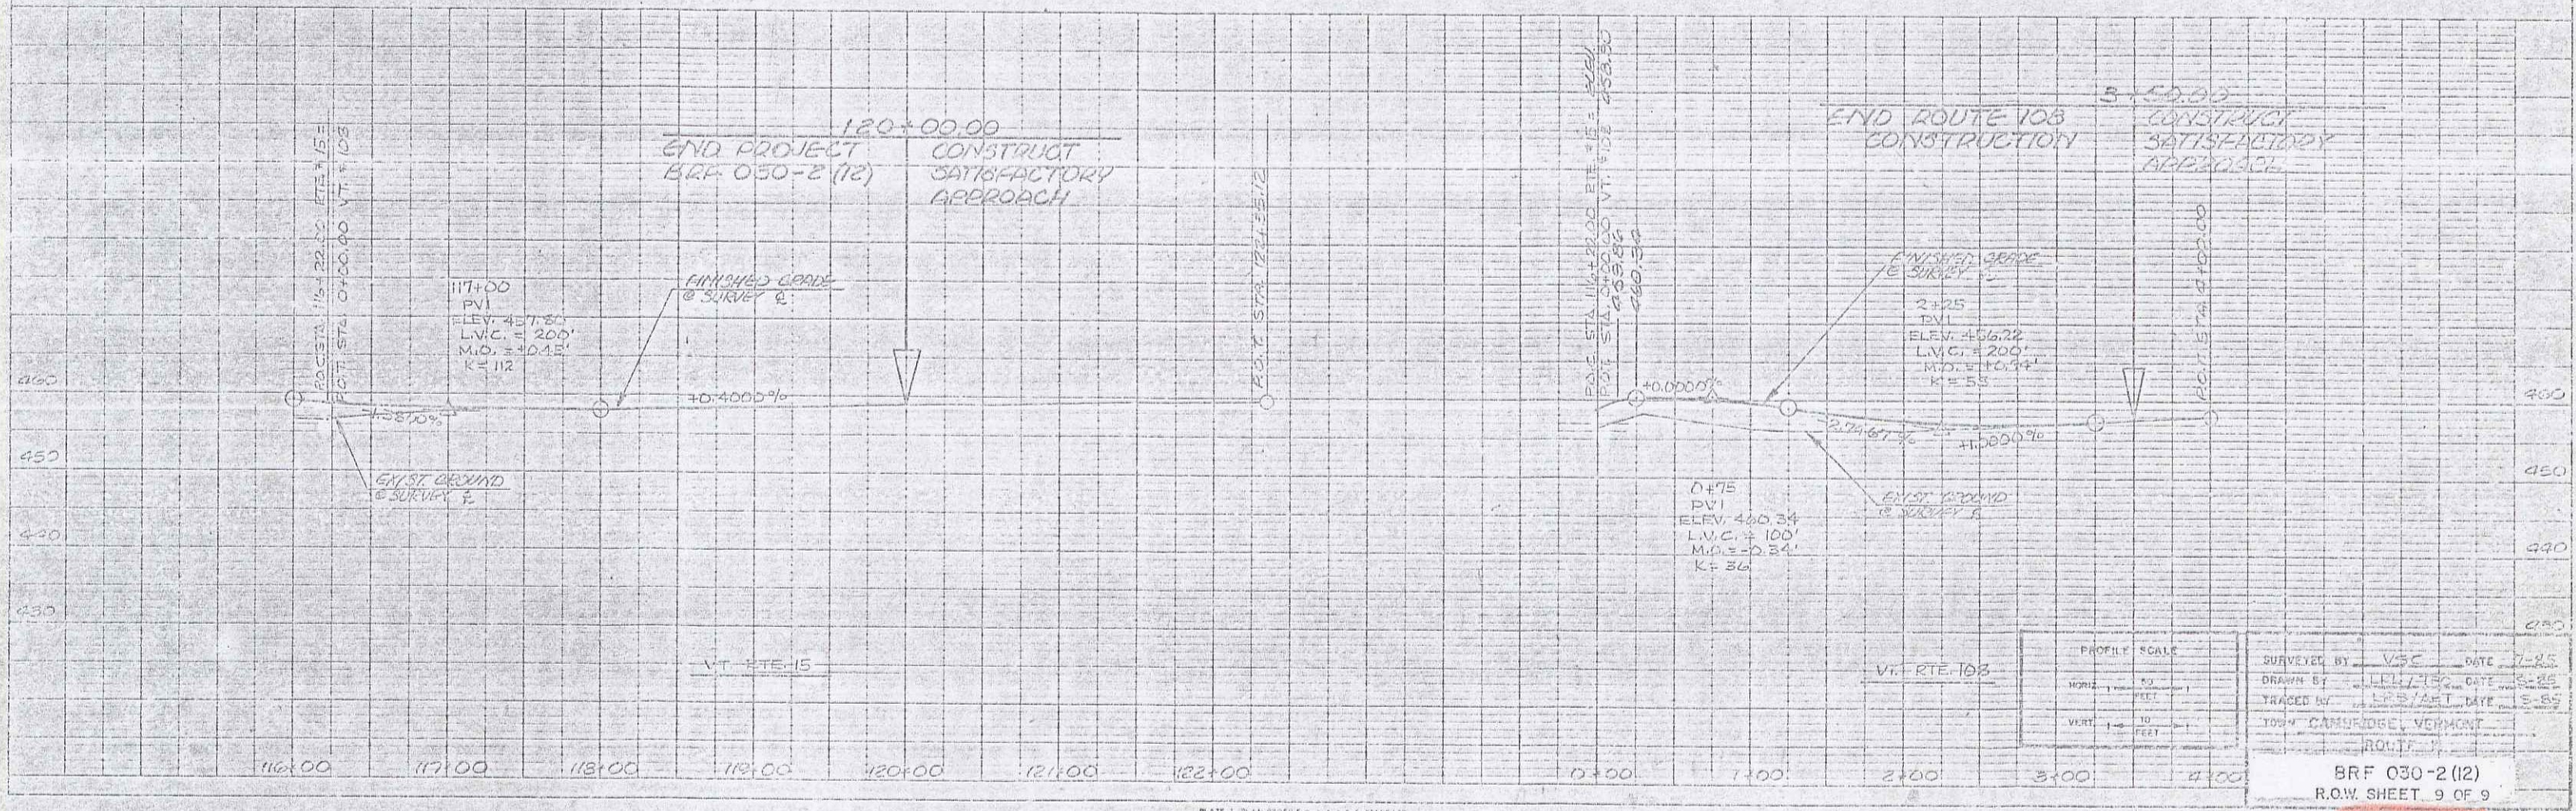
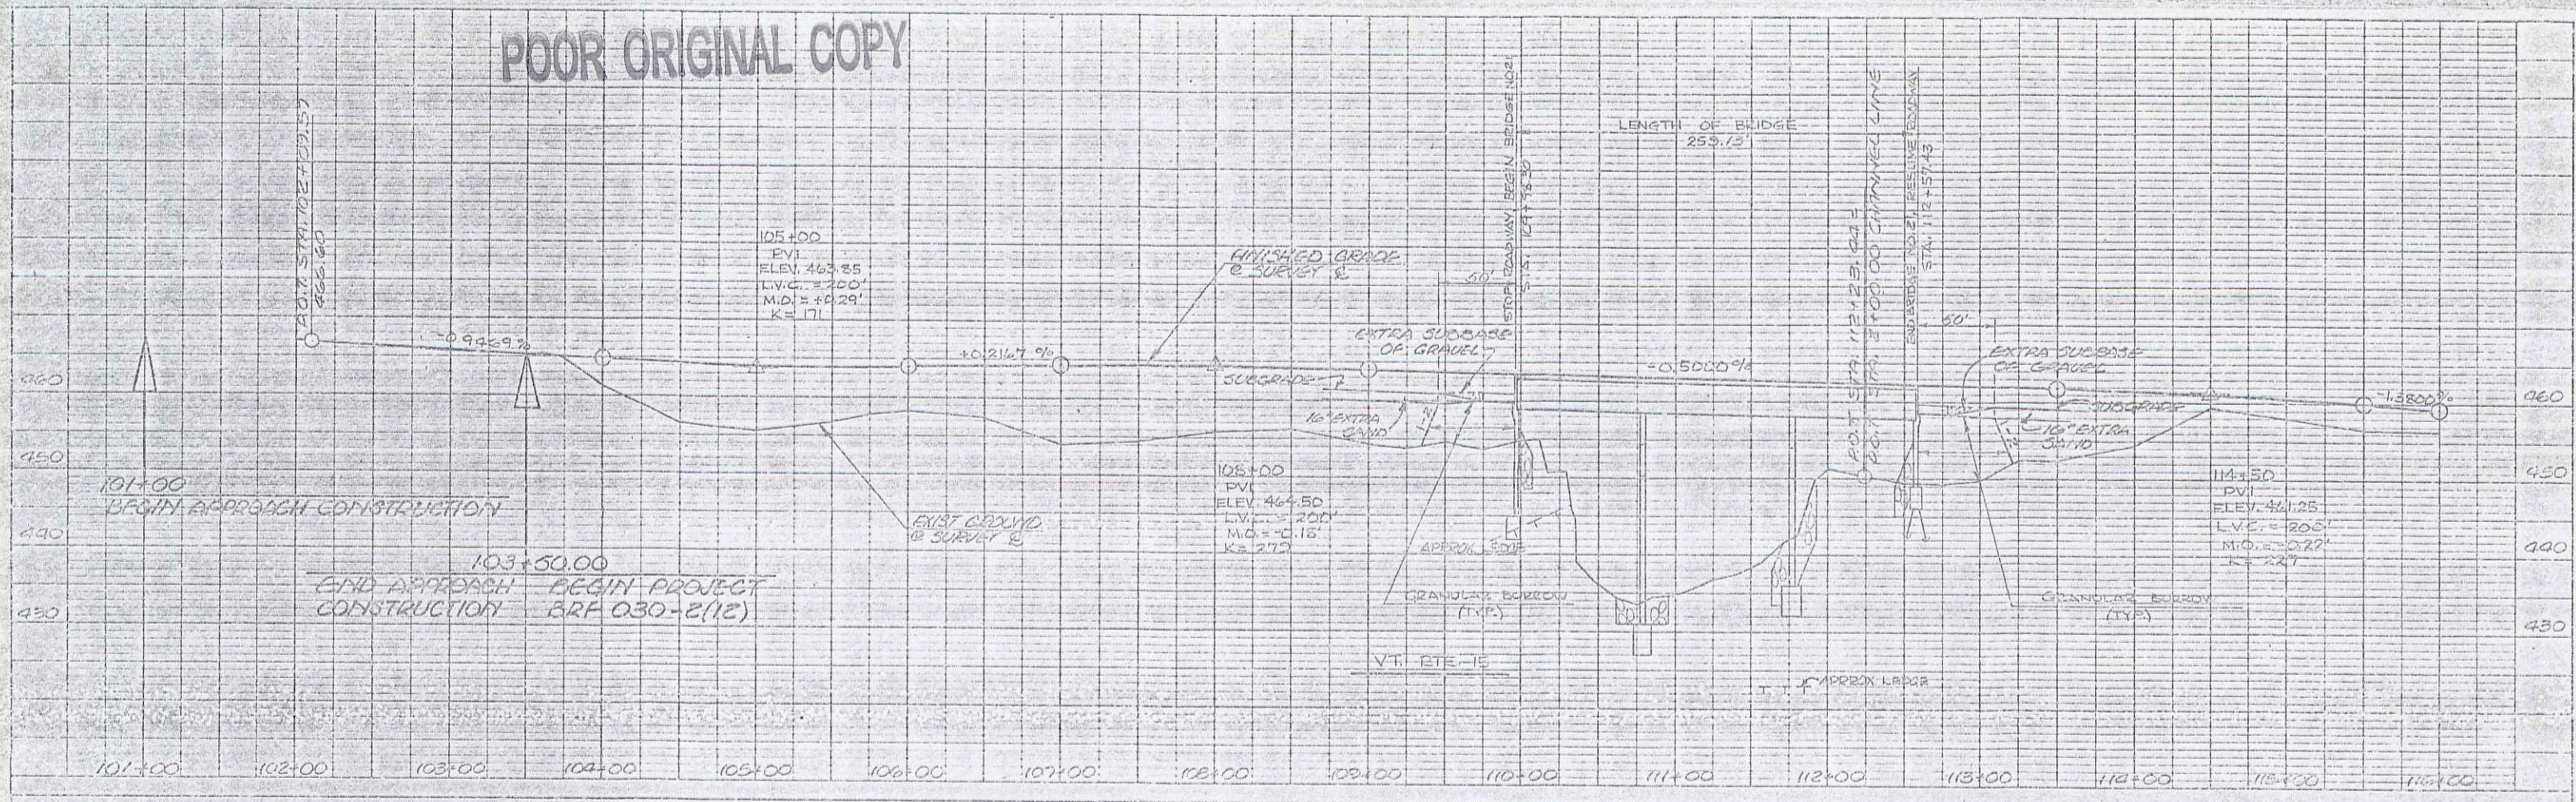


PLATE 1 - PLAN PROFILE - 4" X 1" STANDARD
BY: JENNY

JAN 06 1993 10