


SURVEY
PLAN I

SEP 16 2008

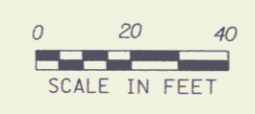

PROJECT NAME: CASTLETON	PLOT DATE: 05-JUL-2005
PROJECT NUMBER: RS 0142(10)	DRAWN BY: T. LACKEY
FILE NAME: sf193sul1	CHECKED BY:
PROJECT LEADER: R. WHITCOMB	ROW SHEET 6 OF 14
DESIGNED BY: T. LACKEY	
78f193/str/sf193sur.dgn	