


PLAN
SCALE 1" = 10'-0"

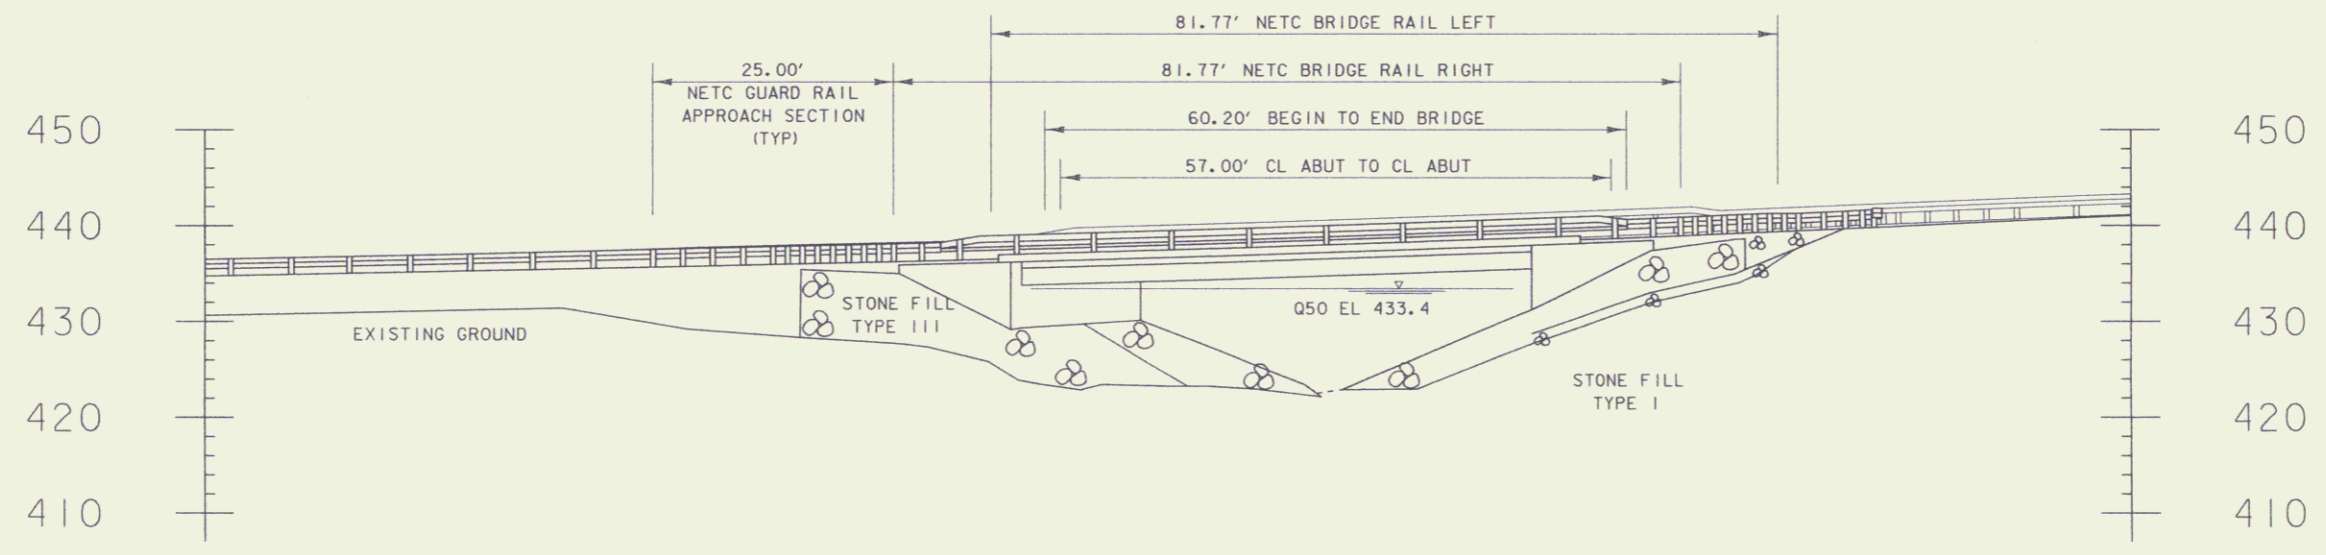

ELEVATION
SCALE 1" = 10'-0"

SEP 16 2008

PROJECT NAME: CASTLETON	PLOT DATE: 05-JUL-2005
PROJECT NUMBER: RS 0142(10)	DRAWN BY: T. LACKEY
FILE NAME: sf193pe.d	CHECKED BY:
PROJECT LEADER: R. WHITCOMB	ROW SHEET 11 OF 14
DESIGNED BY: T. LACKEY	
78193/str/sf193pe.dgn	