


# RIGHT - OF - WAY DETAIL SHEET

TABLE OF PROPERTY ACQUISITION

PARCEL NO.	PROPERTY OWNER	SHEET NO.	BEGINNING STATION	ENDING STATION	TAKE AREA±	REMAINDER AREA±	RIGHT			RECORDING DATA				REMARKS	
							TYPE	(T)/(P)	AREA ±	TITLE	DATE	TOWN / CITY	BOOK		PAGE
1A	BAILEY, CLAYTON A. JR.	14	398+96.8 LT. 399+37.5 LT. TH 8 501+90 LT.	400+08.0 LT. 399+79.7 LT.			INSTALL	(T)	920 SF	WD	02/22/07	CASTLETON	137	616-617	PDF GUY WIRE AND ANCHOR
1B		14	398+97.24 LT.	400+11.16 LT.	2,800 SF		ALL R.T. & L								VT. RTE. 4A & TH 8 HWY. EASE.
2	TOWN OF CASTLETON	14	399+79.06 LT. TH 8 550+26.39 CL 400+08.0 LT.	400+42.13 LT. TH 8 501+03 LT. TH 8 501+07 LT.	1,571 SF		ALL R.T. & L APPROACH INSTALL	(T) (T)							VT. RTE. 4A PDF
3A	DUMAS, ARLYN	14	400+42.13 LT. 400+53.8 LT. 400+78.9 LT. 401+38.2 LT.	400+47.8 LT. 401+21.4 LT. 401+15.8 LT. 402+75.8 LT.			SLOPE INSTALL CHANNEL UTILITY	(T) (T) (P) (P)	12 SF 780 SF 120 SF 0.10 A	WD	06/27/07	CASTLETON	139	51	PDF & EROSION CONTROL 4,300 SF±; (30' WIDE)
3B		14	400+11.05 LT.	401+23.97 LT.	2,620 SF		ALL R.T. & L								VT. RTE. 4A & TH 8 HWY. EASE.
4A	SATTON, THOMAS J. & CYNTHIA	14	401+33.5 LT. 401+45.5 LT.	404+25.00 LT. 402+42.2 LT.			CONST CHANNEL	(T) (P)	2,320 SF 940 SF	WD	08/28/06	CASTLETON	136	170	INCLUDES PDF & EROSION CONTROL
4B		14	401+13.78 LT.	404+25.00 LT.	0.18 A		ALL R.T. & L								VT. RTE. 4A HWY. EASE.; 7,770 SF±
5A	WELCH, SCOTT T.	14	400+85.58 RT. 400+55.8 RT. 400+62.6 RT. 401+86.1 RT. 401+88.4 RT. 401+90 RT. 402+10.6 RT. 402+68.1 RT.	404+25.00 RT. 401+91.1 RT. 402+21.2 RT. 402+29.7 RT. 402+05.3 RT. 403+52.0 RT.	0.21 A±		DETOUR UTILITY INSTALL & MAINTAIN CONST. REMOVE & RESET CONST.	(T) (P) (P) (T) (T)	2,420 SF 0.10 A 350 SF 450 SF	WD	10/24/06	CASTLETON	136	601-602	9,200 SF± INCLUDES PDF & EROSION CONTROL 4,570 SF± GUY ANCHOR & WIRE INCLUDES PDF & EROSION CONTROL PAVED DRIVE, 18' WIDE, MM 0421 COMMERCIAL SIGN INCLUDES PDF
5B		14	401+03.30 RT.	404+25.00 RT.	0.18 A		ALL R.T. & L								VT. RTE. 4A HWY. EASE.; 7,710 SF±
6A	MORTON BUILDINGS, INC.	14	398+99.4 RT. 399+02.7 RT. 399+37.7 RT. 399+50.0 RT. 400+37.0 RT. 399+81 RT. 400+81.8 RT.	399+63.2 RT. 399+50.0 RT. 400+84.4 RT. 401+03.30 RT. 400+81.8 RT. 399+67.0 RT. 400+89.2 RT.			CONST. SLOPE UTILITY DETOUR SLOPE INSTALL & MAINTAIN CHANNEL	(T) (T) (P) (T) (P) (P) (P)	600 SF 400 SF 3,450 SF 0.12 A 100 SF 200 SF	WD	10/24/06	CASTLETON	136	600-601	INCLUDES PDF INCLUDES EROSION CONTROL INCLUDES PDF & EROSION CONTROL; 5,270 SF± INCLUDES TEMPORARY EROSION CONTROL GUY WIRE & ANCHOR
6B		14	398+98.32 RT.	401+13.78 RT.	0.12 A±		ALL R.T. & L								VT. RTE. 4A HWY. EASE.; 5,120 SF±

TABLE OF REVISIONS

REVISION NO.	SHEET NO.	DESCRIPTION	DATE
1	12	PARCEL NO. 6, MORTON BUILDINGS INC. CHANGE TAKE AREA ON 6B FROM 0.18A TO 0.12A±. STA. CHANGE FOR GUY WIRE & ANCHOR-CHANGED ENDING STATION TO 399+67.0 RT. PER C.O. 9449 MADE BY:JB APPROVED BY:RD	03/06/06
2	12	PARCEL NO. 5, WELCH, SCOTT. ADD 450 SF TO CONST. (T) STA. 402+68.1 RT. PER C.O. 9450 MADE BY:JB APPROVED BY:RD	03/06/06
		ELECTRONIC IPARMS TO STRUCTURES 1/4/07	

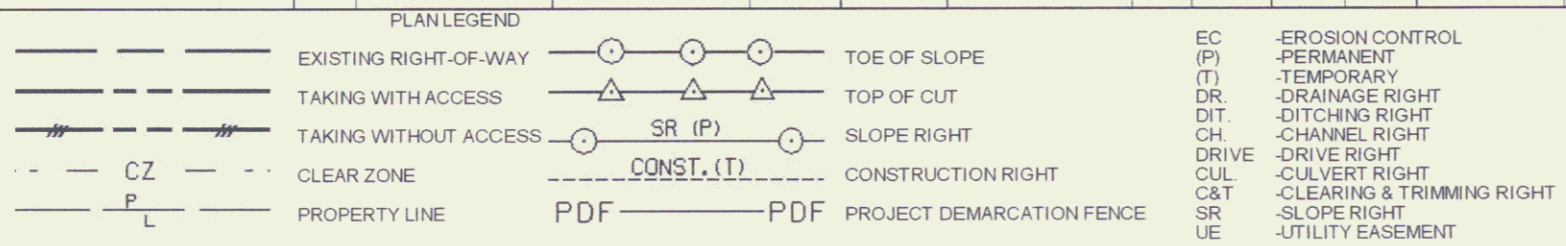

SEP 16 2008

APPROVED: ROGER P. DUMAS DATE: 09-27-05  
CHIEF, PLANS & TITLES

PROJECT NAME: **CASTLETON**  
PROJECT NUMBER: **RS 0142(10)**  
FILE NAME: **RF193DET.XLS** PLOT DATE: **Date**  
PROJECT LEADER: **R.WHITCOMB** DRAWN BY: **M.R.**  
DESIGNED BY: **T. LACKEY** CHECKED BY: **E.P.**  
R.O.W. SHEET **12** OF 14 SHEET **9** OF 69

PLOT DATE 09/05/07