

Construct Special Ditch  
(Excavation To Be Paid Under Item 204.20)  
24+75 Rt ~ 26+00 Rt.

CHAMBERLAIN, RICHARD J. & MARYANNE T.  
a/k/a MARIANNE


BOISSONEAULT, RENE P & BARBARA A.

MAHALICK, ALBERT I. & AUGUSTE E.

BOISSONEAULT, RENE P & BARBARA A.

MATCH LINE  
SEE SHEET NO. 6 OF 10

MATCH LINE  
SEE SHEET NO. 8 OF 10

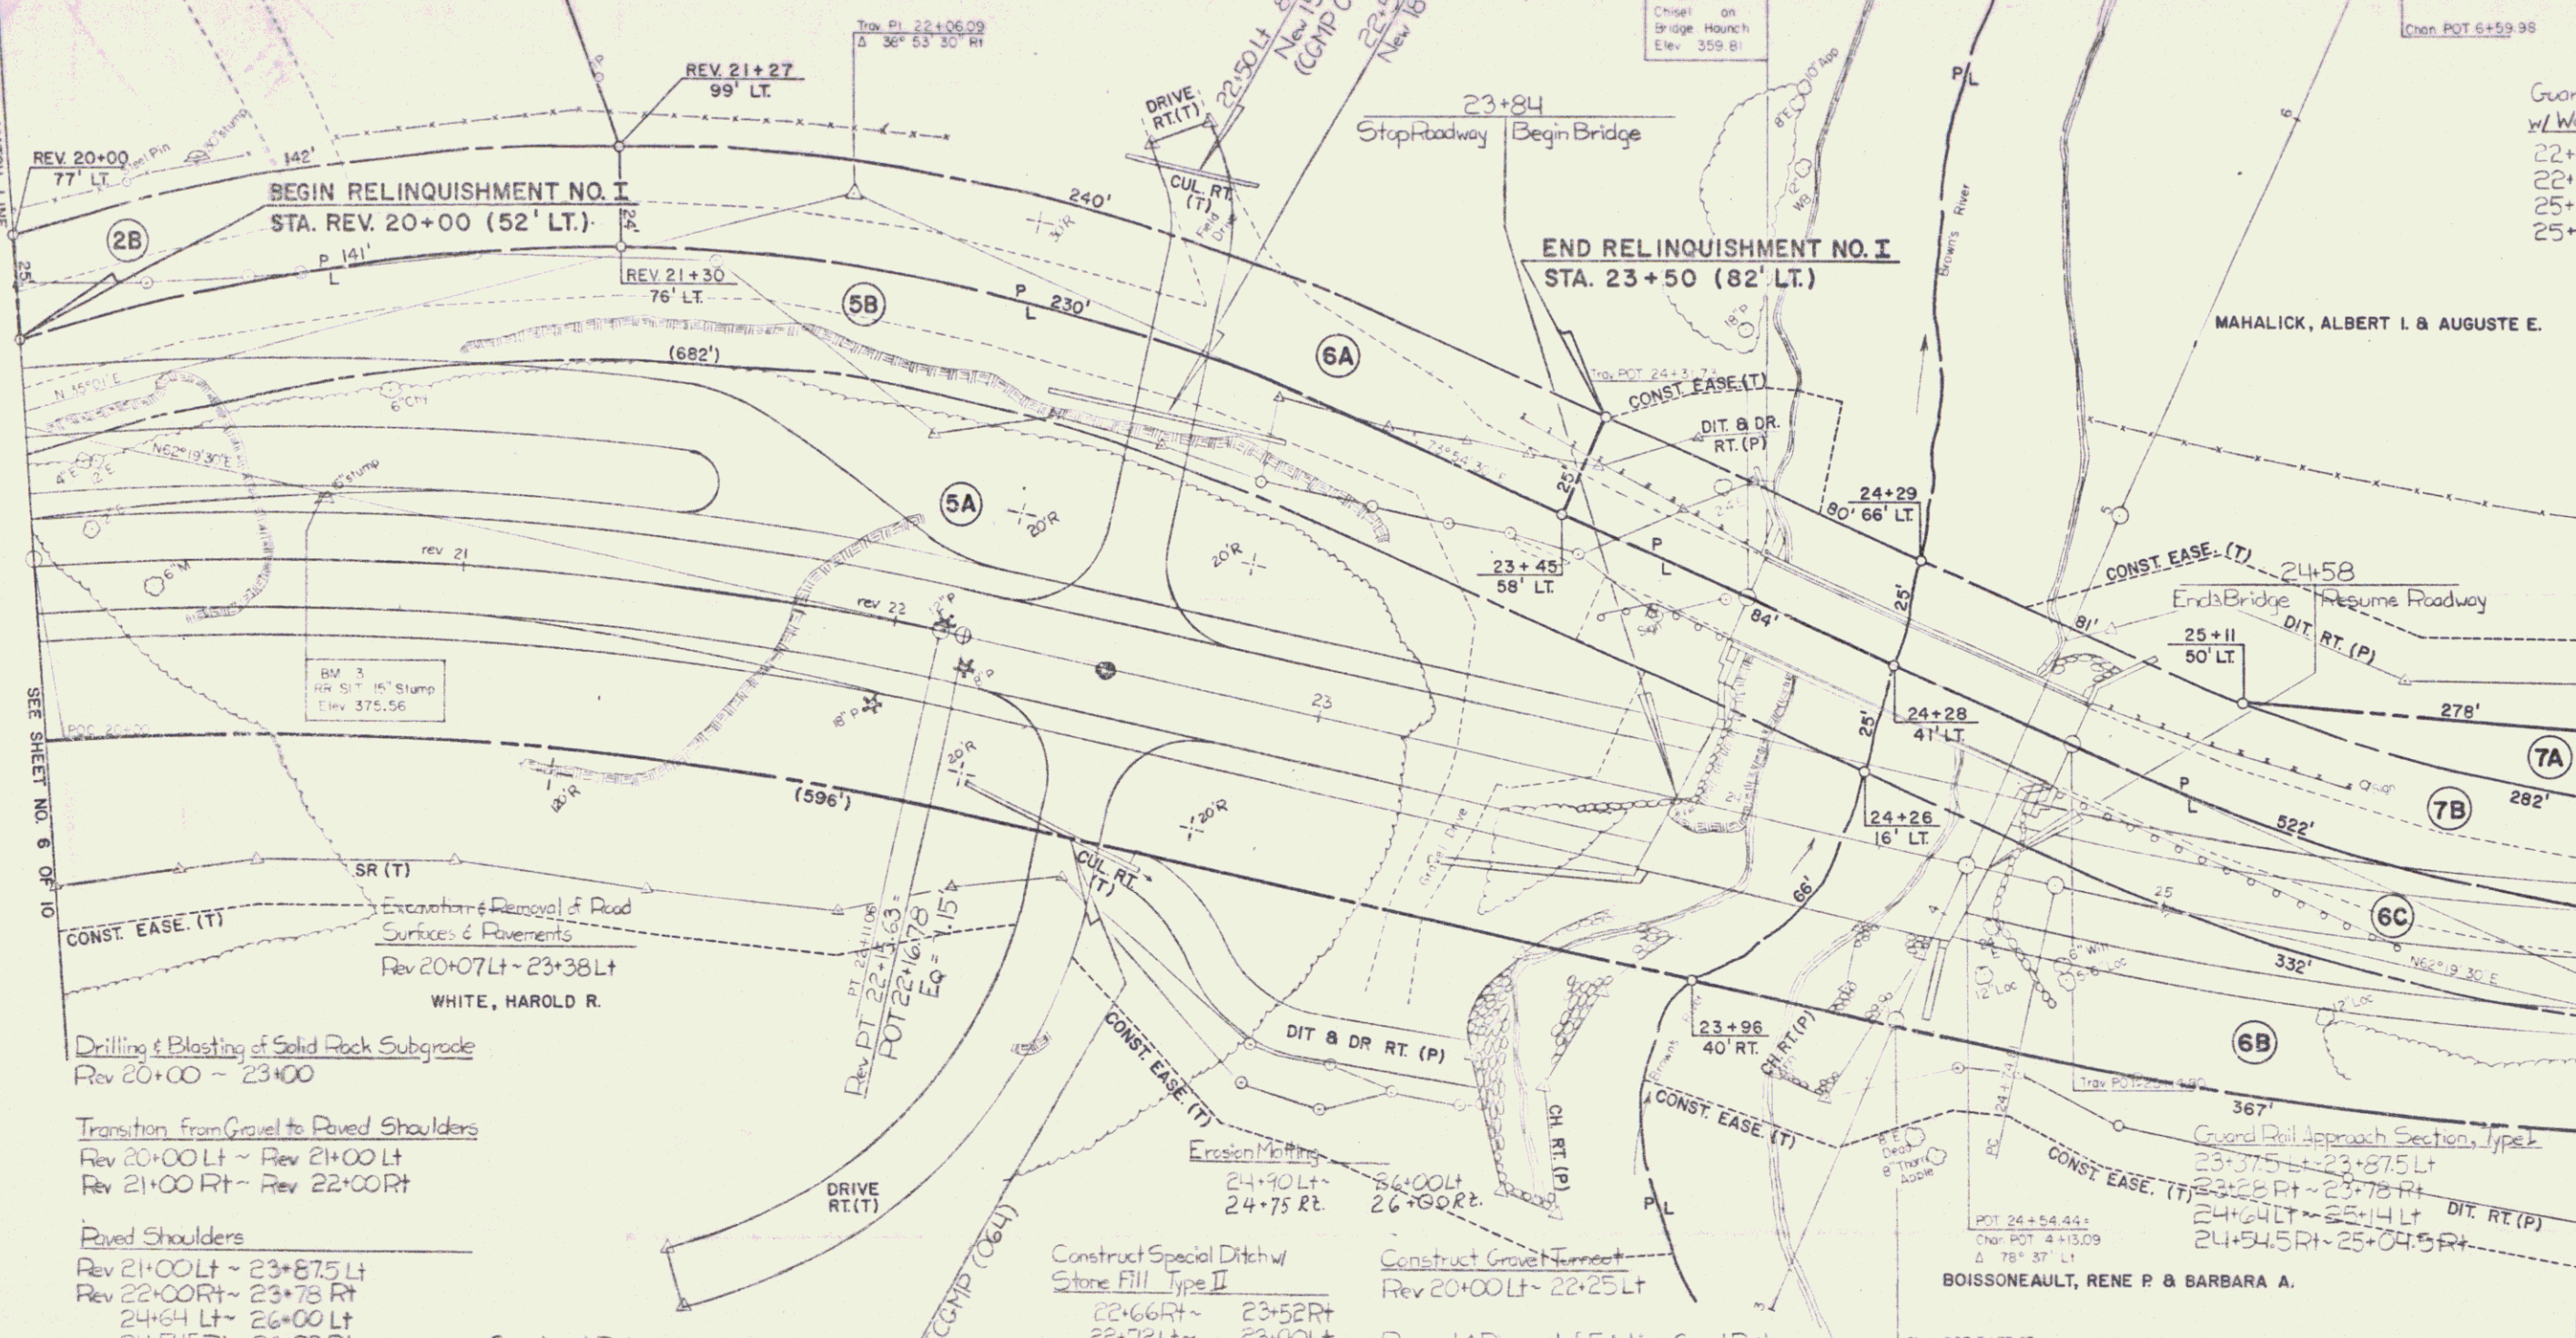

DATUM  
VERTICAL Assumed  
HORIZONTAL N.T.S.

SURVEYED BY \_\_\_\_\_ DATE \_\_\_\_\_  
DRAWN BY \_\_\_\_\_ DATE \_\_\_\_\_  
TRACED BY \_\_\_\_\_ DATE \_\_\_\_\_  
FAIRFAX  
PROJ. BRS NO. 0229 (2)  
SHEET 7 OF 10