


INDEX OF SHEETS

STATE OF VERMONT AGENCY OF TRANSPORTATION



PROPOSED IMPROVEMENT **TOWN OF HIGHGATE** COUNTY OF FRANKLIN **U.S. ROUTE NO. 7**

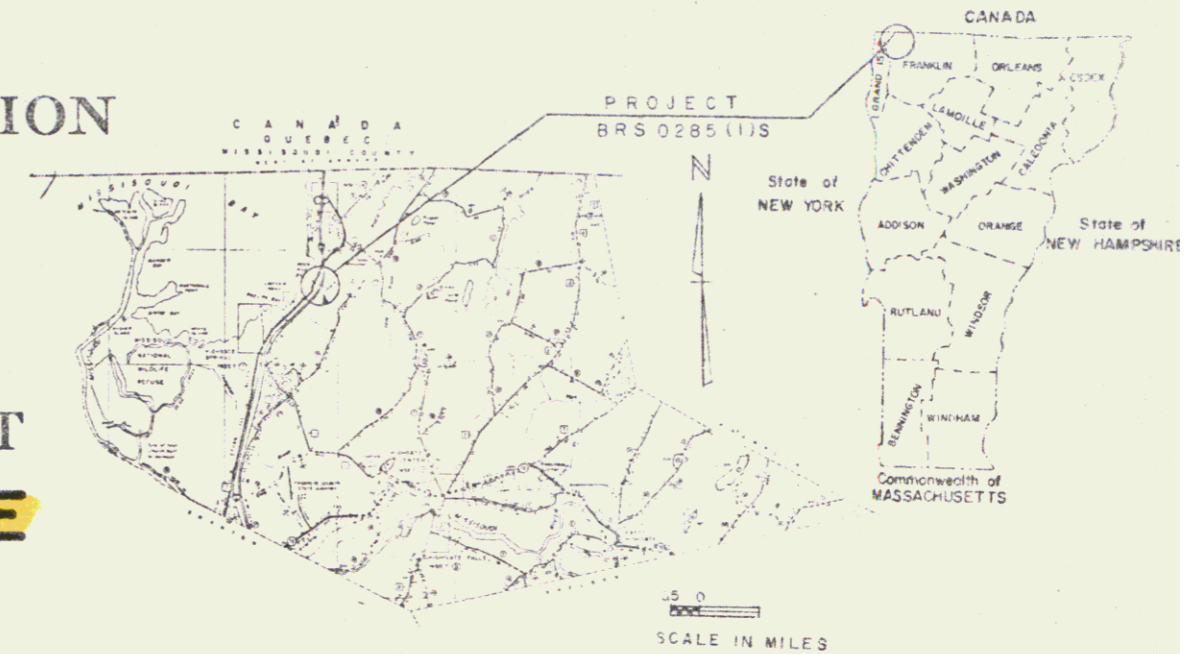


R.O.W. PLANS

BURLINGTON-HIGHGATE ROAD
BEGINNING AT A POINT 4.204 MILES NORTHERLY FROM THE
SWANTON-HIGHGATE TOWN LINE AND EXTENDING NORTHERLY 0.189 MILES
LENGTH OF ROADWAY 907.34 FEET = 0.172 MILES
LENGTH OF BRIDGE 92.66 FEET = 0.017 MILES
LENGTH OF PROJECT 1000.00 FEET = 0.189 MILES
LENGTH OF R.O.W. PROJECT 1100.00 FEET = 0.208 MILES

MP 4.2
BEGIN R.O.W. PROJECT
BRS 0285(1)S STA. 222+00

- CONVENTIONAL SIGNS
- COUNTY LINE
 - TOWN LINE
 - LIMITS OF ACCESS
 - POINT OF ACCESS
 - FENCE LINE
 - STONE WALL
 - TRAVELED WAY
 - GUARD RAIL
 - RAILROAD
 - SURVEY LINE
 - CULVERT
 - POWER POLE
 - TELEPHONE POLE
 - TREES
 - CONTROL OF ACCESS
 - PROPERTY LINE
 - R.O.W. TAKEN LINE
 - SLOPE RIGHTS
 - TOP OF CUT
 - TOE OF SLOPE

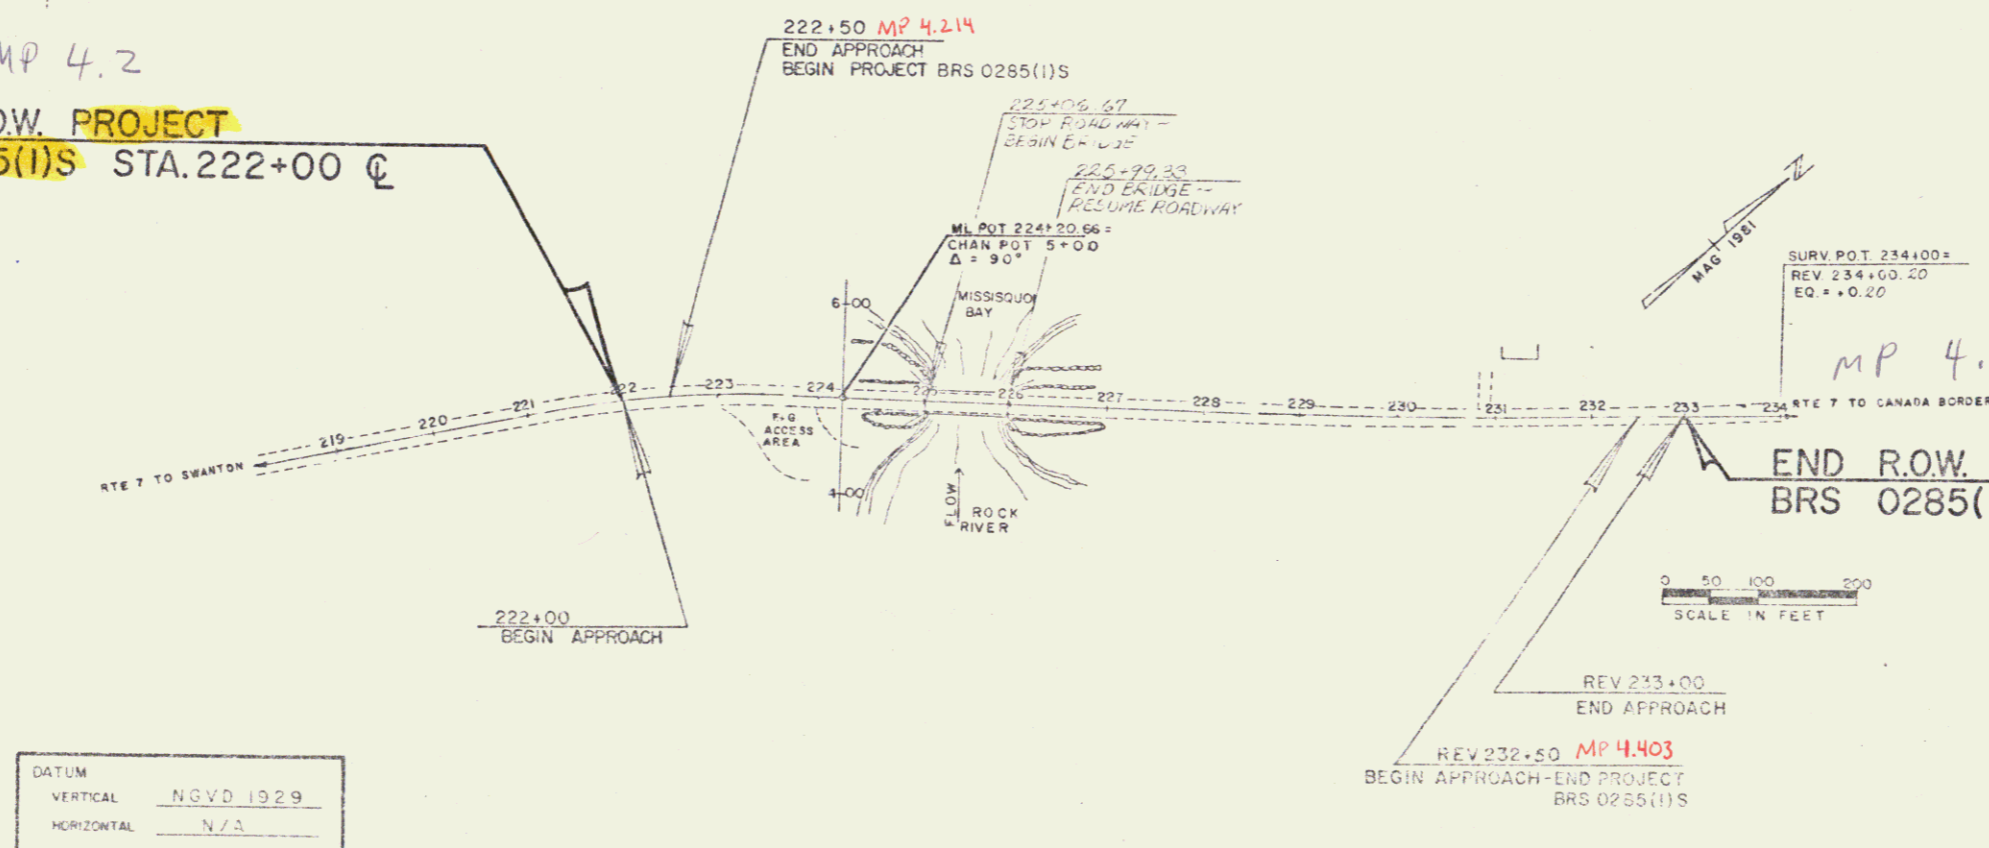

RIGHT-OF-WAY DIVISION
TOWN FILE
PERPETUAL
Town of _____
(To Be Returned To R.O.W. Division)

END R.O.W. PROJECT
BRS 0285(1)S REV. STA. 233+00

Pin # 78F205
PROJECT PROCESSED UNDER
SECONDARY ROAD PLAN

These plans are subject to such engineering changes as may be required by the Federal Highway Administration or the Director of Engineering and Construction. Construction is to be carried on in accordance with these plans and the Standard Specifications for Highway and Bridge Construction dated March, 1976, as approved by the Federal Highway Administration on October 27, 1976 for use on this project, including all subsequent revisions and such revised specifications and special provisions as are incorporated in these plans.

SUBMITTED BY ORDER OF THE STATE TRANSPORTATION DEPARTMENT

APPROVED: *[Signature]* DATE 5-16-83
DIRECTOR OF ENGINEERING AND CONSTRUCTION

DEPARTMENT OF TRANSPORTATION
FEDERAL HIGHWAY ADMINISTRATION

APPROVED: _____ DATE _____
DIVISION ADMINISTRATOR

HIGHGATE
PROJECT BRS 0285(1)

SHEET 1 OF 6

APPROVED: *[Signature]* DATE 5-16-83
CHIEF, PROPERTY ADMINISTRATION