


DATUM  
 VERTICAL NGVD 1929  
 HORIZONTAL N/A

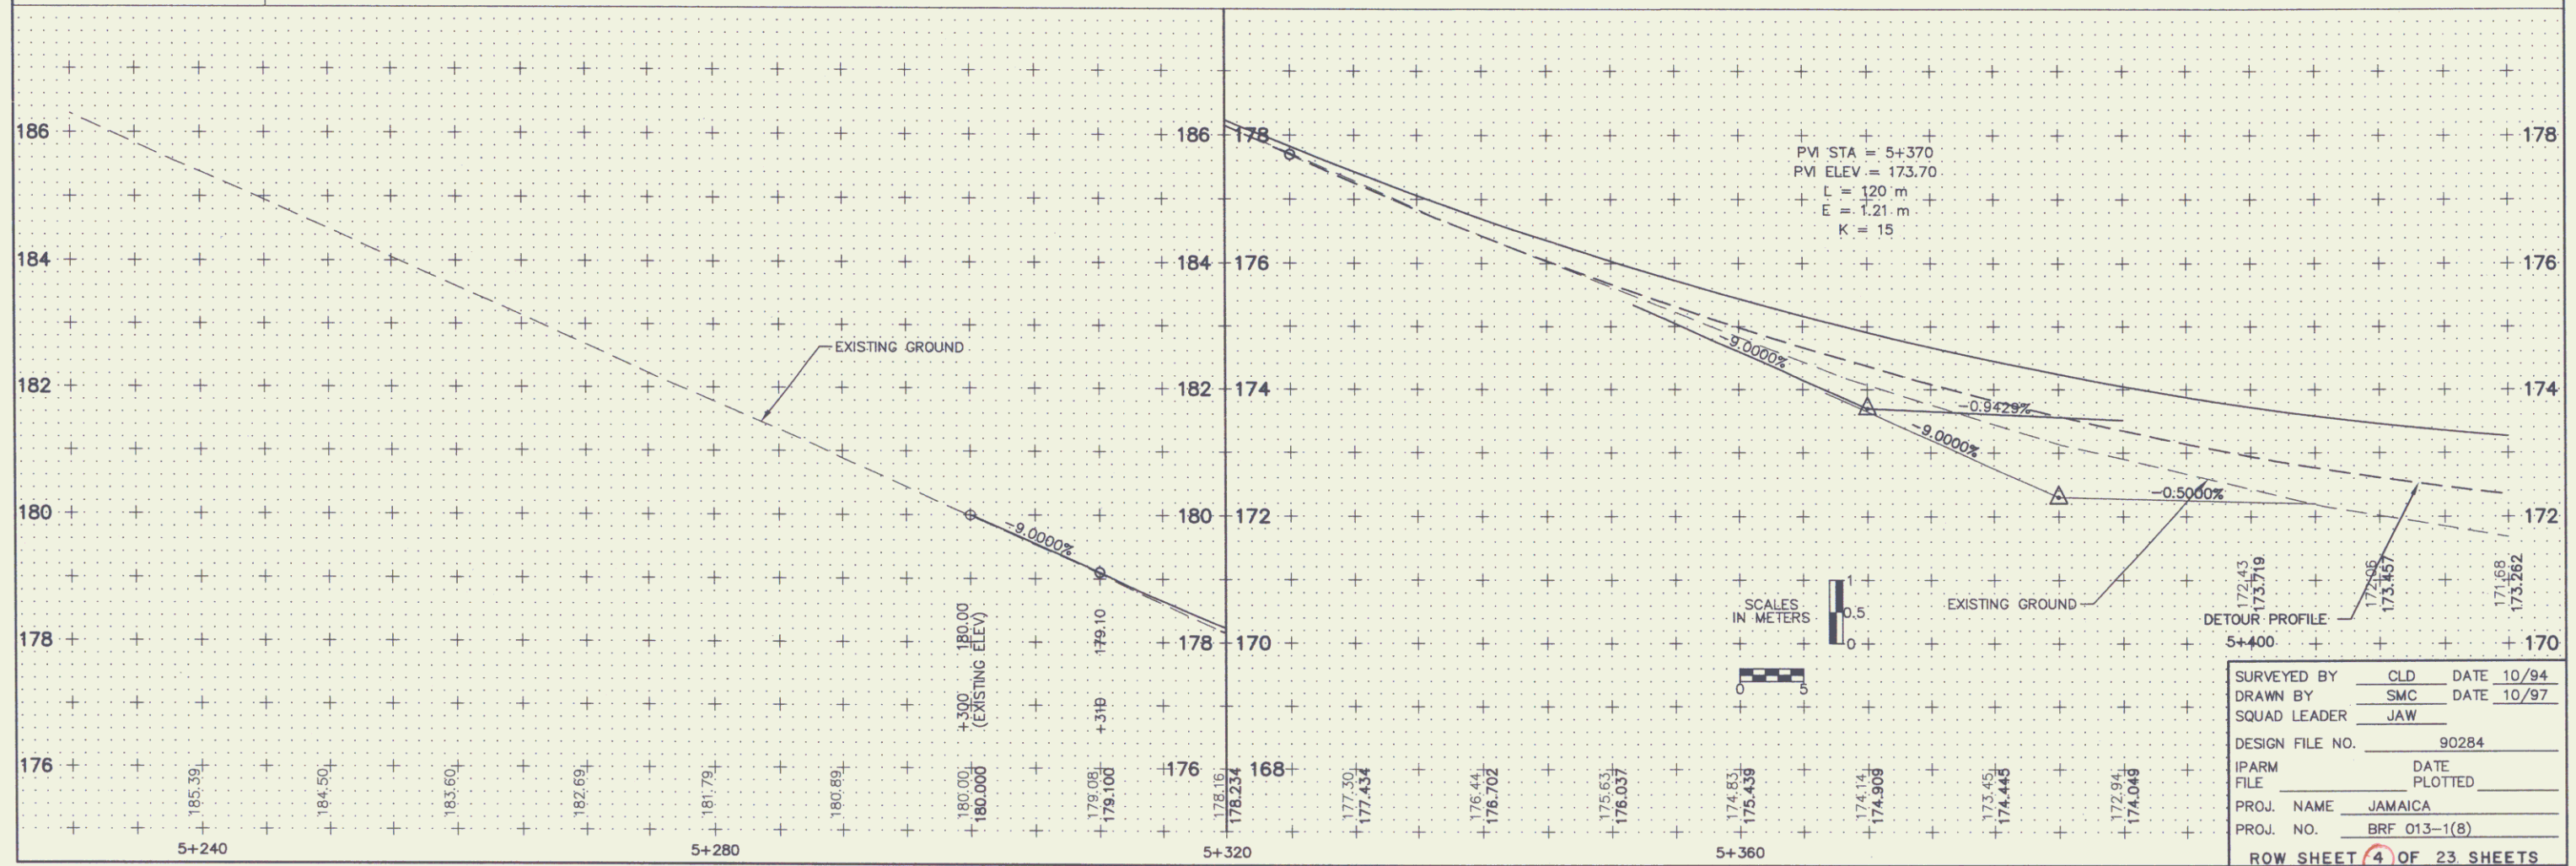

90284PRCL.dwg 05/18/00 11:43:32 AM AM EDT

SURVEYED BY CLD DATE 10/94  
 DRAWN BY SMC DATE 10/97  
 SQUAD LEADER JAW  
 DESIGN FILE NO. 90284  
 IPARM FILE DATE PLOTTED  
 PROJ. NAME JAMAICA  
 PROJ. NO. BRF 013-1(B)  
 ROW SHEET 4 OF 23 SHEETS