


**PLAN**  
SCALE IN METERS  
0 5 10

—LIMIT OF STONE FILL  
TYPE IV


BRIDGE ENDPST LOCATION & APPROACH RAIL LENGTH			
LOCATION	ENDPOST DIST. TO DECK END	APPROACH RAIL LENGTH	RADIUS
● WW #1	700 mm	7620 mm	10 000 mm
● WW #2	700 mm	7620 mm	10 000 mm
● WW #3	770 mm	7620 mm	0 mm
● WW #4	770 mm	7620 mm	0 mm

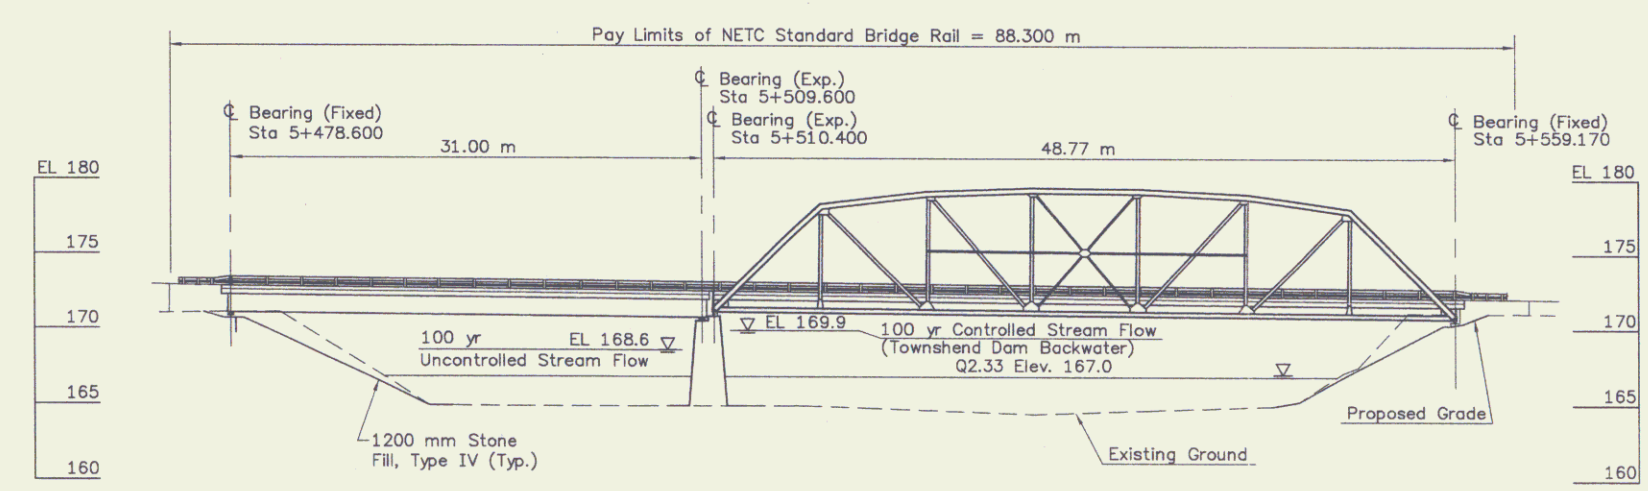

**ELEVATION**  
SCALE IN METERS  
0 5 10

**STATE OF VERMONT**  
**AGENCY OF TRANSPORTATION**

Town Of	JAMAICA	Bridge No.	
Highway No.	VT RTE. 100	Log Sta.	
		Surv. Sta.	
VT ROUTE 100 OVER WEST RIVER			
PLAN AND ELEVATION			
Designed By	LM	Drawn By	GFB
Checked By	Date	Bridge Design Supervisor	Date
PROJECT	JAMAICA	PROJECT NO.	
I.G.C. info.			
ROW SHEET 8 OF 23 SHEETS			

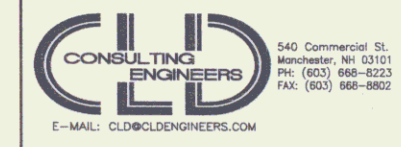

BMM-GENP.DWG