


STONE FILL, TYPE I
 Toe of Slope
 28+80 - 29+35 Rf.

EROSION MATTING
 29+35 - 29+58 Rf.

Surv. Curve Data
 $\Delta = 1^{\circ}53'24''$
 $D = 0^{\circ}30'$
 $R = 11459.16$
 $T = 108.35$
 $L = 376.67$
 $E = 1.55$
 $2T - L = 0.03$
 Normal Crown

COLEMAN, ROY E., ESTATE

END R.O.W. PROJECT
 BRF 015-1(6)S STA. 30+00 C

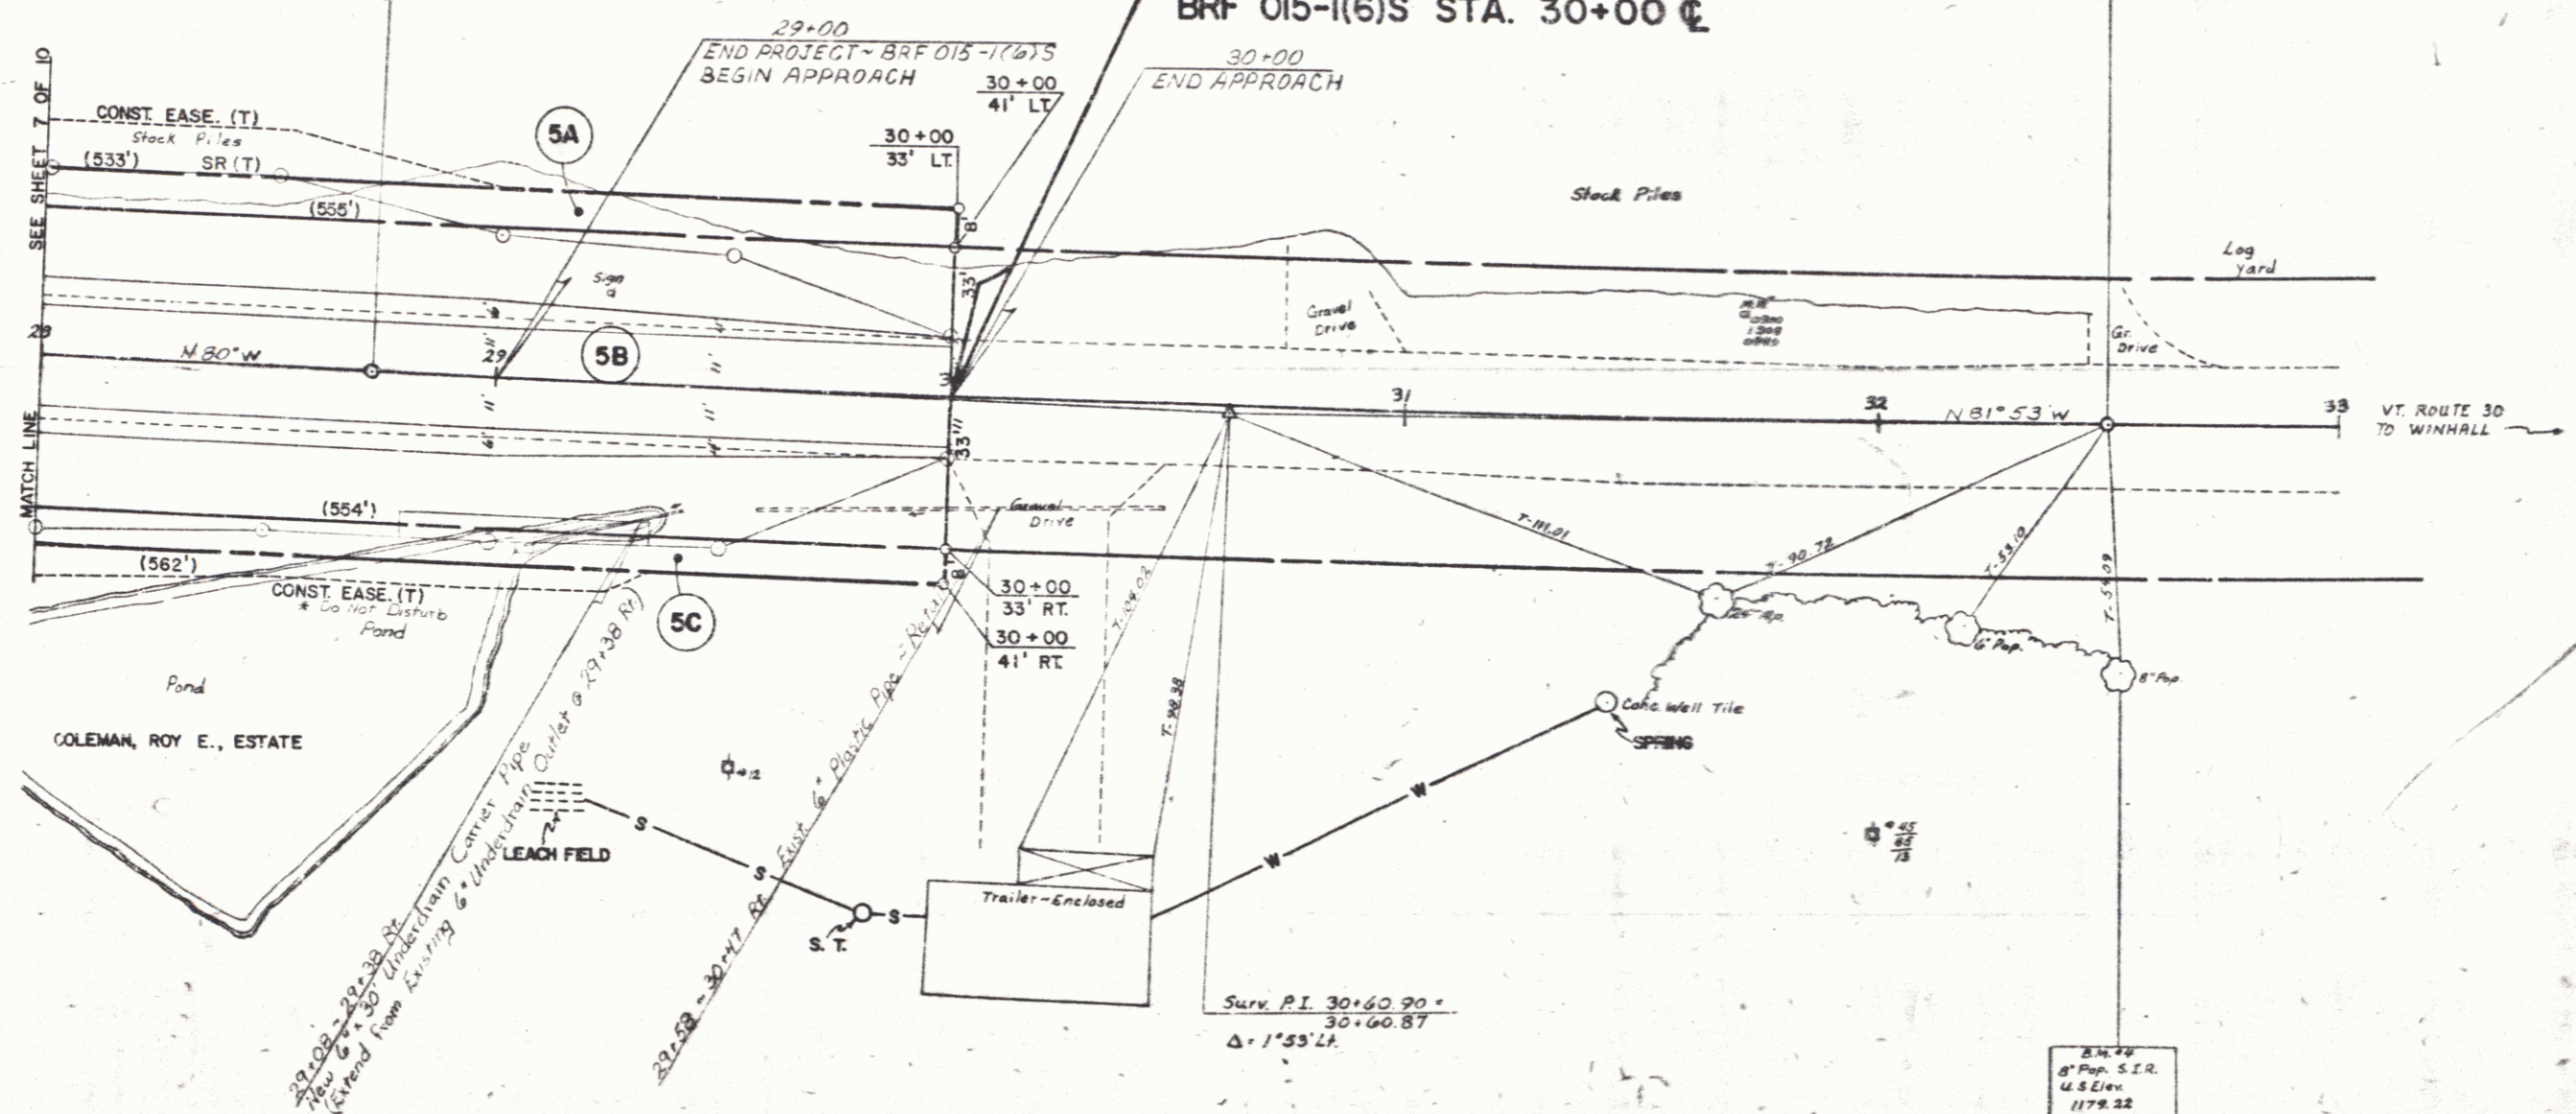

DATUM
 VERTICAL NGVD 1929
 HORIZONTAL N/A

APR 10 1987

SURVEYED BY EASTON DATE 10-82
 DRAWN BY HERRIK DATE 10-82
 TRACED BY HERRIK DATE 11-82
 PROJ. JAMAICA
 No. BRF 015-1(6)S
 SHEET 6 OF 10