

BMP CHD 50 SW GATE HOUSE ELEV 146.49

END MAINT. AGREE.  
 AREA NO. 1  
 REV. 126+61 44' RT.  
 LENGTH 24'


DATUM  
 VERTICAL MVD 1929  
 HORIZONTAL N/A

TH 28 SURV POT 15-27.00 @ VRT.  
 REV PC 14-38.41  
 REV PT 15-56.68  
 SURV PI 126+71.84 = 126+66.97  
 SURV POST 126-78.35- TH 28 POT 15-00.00 @ 142-00-00 RT

TH 5 SURV 19-97.24  
 TH 5 SURV POT 20-31.00  
 REV PC 20-01.9  
 REV PT 20-62.06

TH 28 SURV POT 15-27.00 @ VRT.  
 SURV POT 22-00.00  
 SURV POST 127-18.87- TH 5 SURV POT 20+00 @ 54-09-30 RT  
 REV PI 127-19.41- 127-13.50

TH 5 REV PI 20-32.25- 20-31.00  
 REV PC 20-01.9  
 REV PT 20-62.06

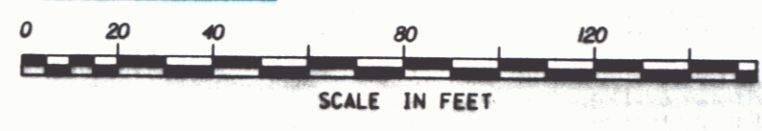

08-03-93	REVISION 6
04-07-93	REVISION 3 & 4
10-29-92	REVISION 2

03-3025 1805 78F213 FJM  
 SURVEYED BY FANTONI DATE 9/85  
 DRAWN BY MELNER DATE 12/88  
 SQUAD LEADER HEDGES/L JUNVALL  
 REGION 7/000/78123/123222.dwg  
 PARM FILE 782322.dwg DATE PLOTTED 03-AUG-1993  
**LONDONDERRY**  
**BRF 016-1(13)**  
 R. O. W. SHEET 13 OF 13

End Project approach extended to Station 130+80

APR 21 1997