






GPS CONTROL POINTS

NOT SHOWN
ON PLANS






NOT SHOWN
ON PLANS

NOT SHOWN
ON PLANS

TRAVERSE TIES

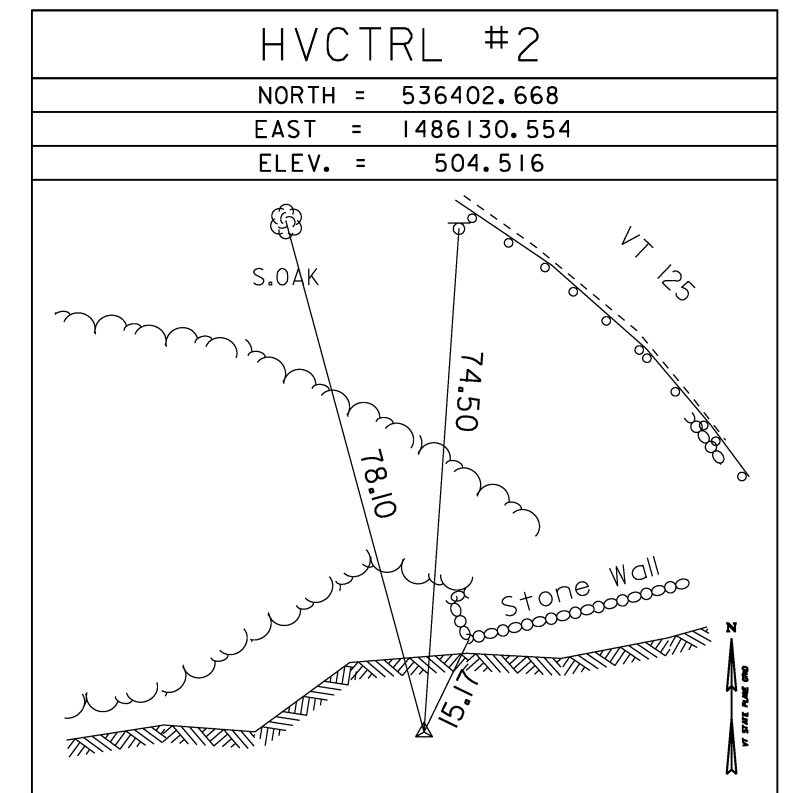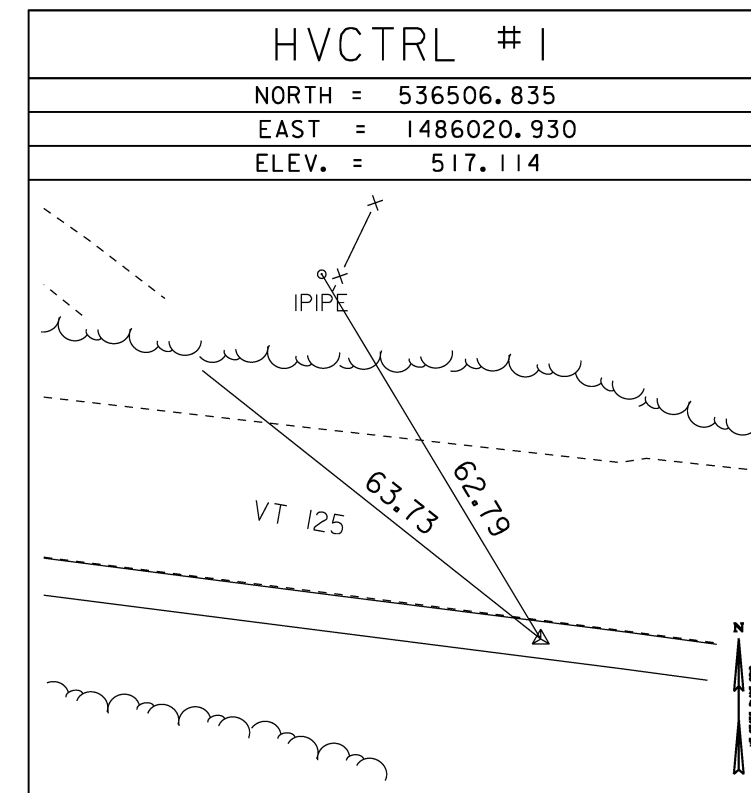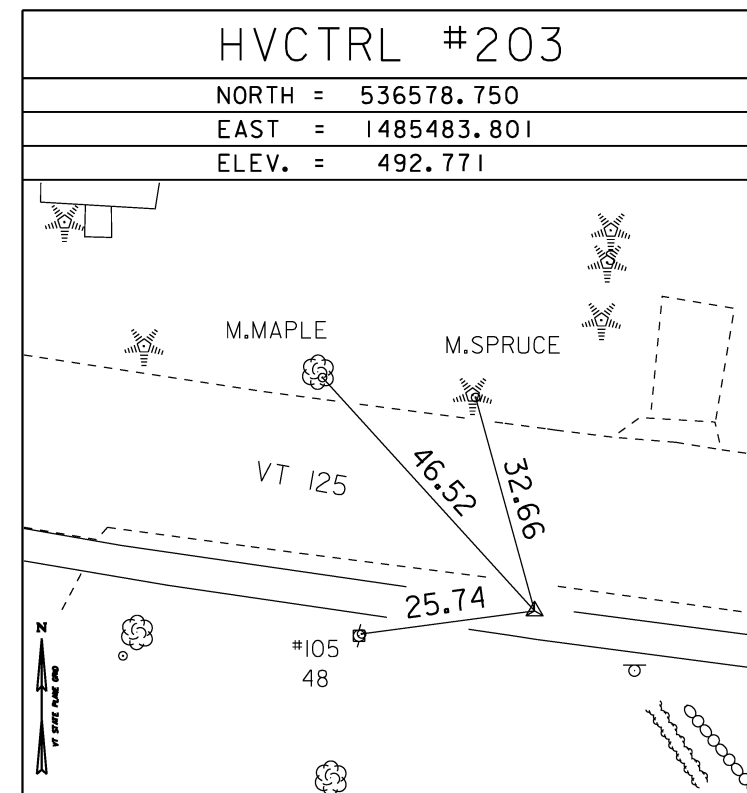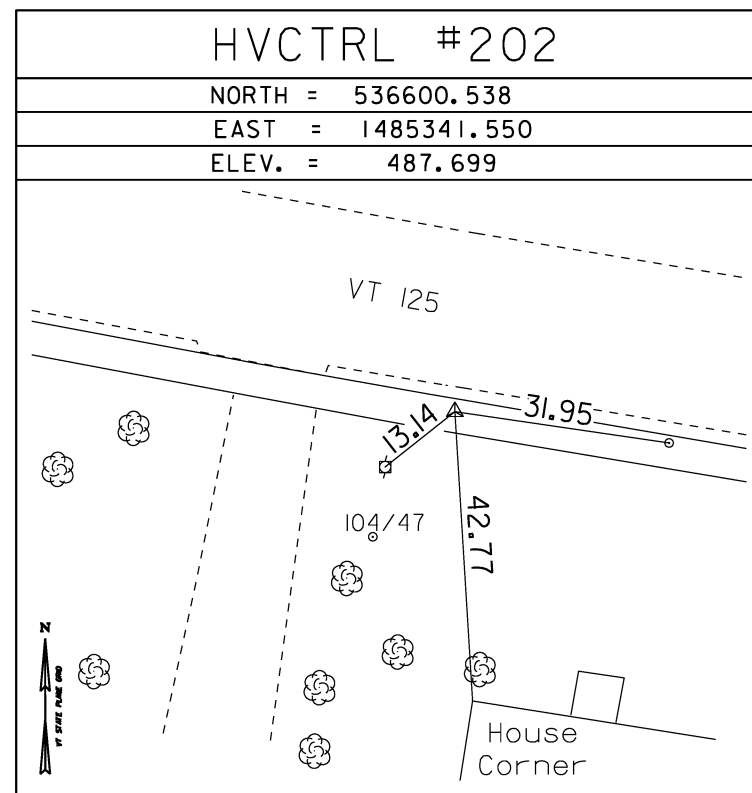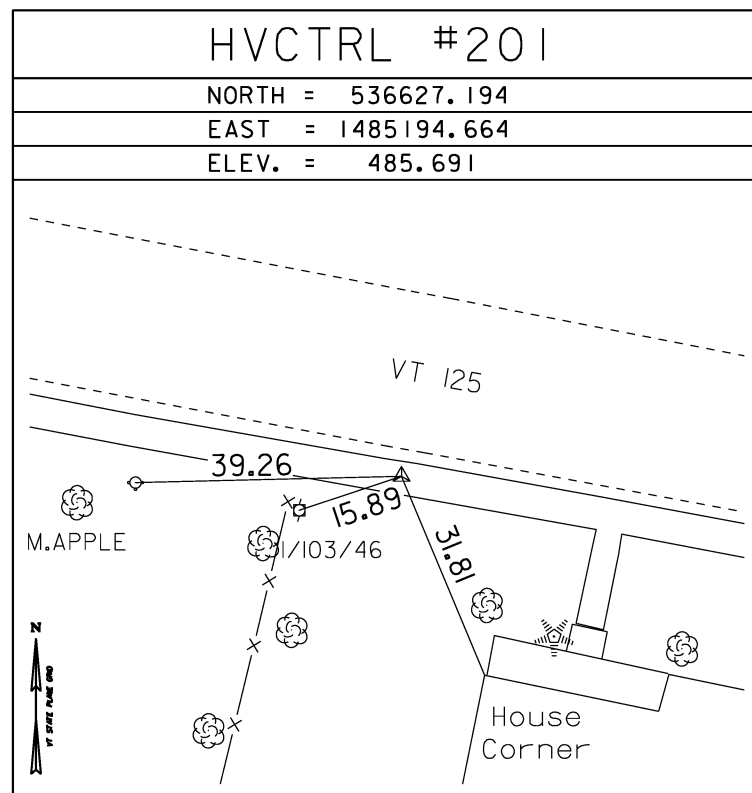

TRAVERSE TIES

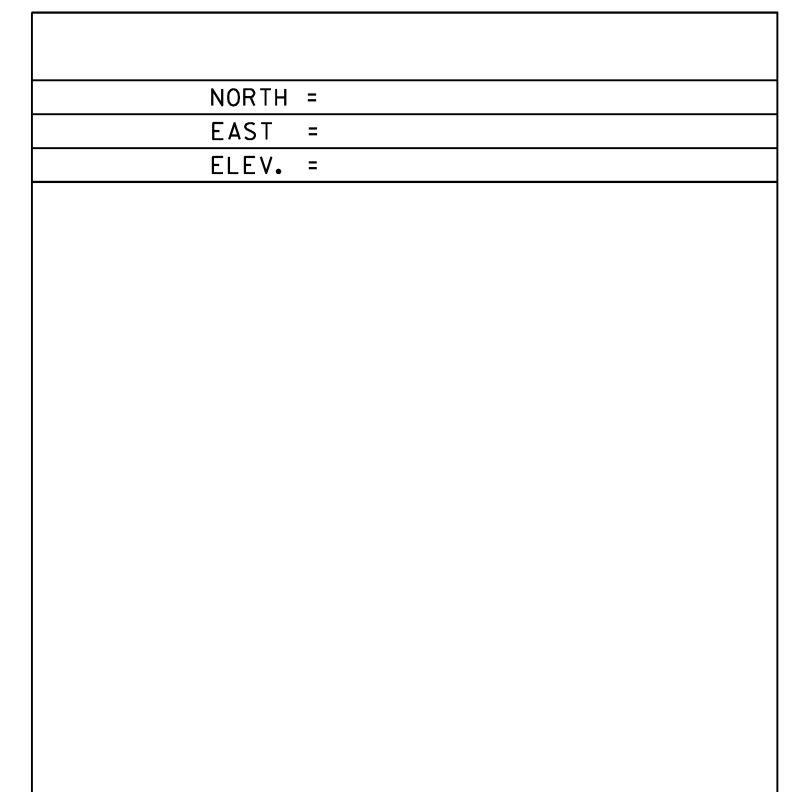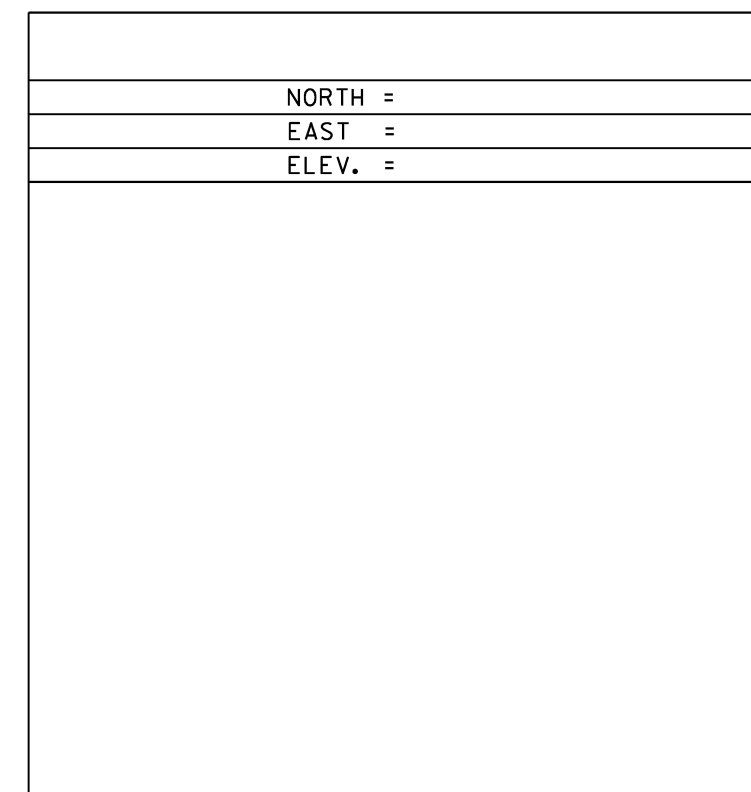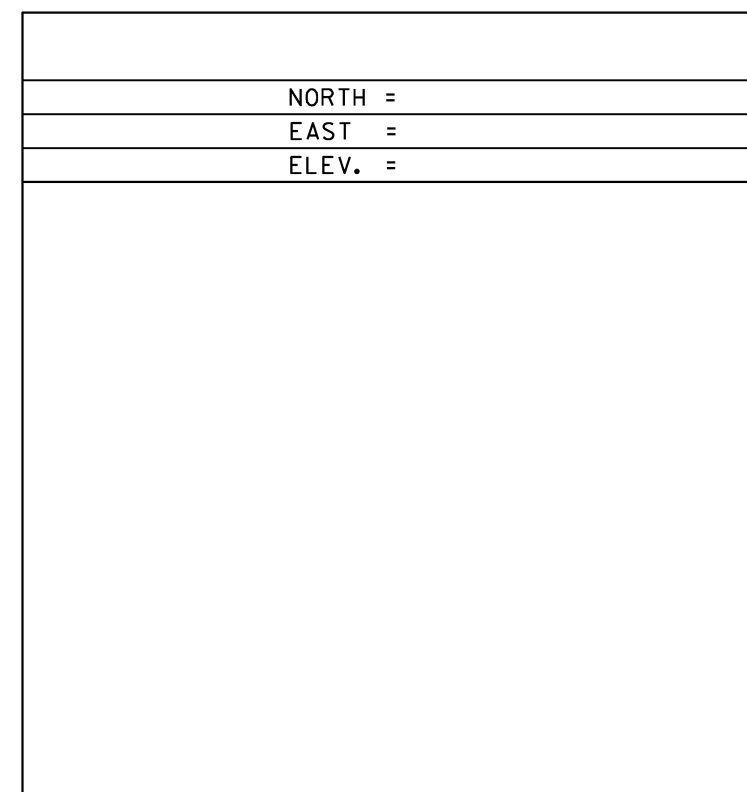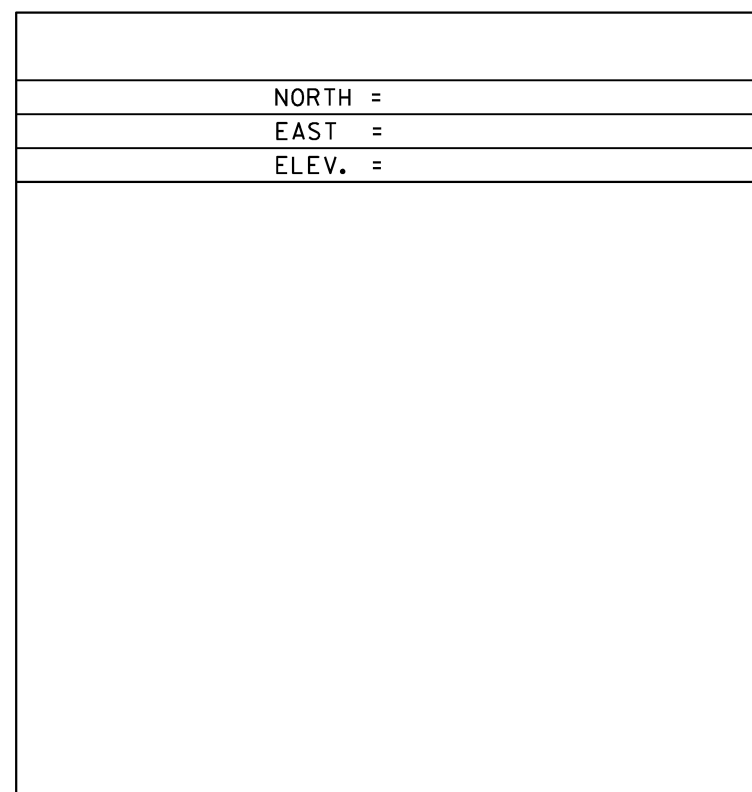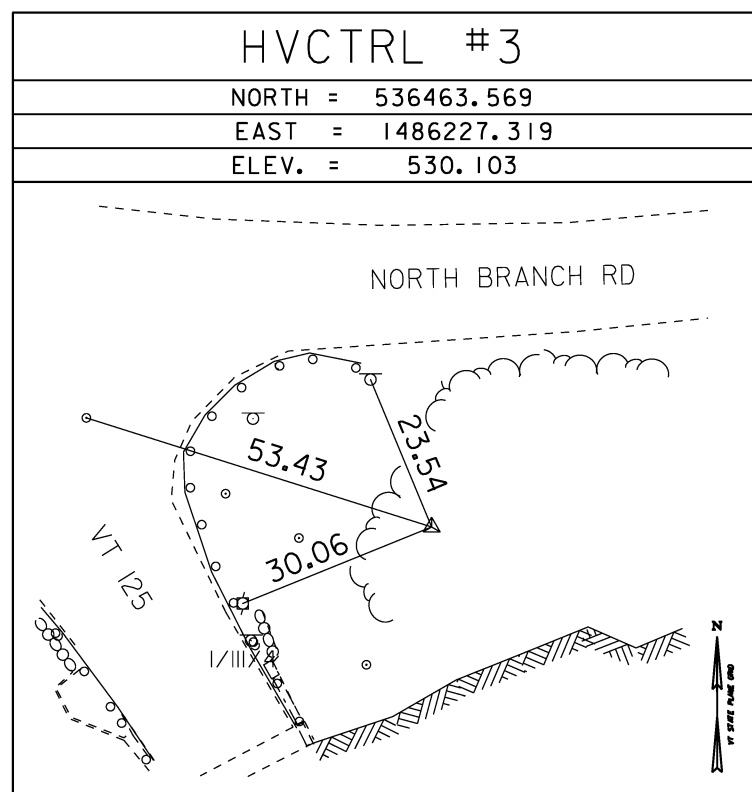

DATUM	
VERTICAL	NAVD 88
HORIZONTAL	NAD 83 (92)
ADJUSTMENT	-

PROJECT NAME: MIDDLEBURY	
PROJECT NUMBER: RS 0174(8)	
FILE NAME: r78f2171e.dgn	PLOT DATE: 01-NOV-2012
PROJECT LEADER: J. FITCH	DRAWN BY: B.J. MASSE
DESIGNED BY: B.J. MASSE	CHECKED BY: G.S. GOODRICH
TIE SHEET	SHEET 9 OF 21