

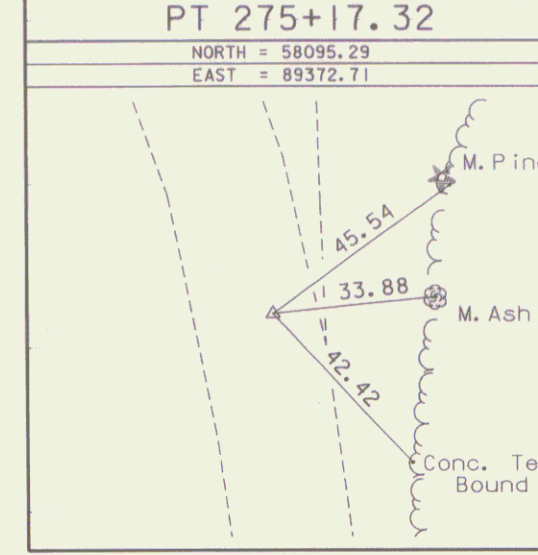
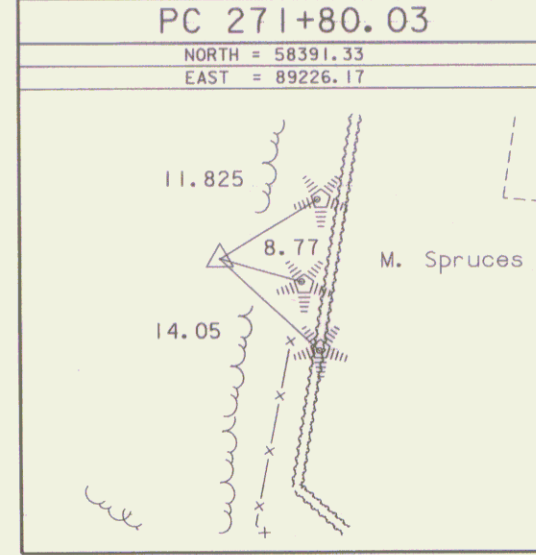
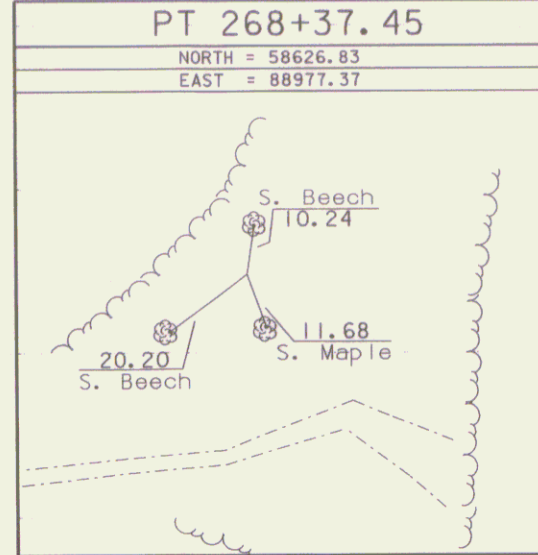
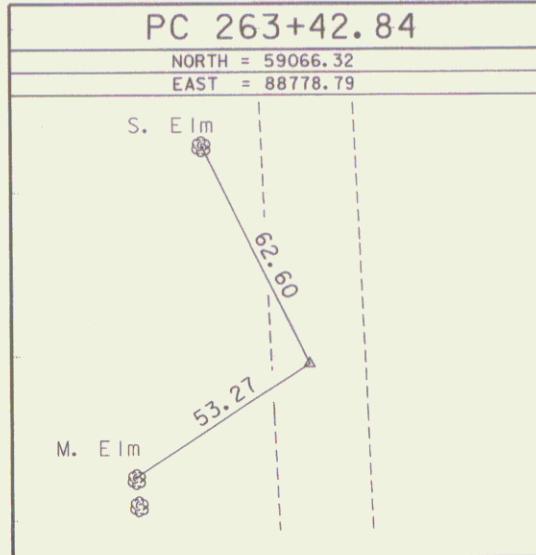
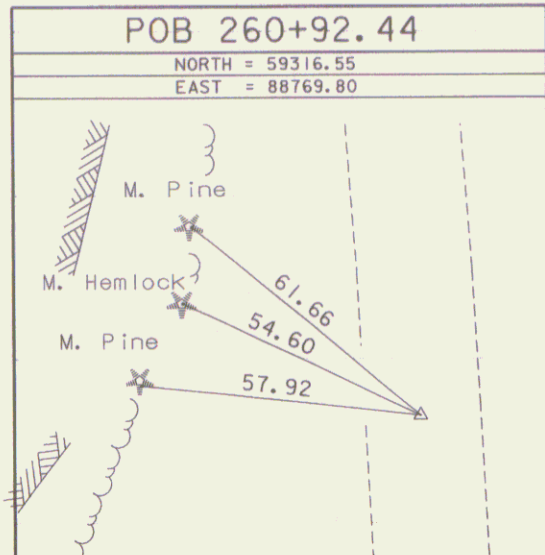
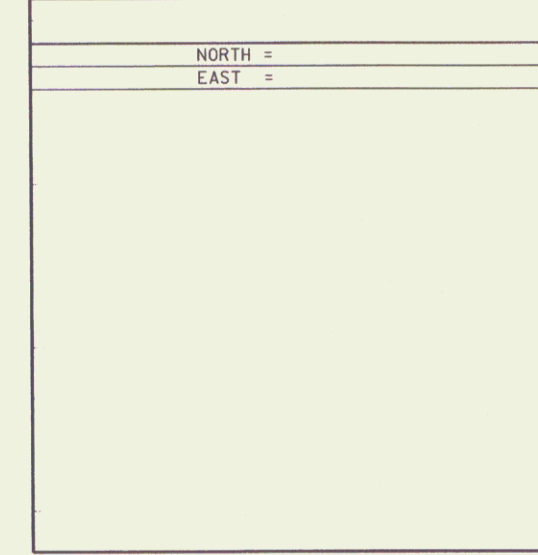
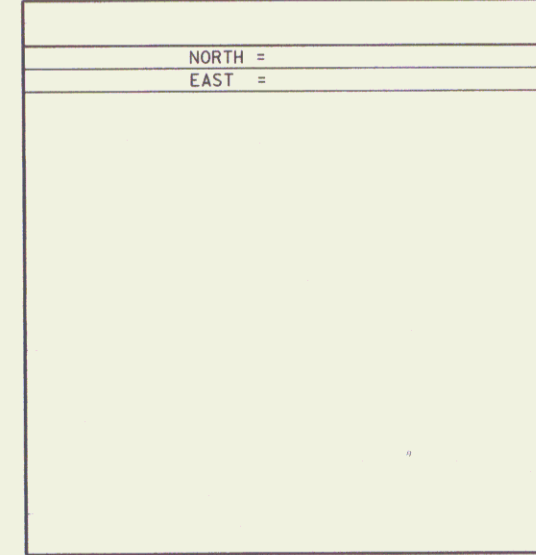
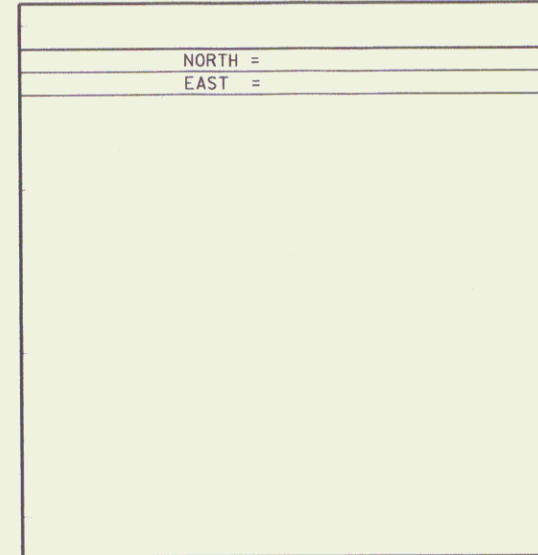


ALIGNMENT TIES

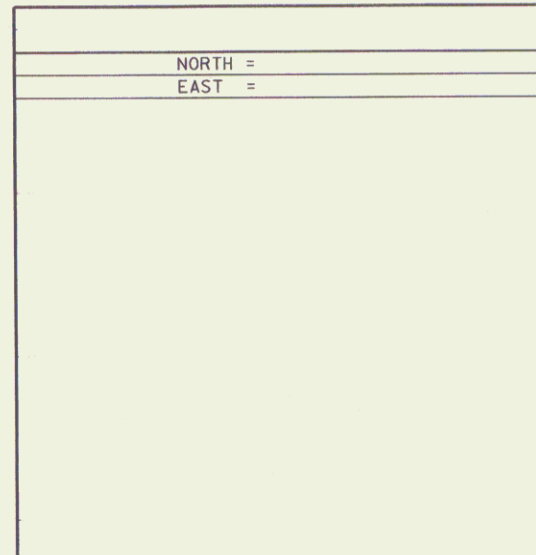

• ALIGNMENT STAKED 06/06/03 by J. Hulett & P. Winters & A. Somani

ALIGNMENT TIES

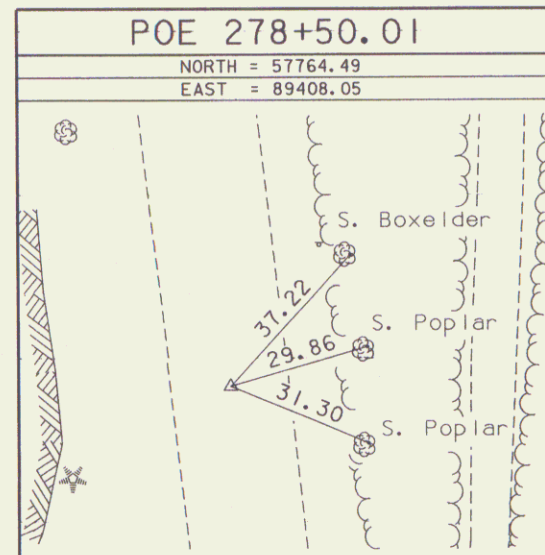

DATUM	
VERTICAL	NAVD 83
HORIZONTAL	NAD 88
ADJUSTMENT	Compass

PROJECT NAME:	Moretown - Middlesex
PROJECT NUMBER:	BRS 0284 (14)
FILE NAME:	78f219/survey/xf219t1.dgn
PROJECT LEADER:	
DESIGNED BY:	
PLOT DATE:	03-JUN-2008
DRAWN BY:	R. Bullock
CHECKED BY:	
ROW SHEET:	8 OF 20

