


# RIGHT - OF - WAY DETAIL SHEET

TABLE OF PROPERTY ACQUISITION

PARCEL NO.	PROPERTY OWNER	SHEET NO.	BEGINNING STATION	ENDING STATION	TAKE AREA±	REMAINDER AREA±	RIGHT			RECORDING DATA				REMARKS	
							TYPE	(TYP)	AREA ±	TITLE	DATE	TOWN / CITY	BOOK		PAGE
1A	CARTER, DREW L. & ROBERTA L.	18	261+00.00 RT	264+62.64 RT	0.08A					WD	02/02/09	MORETOWN	86	351-353	3,323 SF+ SUBJECT TO STORM WATER PERMIT INC. PDF & EROSION CONTROL 14' GRAVEL, LENGTH 240' MM 0315
			261+24 RT	DRIVE STA. 69+06 RT			CONST.	(T)	0.13A						
			262+90 RT	264+95 RT			SLOPE	(T)	295 SF						
			265+34 RT				DRIVE	(T)							
1B		18,19	TH9 105+84.32 LT	TH9 105+33.04 LT	0.02A										1,017 SF+ SUBJECT TO STORM WATER PERMIT INC. PDF & E. C. 4,072 SF+ 605 SF+ EXISTING DRIVE ACCESS TO US RTE 2
			DRIVE STA 69+06 LT	TH9 105+29 LT			CONST.	(T)	0.09A						
			265+88 RT	TH9 105+65 LT			SLOPE	(T)	0.01A						
			266+53 RT				REMOVE	(T)							
1C		18,19	261+00.00 RT	TH9 105+52.69 RT	0.35A										HWY EASE. US RTE 2 SUBJECT TO STORM WATER PERMIT
2A	LARSEN, JONATHAN Z. JOINED BY VERMONT LAND TRUST, INC.	19	TH9 105+49.12 LT	TH9 103+16.75 LT.	0.08A					WD	05/06/09	MORETOWN	87	385-387	3,700 SF SUBJECT TO STORM WATER PERMIT 1,970 SF±, INC. PDF & E. C.
			TH9 105+33.04 LT.	TH9 103+24 LT.			CONST.	(T)	0.04A						
			TH9 103+56 LT	TH9 103+43 LT.			DITCH	(P)	93 SF						
2B		19	TH9 103+01 RT	TH9 103+40 RT			CONST.	(T)	734 SF						INC. PDF & EROSION CONTROL
			TH9 103+15 RT	TH9 103+35 RT			CHANNEL	(P)	360 SF						
			TH9 103+25 RT	TH9 103+30 RT			SLOPE	(T)	12 SF						
			TH9 103+40 RT	TH9 103+45 RT			SLOPE	(T)	20 SF						
2C		19	TH9 105+49.12 LT	269+67.85 RT	0.15A										HWY EASE. US RTE 2 & TH9

TABLE OF REVISIONS

REVISION NO.	SHEET NO.	DESCRIPTION	DATE
1	16,18,19	PARCEL NO. 2 LARSEN. ADD VERMONT LAND TRUST TO TITLE. MADE BY: MT	07/23/08
2	16,18,19	PARCEL NO. 2 LARSEN. CHANGE 2B TO 2A. CHANGE 2C TO 2B. ADD NEW PARCEL 2C. REMOVE VT LAND TRUST FROM LAYOUT ON LEFT SIDE OF CENTER LINE. ADD NEW STATIONS AND RUNNING DISTANCES. MADE BY: MT	08/13/08
3	17,19,20	PARCEL NO. 3 COLLINS. CHANGE TITLE TO TEBEAU, MARY KAY, F/K/A COLLINS, MARY KAY. MADE BY: MT	08/13/08
4	17,18,19	PARCEL NO. 8 LARSEN. CREATE NEW PARCEL. LARSEN, JONATHAN Z. JOINED BY THE VERMONT LAND TRUST, INC. 2A IS NOW 8A. PART OF 2D IS NOW 8B. ADD NEW AREAS AND LINE WORK ON LAYOUT. ADD NEW STATIONS AND DISTANCES. MADE BY: MT	08/13/08
		ELECTRONIC FILES TO STRUCTURES	01/29/09
5	1,17,19	TOWN OF MORETOWN. CHANGE ENDING STATION OF RELINQUISHMENT NO. 1 FROM TH 9 103+16.75 LT TO TH 9 103+44.61 RT. MADE BY: MR	08/30/12
6	19	GENERAL REVISION. REVISE OFFSET AT STATION TH 9 104+33.08 WHICH READS 26.00 RT. TO READ 26.02 RT. MADE BY: MR	11/07/12

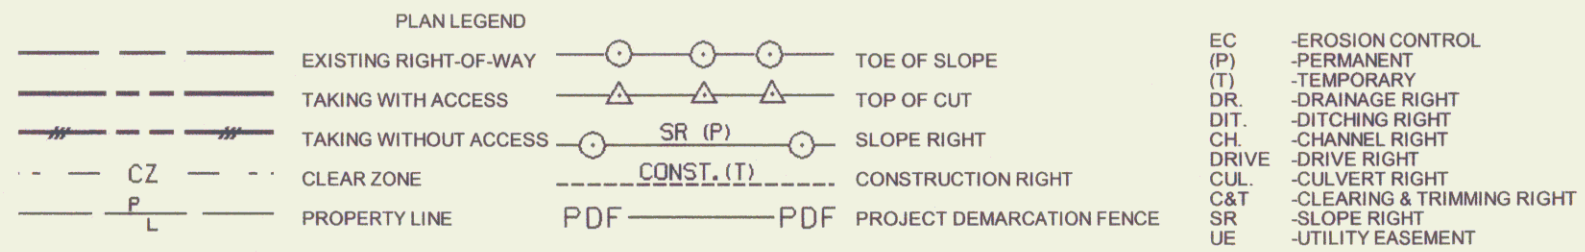

APPROVED: HARRY PETROVS, DATE: 06-23-08  
CHIEF, PLANS & TITLES

PROJECT NAME: MORETOWN-MIDDLESEX  
PROJECT NUMBER: BRS 0284(14)  
FILE NAME: 78F219ENGROWDETAILSHEE PLOT DATE: Date  
PROJECT LEADER: M. EVANS-MONGEON DRAWN BY: 0  
DESIGNED BY: L. RUSSELL CHECKED BY: 0  
R.O.W. SHEET 16 of 20 SHEET 75 OF 103

PLOT DATE 11/07/12