
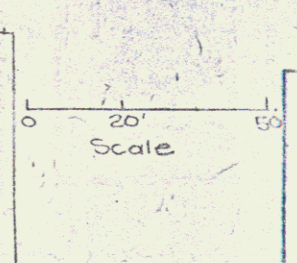
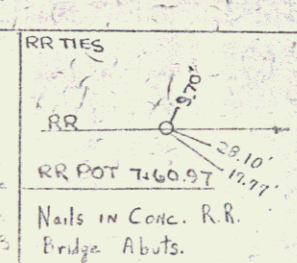
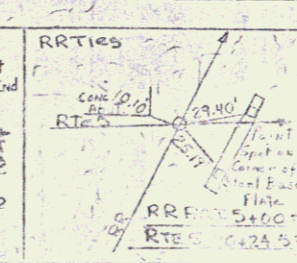
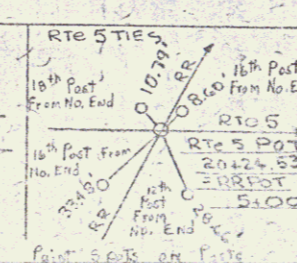
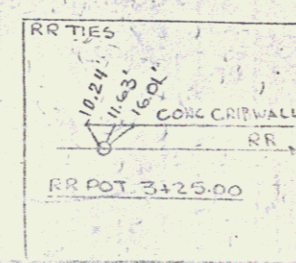


DATUM
 VERTICAL: NAD 1929
 HORIZONTAL: N/A

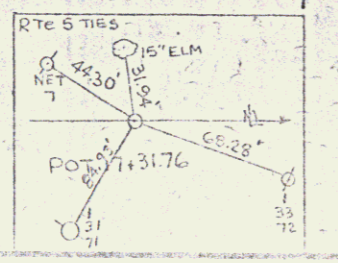

SURVEYED BY: Tesser DATE 10/81
 DRAWN BY: R. Mason DATE 12/81
 TRACED BY: R. Mason DATE 12/81
 NEWBURY BRS 0113 (17)
 SHEET 8 OF 11