

Cast in Place Cement
 Conc. Curb, Type B
 Rt.
 21+75 ~ 22+93

Bit. Conc. Surface for Gutters
 and Traffic Islands
 22+65 Lt. ~ 22+75 Lt.

Construct Drive
 23+08 Rt.
 23+95 Lt.

Special Ditch w/ Stone
 Fill, Type I
 TH 76, 10+25 Rt. ~ 12+91 Rt. (Rev.)

Cast in Place Cement Conc. Curb, Type A
 Lt.
 22+75 ~ 23+76


Portland Cement Conc. Sidewalk, 5" (4')
 Rt.
 21+75 ~ 22+96

Guard Rail, Std. S.H. Em. w/
 Wood Posts, Type II
 Rt.
 21+75 ~ 22+43

BCT for Guard Rail, Std. S.H. Em. w/
 Wood Posts, Type II
 Rt.
 22+43 ~ 22+68

Lt.
 21+75 (US 5) ~ 13+00 (Rev. TH 76)

Treated Timber Curb
 Lt.
 21+75 ~ 22+00

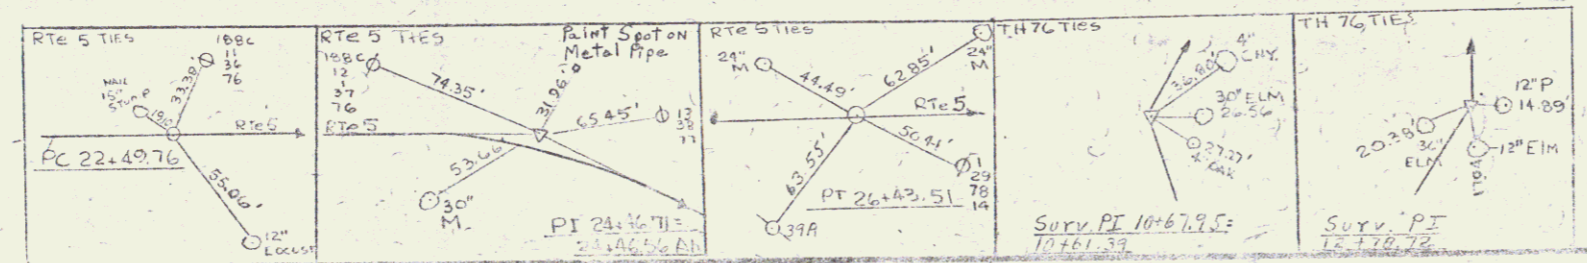

DATUM
 VERTICAL: NGVD 1929
 HORIZONTAL: N/A

0 20 80
 Scale

SURVEYED BY: _____ DATE: _____
 DRAWN BY: _____ DATE: _____
 TRACED BY: _____ DATE: _____
 NEWBURY BRS 013 (17)
 SHEET 7 OF 11