


STONE FILL, TYPE II
CHANNEL 10'x5'x 10-75 PI

Guard Rail Std Str. Beam w/
Wood Posts, TYPE II
LT
Rev. TH 76 1310A-3-77

Construct Drive
Rev. 13+46 RT (77' RT)
Rev. 13+87 LT

Spec Ditch w/ Stone Fill, Type I
RT
Rev. 12+91 - 13+30

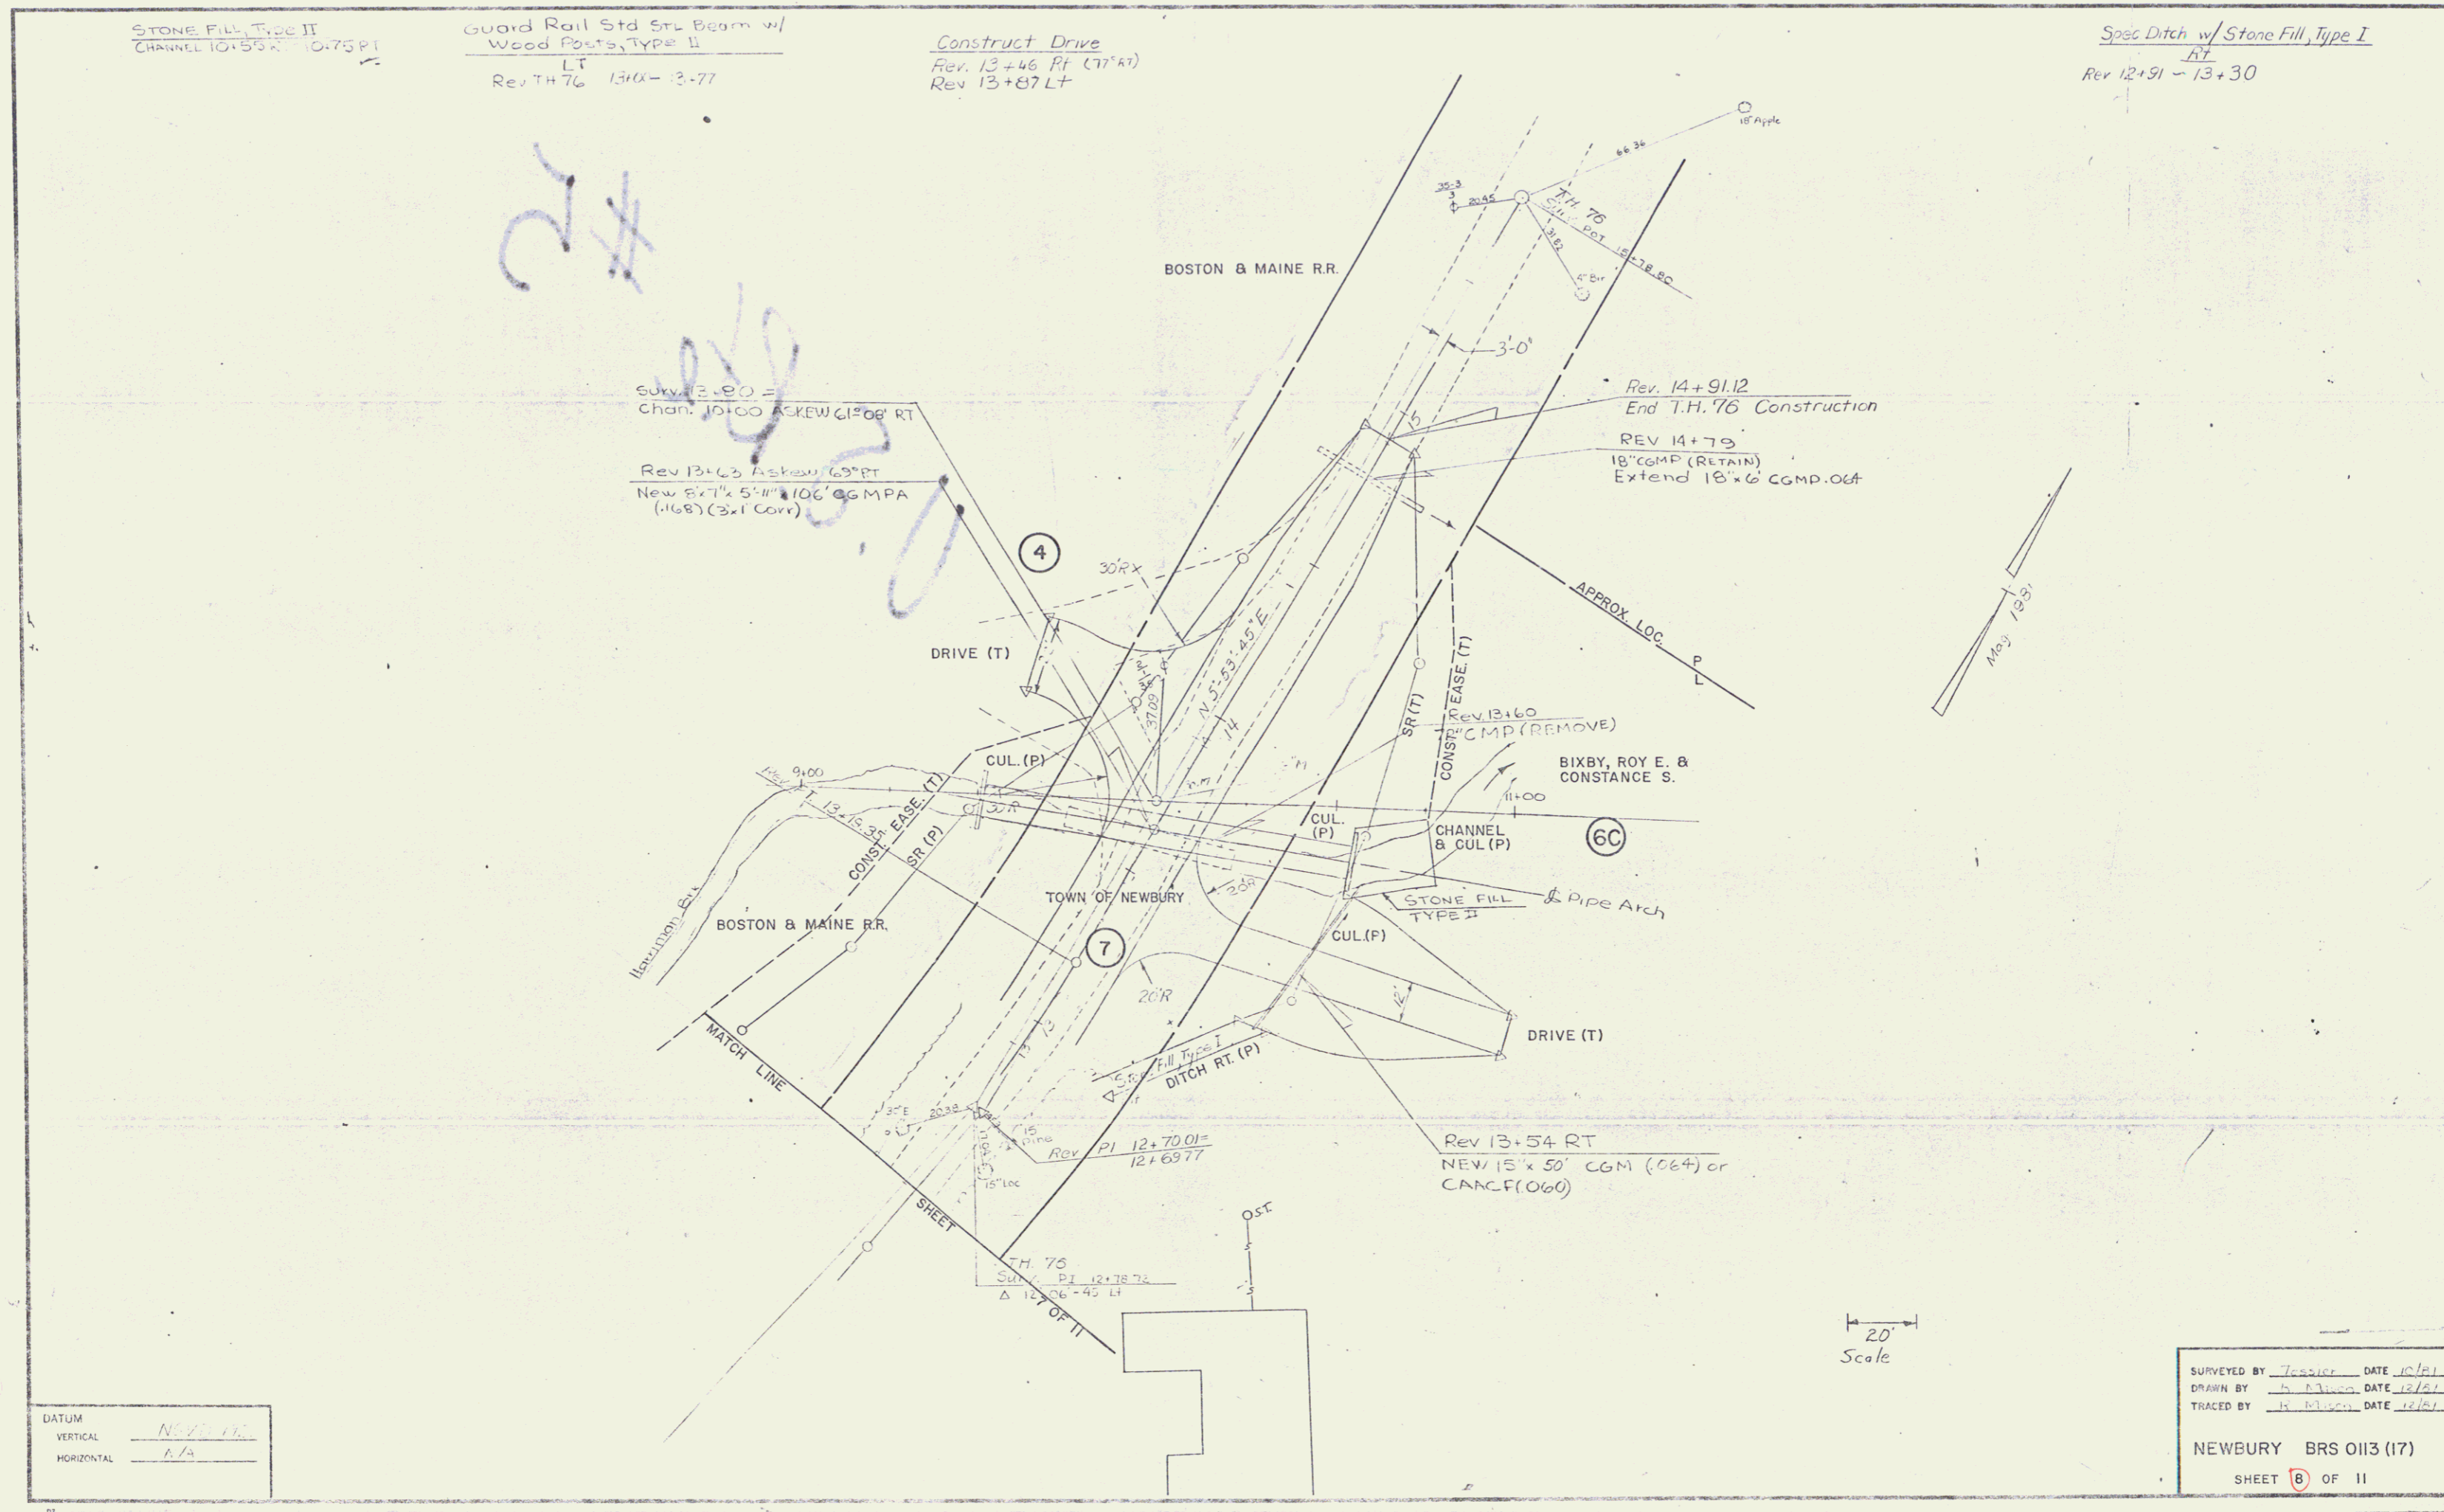

DATUM	NEW 113
VERTICAL	
HORIZONTAL	N/A

SURVEYED BY	Jessie	DATE	10/81
DRAWN BY	A. Blinn	DATE	10/81
TRACED BY	A. Blinn	DATE	10/81

NEWBURY BRS 0113 (17)
SHEET 8 OF 11