

PLAN

DATE: _____

BY: _____

CHECKED: _____

SCALE: _____

NOTE BOOK: _____

PROFILE


DATE: _____

BY: _____

CHECKED: _____

SCALE: _____

NOTE BOOK: _____

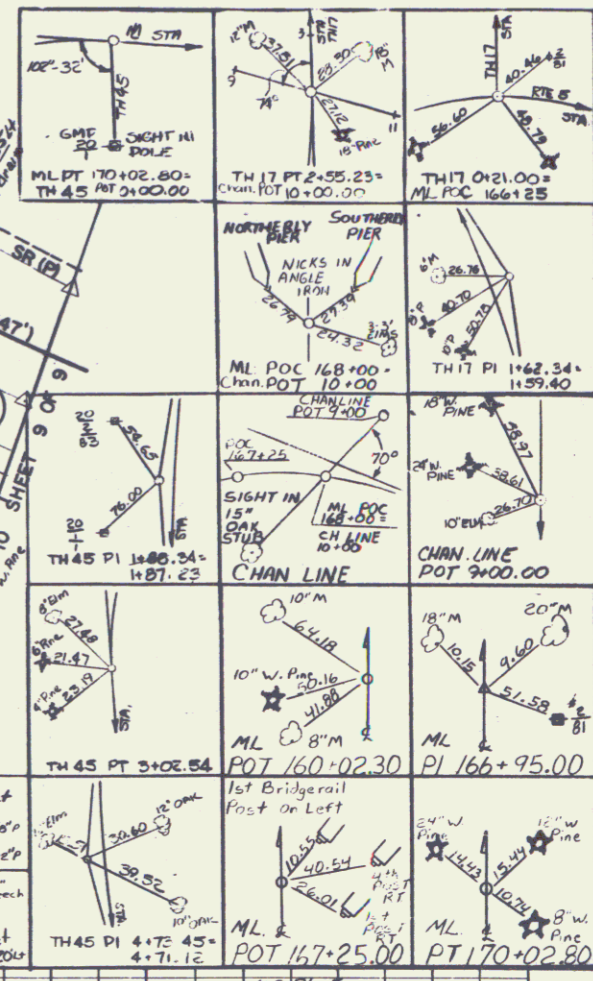

PUTNEY
BRS 0113(18)S
SHEET 6 OF 9