


STATE OF VERMONT
AGENCY OF TRANSPORTATION



PROPOSED IMPROVEMENT
TOWN OF ROYALTON
COUNTY OF WINDSOR
VT ROUTE 14

R.O.W. PLANS

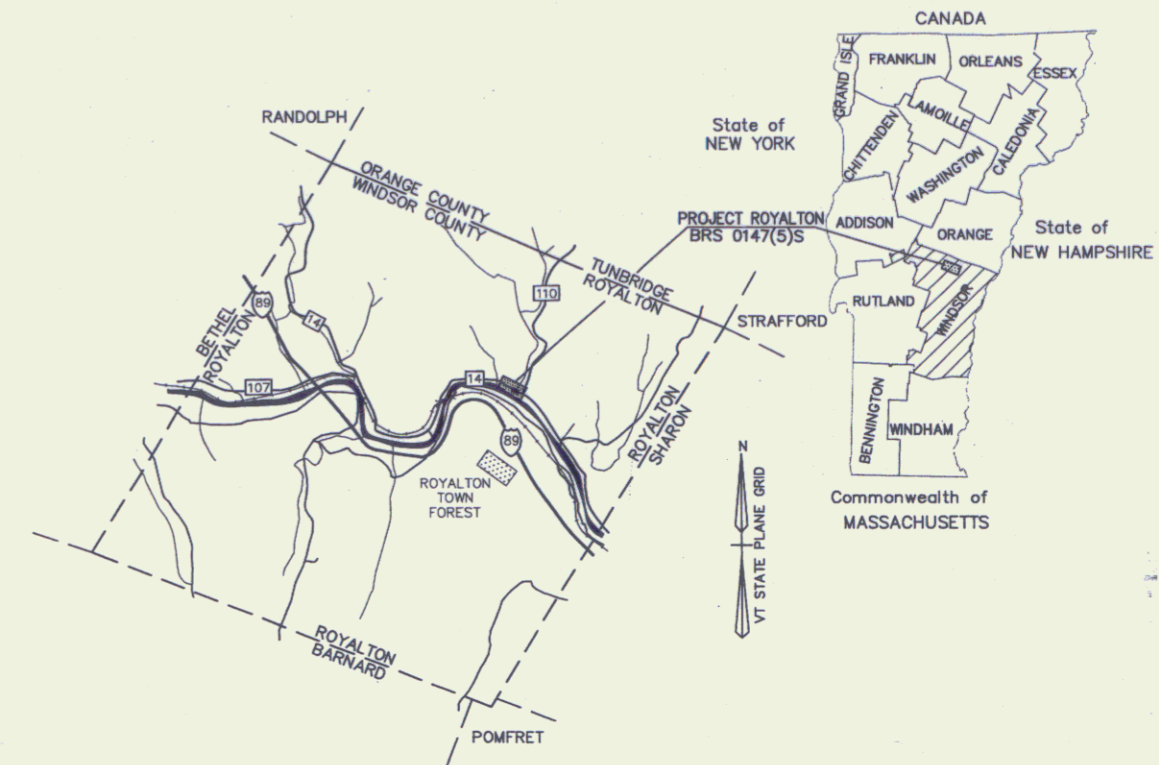


BEGIN R.O.W. PROJECT
BRS 0147(5)S REV. STA. 124+50 25' RT.

BEGINNING AT A POINT IN THE TOWN OF ROYALTON, ON VT ROUTE 14
APPROXIMATELY 200' NORTH OF THE INTERSECTION OF VT ROUTE 110, AND
EXTENDING NORTHWESTERLY ALONG VT ROUTE 14 FOR A DISTANCE OF 0.085 MILES.

LENGTH OF ROADWAY = 315.25 FEET = 0.060 MILES
LENGTH OF BRIDGE = 134.75 FEET = 0.026 MILES
LENGTH OF PROJECT = 450.00 FEET = 0.085 MILES
LENGTH OF R.O.W. PROJECT = 800.00 FEET = 0.151 MILES

WORK TO BE PERFORMED UNDER THIS PROJECT CONSISTS OF THE REPLACEMENT
OF EXISTING BRIDGE #21, ON VT ROUTE 14, INCLUDING ALL NECESSARY ROADWAY
APPROACH WORK.

END R.O.W. PROJECT
BRS 0147(5)S STA. REV. 132+50 25' LT.

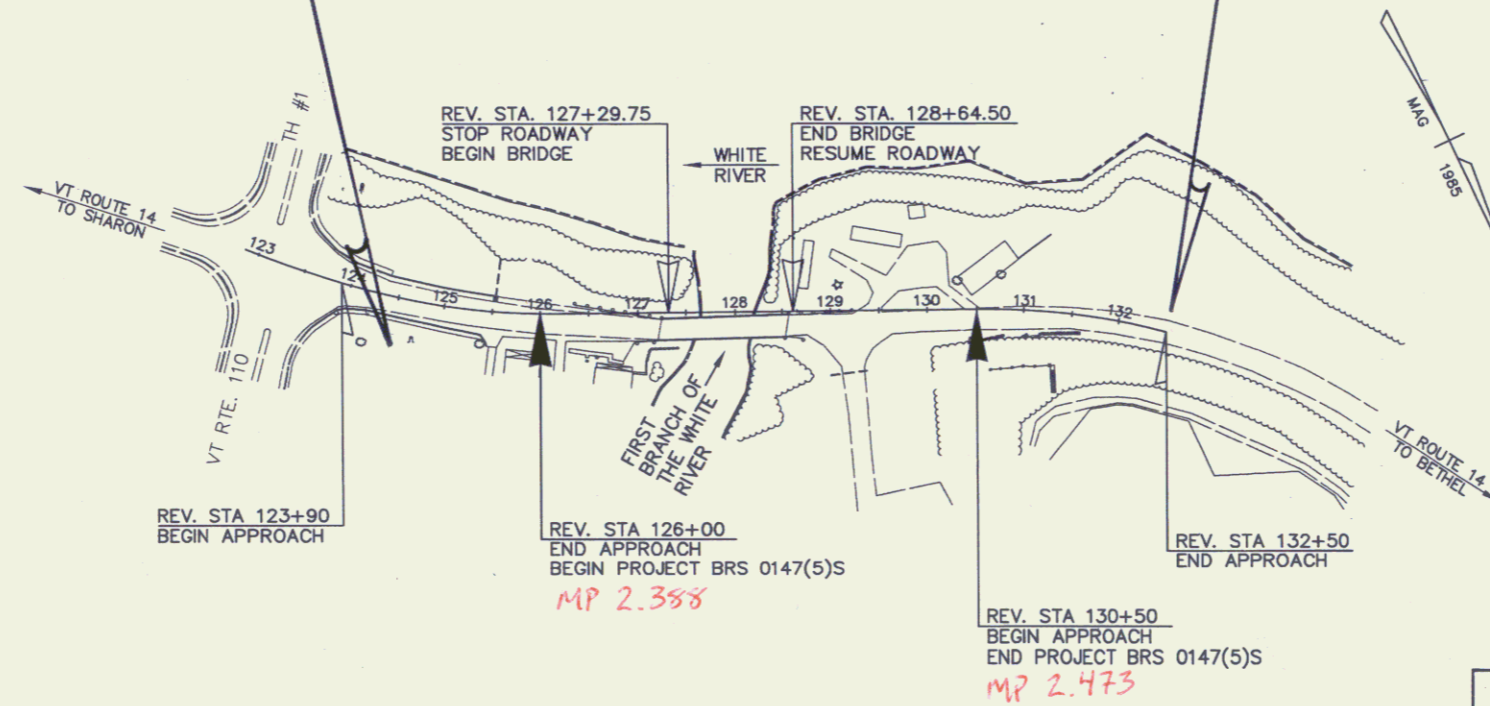

THE FOLLOWING RIGHT OF WAY PLAN SHEETS PERTAIN
DIRECTLY TO THE ACQUISITION OF LAND AND RIGHTS
NECESSARY TO CONSTRUCT THIS TRANSPORTATION
PROJECT. SHEETS REGARDING SPECIFIC CONSTRUCTION
DETAILS ARE NOT INCLUDED IN THIS RECORDED SET.

THESE PLANS ARE SUBJECT TO SUCH ENGINEERING
CHANGES AS MAY BE REQUIRED BY THE FEDERAL HIGHWAY
ADMINISTRATION OR THE CHIEF ENGINEER.
CONSTRUCTION IS TO BE CARRIED ON IN ACCORDANCE
WITH THESE PLANS AND THE STANDARD SPECIFICATIONS
FOR CONSTRUCTION DATED 1990, AS APPROVED BY THE
FEDERAL HIGHWAY ADMINISTRATION ON MARCH 15, 1990
FOR USE ON THIS PROJECT, INCLUDING ALL SUBSEQUENT
REVISIONS AND SUCH REVISED SPECIFICATIONS AND
SPECIAL PROVISIONS AS ARE INCORPORATED IN THESE
PLANS.

E:\Proj\90-94\91298.Royalton\Hwy\ACAD\91298COV 5-26-98 3:36:56 pm EST

CONVENTIONAL SIGNS	
COUNTY LINE	---
TOWN LINE	- - - -
LIMITS OF ACCESS	○ ○ ○ ○
POINT OF ACCESS	X
FENCE LINE	x x x x
STONE WALL	=====
TRAVELED WAY	=====
GUARDRAIL	=====
RAILROAD	=====
SURVEY LINE	=====
CULVERT	=====
POWER POLE	○
TELEPHONE POLE	◇
TREES	● ★
CONTROL OF ACCESS	///
PROPERTY LINE	=====
R.O.W. TAKING LINE	=====
SLOPE RIGHTS	SR
TOP OF CUT	△
TOE OF SLOPE	○

DATUM	
VERTICAL	NGVD 1929
HORIZONTAL	N/A



ALL DRIVES AS INDICATED ON PLANS
ARE SUBJECT TO PERMITS PURSUANT
TO TITLE 19 SECTION IIII, V.S.A.

Pin # 78F232

APPROVED *[Signature]* DATE 6/5/98
Director of Project Development

APPROVED *[Signature]* DATE
Chief, Right of Way

ROYALTON
BRS 0147(5)S
R.O.W. SHEET 1 OF 14 SHEETS