
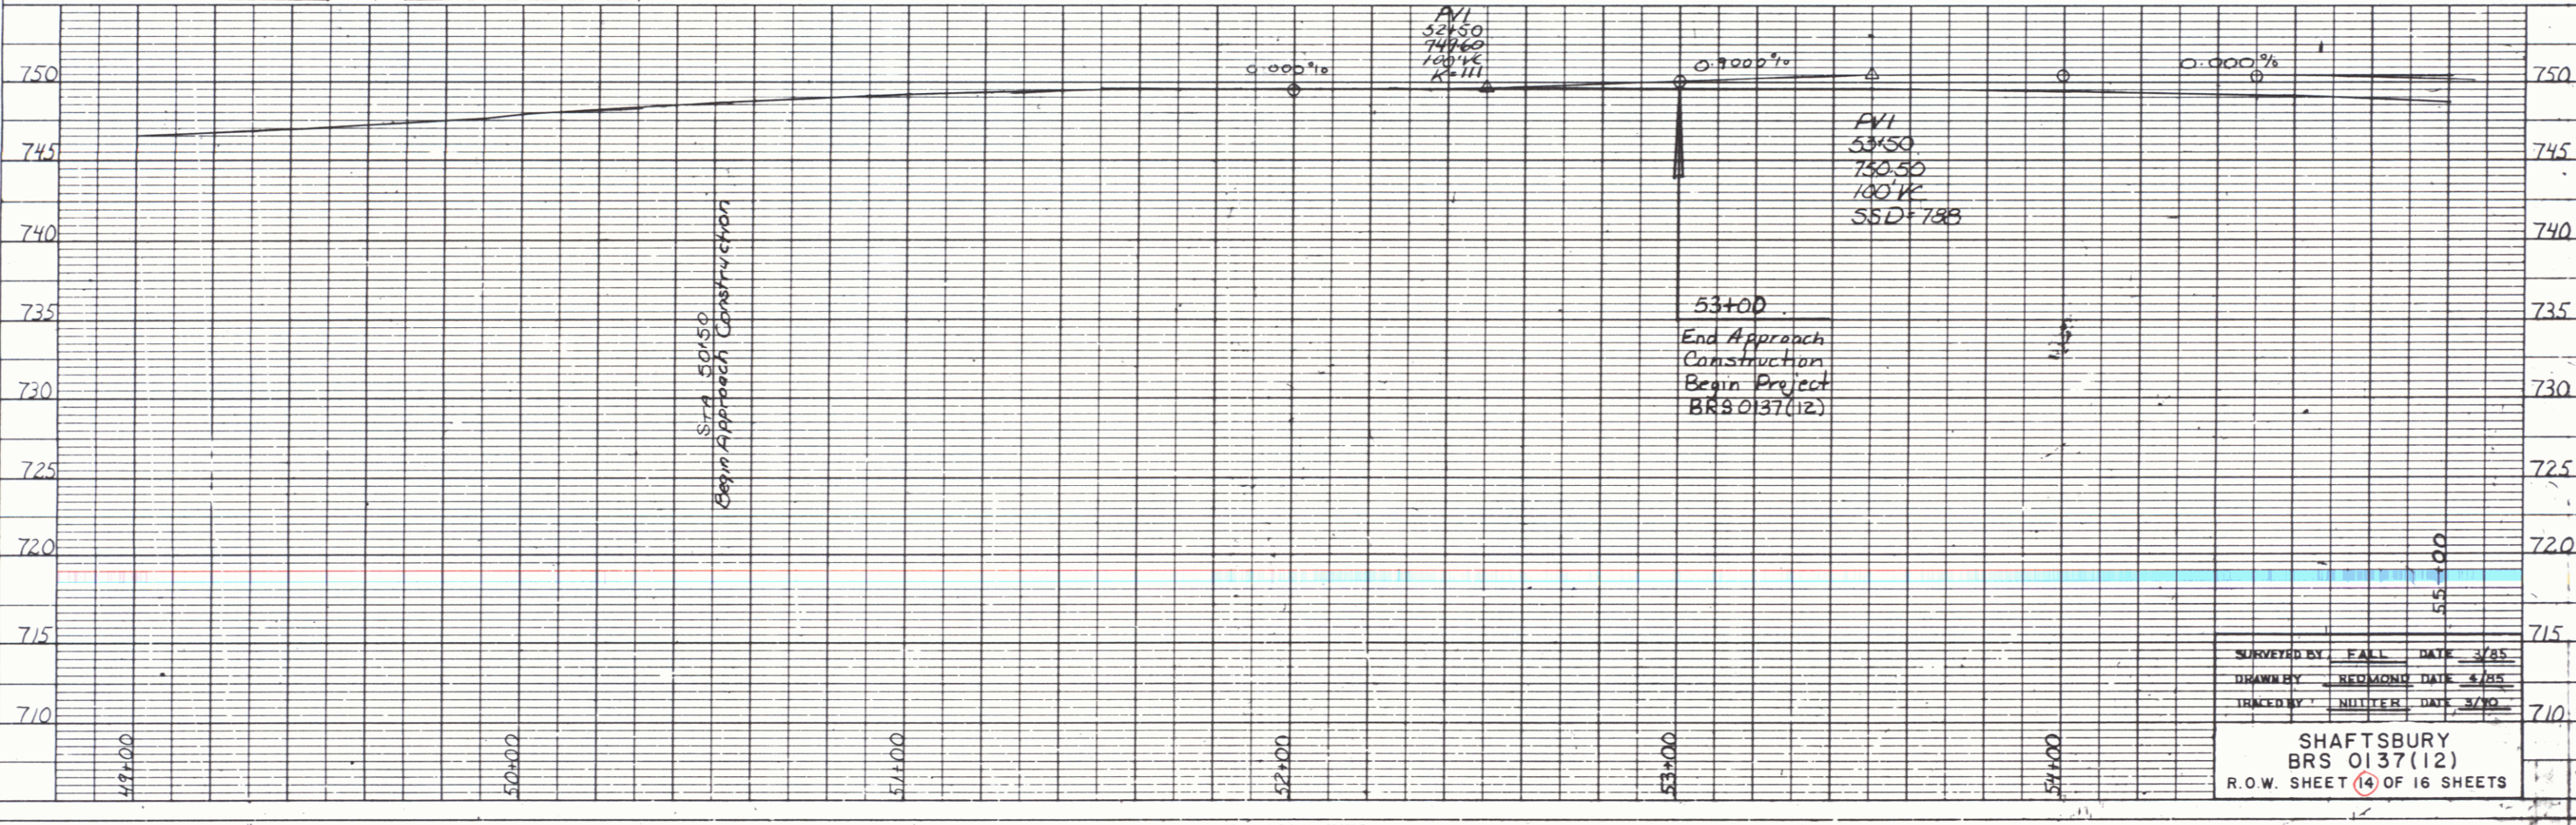


DATE: 3/24/85
 BY: J. J. BRUNING
 CHECKED: J. J. BRUNING
 DATE: 3/24/85
 DRAWING NO. 1113428

DATE: 3/24/85
 BY: J. J. BRUNING
 CHECKED: J. J. BRUNING
 DATE: 3/24/85
 DRAWING NO. 1113428

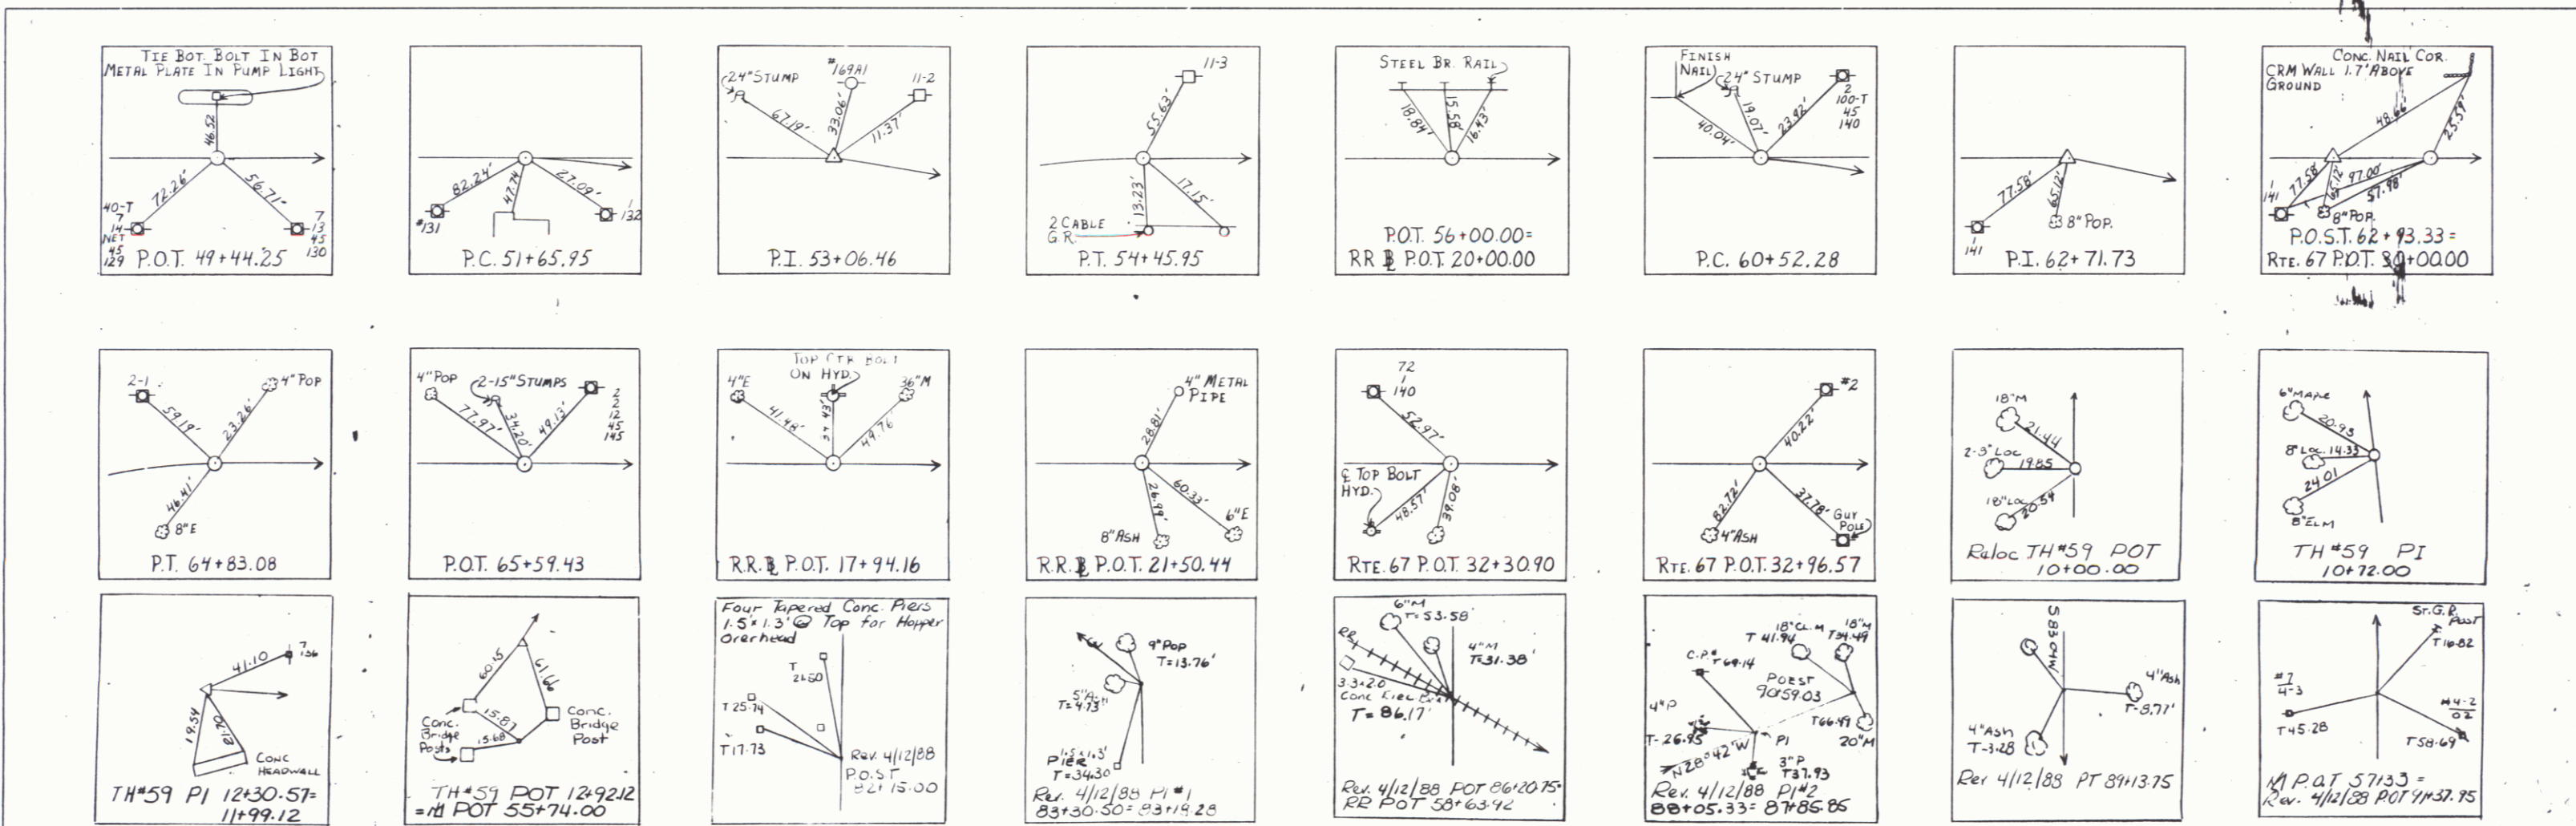

SURVEYED BY: FALL DATE: 3/85
 DRAWN BY: REDMOND DATE: 4/85
 TRACED BY: MILLER DATE: 3/85

SHAFTSBURY
 BRS 0137(12)
 R.O.W. SHEET (4) OF 16 SHEETS

PLATE 1 SINGLE PLAN - PROFILE
 CHARLES BRUNING CO.

DEC 2 1996