


TYPICAL SECTIONS

3" BITUMINOUS CONCRETE PAVEMENT (1 1/4" TYPE III OVER 1 3/4" TYPE II)
 3" BASE COURSE OF BITUMINOUS CONCRETE PAVEMENT (TYPE I, ONE LIFT)
 18" SUBBASE OF DENSE GRADED CRUSHED STONE

THICKNESSES 1-1/4" BITUMINOUS CONCRETE PAVEMENT
 3" GRANULAR BORROW OR FILL, } as indicated on the plans or
 6" SAND BORROW IN CUTS, } as directed by the Engineer

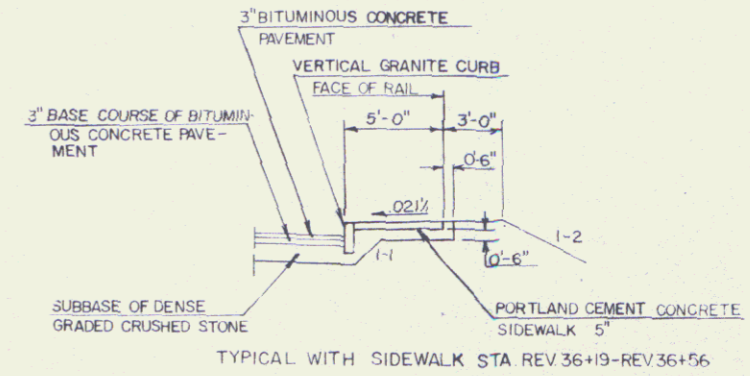

NOT USED ON PROJ. BRP 025-(24)



MATERIAL ITEM	THICKNESS TOLERANCE
PAVEMENT	± 1/4"
BASE COURSE	± 1/4"
SUBBASE	± 1"
GRANULAR BORROW	± 1"
SAND BORROW	± 1"

SEEDING FORMULA
URBAN AREAS

# FT	LBS/A	NAME	PUR %	GERM %
37.50	30	CREeping RED FESCUE (VARIETY PENNLAN)	98	85
31.25	25	KENTUCKY BLUEGRASS (COMMON)	85	75
31.25	25	PERENIAL RYE GRASS (VAR. PENNFIRE)	95	90
700.00	80			

THE SEED MIXTURE SHALL NOT HAVE A WEED CONTENT EXCEEDING 0.40% BY WEIGHT AND SHALL BE FREE FROM ALL NOXIOUS WEED SEED.

GENERAL NOTES

- SEED - To be applied per Seeding Formula as directed by the Engineer.
- FERTILIZER - Formula 10-20-10 to be used with seed, applied at the rate of 500 lbs /Acre.
- AGRICULTURAL LIMESTONE - To be applied at the rate of 2 tons /Acre or as directed by the Engineer.
- HAY MULCH - To be placed on earth slopes at the rate of 2 tons /Acre.
- TOPSOIL - To be used with seed as indicated on the plans or as directed by the Engineer.
- MARKER POSTS - (Wood or Steel, as specified) - To be placed as directed by the Engineer.
- SLOPE ROUNDING - All cut slopes to be rounded in accordance with Standard Sheet B-5.
- PAY LIMITS OF SAND BORROW WHEN USED IN CONJUNCTION WITH UNDERDRAIN - See Standard Sheet D-2.

TYPICAL SECTIONS FOR
VT. RTE. 103

PROJECT SHREWSBURY

NO. BRP 025-(24)

SHEET 2 OF 9 SHEETS

AUG 24 1981

2