


INDEX OF SHEETS  
 1 TITLE SHEET  
 2 INDEX OF SHEETS

STATE OF VERMONT  
 AGENCY OF TRANSPORTATION



PROPOSED IMPROVEMENT  
 TOWN OF TOWNSHEND  
 COUNTY OF WINDHAM  
 VT ROUTE 30 (F.A.P.)

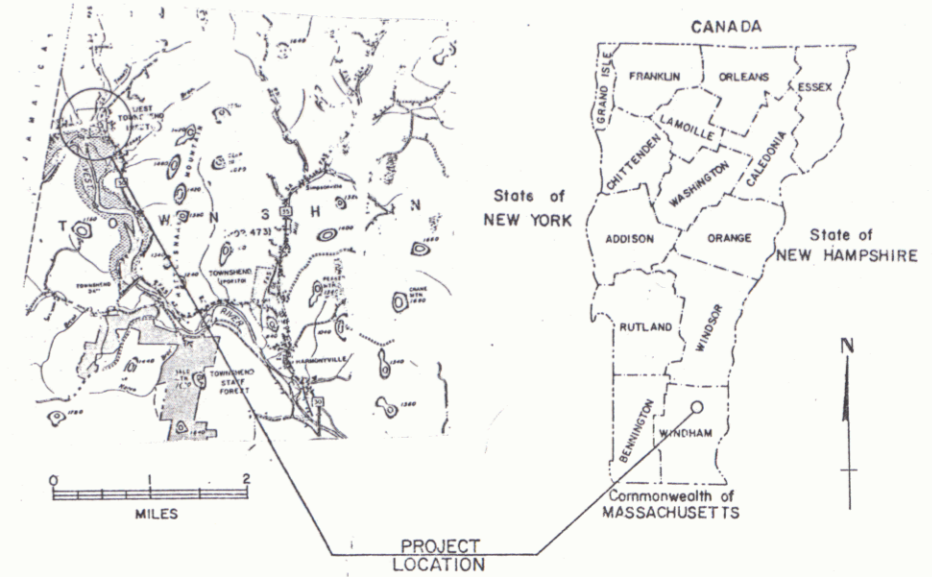

RECORD PLANS  
 CONTRACTOR MILLER Const. Co.  
 Windsor, VT  
 RESIDENT ENGINEER LEON TESSIER  
 CONSTRUCTION BEGAN 7/24/1990  
 CONSTRUCTION COMPLETED 11/28/91  
 RECORD PLANS BY J. Marzocelli  
 I hereby certify that all the construction required by this set of drawings has been accomplished as indicated herein.  
 By Leon Tessier Resident Engineer  
 Date Mar 25 1992  
 NOTE: Any further information concerning final quantities, amounts or other details relative to this project may be found on microfilm in Central Files.  
Town of 9-A BRF

BEGINNING AT A POINT 0.918 MILES EASTERLY OF THE JAMAICA-TOWNSHEND TOWN LINE AND CONTINUING WESTERLY ON VT. ROUTE 30 FOR A DISTANCE OF 600.00 FEET.

LENGTH OF ROADWAY 600.00 FEET = 0.114 MILES  
 LENGTH OF BRIDGE 0.00 FEET = 0.000 MILES  
 LENGTH OF PROJECT 600.00 FEET = 0.114 MILES



WORK TO BE PERFORMED UNDER THIS PROJECT CONSISTS OF REPLACEMENT OF AN EXISTING BRIDGE AS WELL AS RECONSTRUCTION OF THE APPROACHES.

CONSTRUCTION  
 PLANS

TRAFFIC DATA  
 1990 ADT = 2670  
 2010 ADT = 3630  
 2010 DHV = 505  
 D = 53%  
 T = 4%  
 V = 35 MPH

- CONVENTIONAL SIGNS
- COUNTY LINE
  - TOWN LINE
  - LIMITS OF ACCESS
  - POINT OF ACCESS
  - FENCE LINE
  - STONE WALL
  - TRAVELED WAY
  - GUARD RAIL
  - RAILROAD
  - SURVEY LINE
  - CULVERT
  - POWER POLE
  - TELEPHONE POLE
  - TREES
  - CONTROL OF ACCESS
  - PROPERTY LINE
  - ROW TAKING LINE
  - SLOPE RIGHTS
  - TOP OF CUT
  - TOE OF SLOPE

DATUM  
 VERTICAL NGVD 1929  
 HORIZONTAL N/A

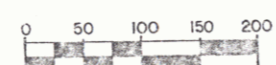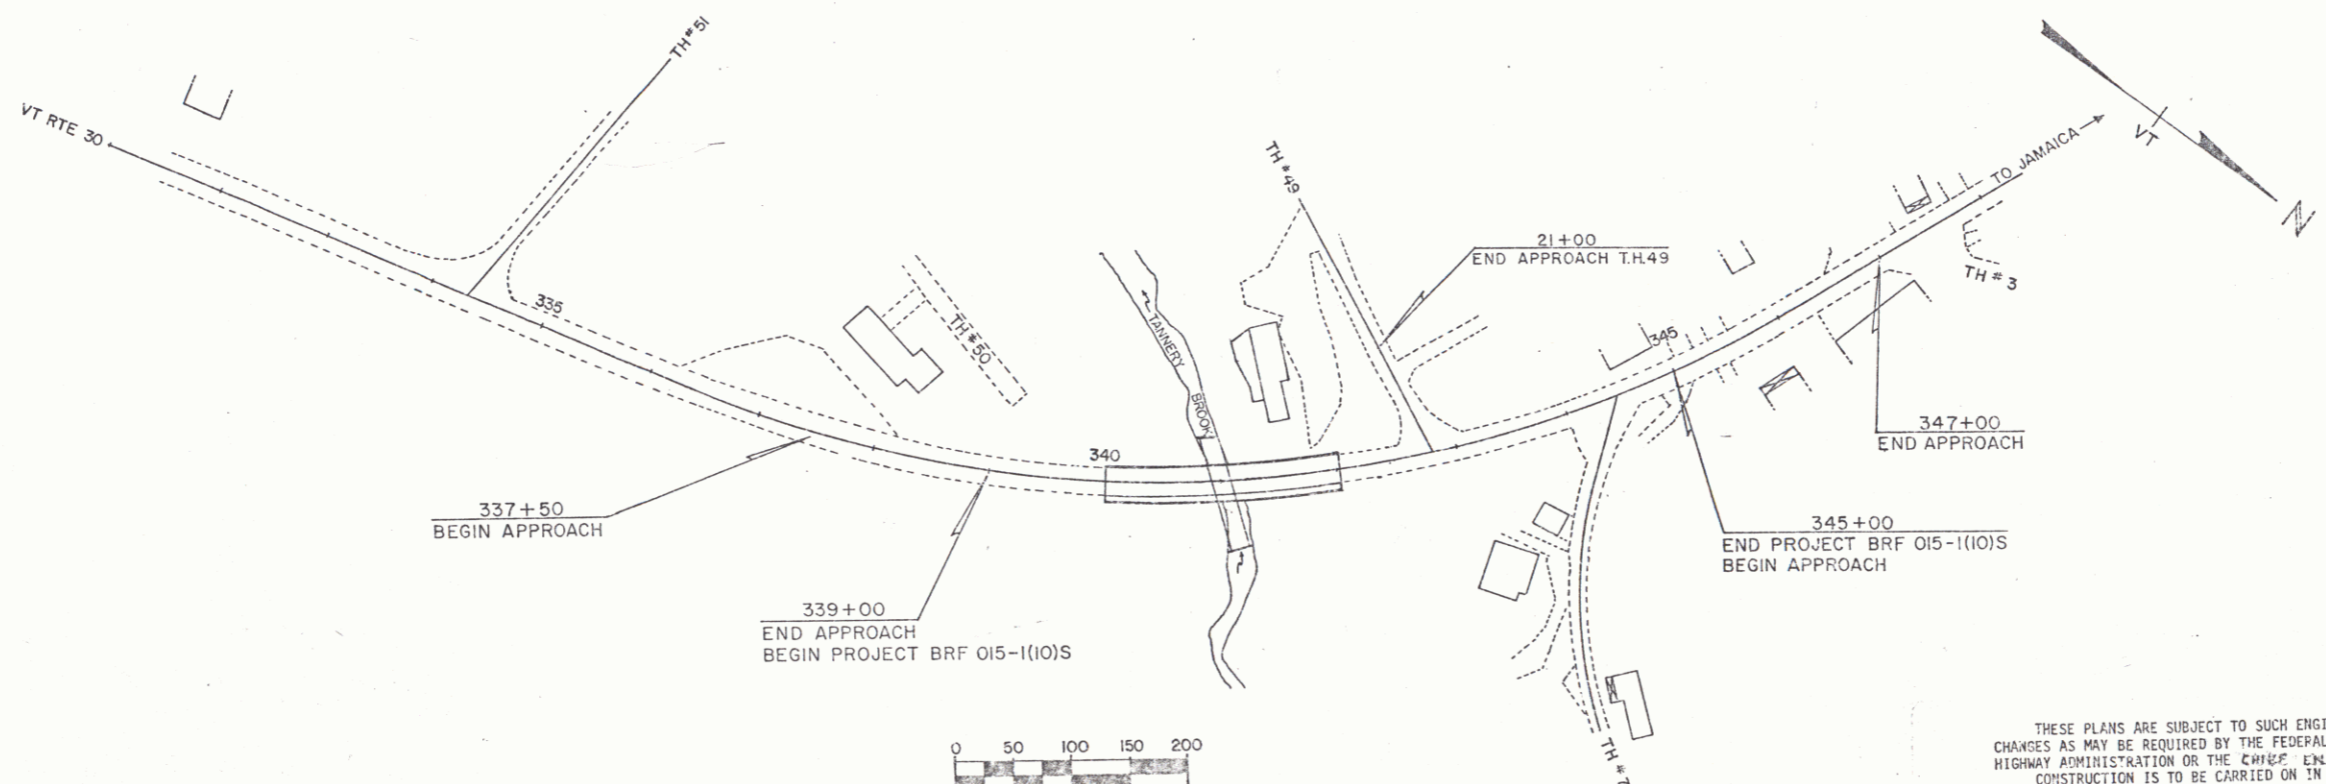

RIGHT-OF-WAY DIVISION  
 TOWN FILE  
 PERPETUAL  
 Town of TOWNSHEND  
 (To Be Returned To R.O.W. Division)

THESE PLANS ARE SUBJECT TO SUCH ENGINEERING CHANGES AS MAY BE REQUIRED BY THE FEDERAL HIGHWAY ADMINISTRATION OR THE CHIEF ENGINEER. CONSTRUCTION IS TO BE CARRIED ON IN ACCORDANCE WITH THESE PLANS AND THE STANDARD SPECIFICATIONS FOR CONSTRUCTION DATED 1986. FOR USE ON THESE PROJECTS, INCLUDING ALL SUBSEQUENT PROVISIONS AS ARE INCORPORATED IN THESE PLANS.

SUBMITTED BY ORDER OF THE STATE TRANSPORTATION BOARD  
 APPROVED Scott M. White DATE 5/1/92  
 DIRECTOR OF PLANNING AND PRECONSTRUCTION  
 DEPARTMENT OF TRANSPORTATION  
 FEDERAL HIGHWAY ADMINISTRATION  
 APPROVED George A. Jones DATE 6/1/90  
 DIVISION ADMINISTRATOR  
 TOWNSHEND  
 PROJECT BRF # 015-1(10) C/2  
 SHEET 1 OF 11 SHEETS  
 D-10 S.R.S. 12/17/70