


PLAN  
 SURVEYED  
 PLANNED  
 CHECKED  
 DATE  
 NO.

PROFILE  
 DESIGNED  
 CHECKED  
 DATE  
 NO.

TYPICAL SECTION T.H. No. 49

1 1/2" (± 1/4") BITUMINOUS CONCRETE PAVEMENT ITEM 406.25, TYPE III  
 12" (± 1") SUBBASE OF CRUSHED GRAVEL, COARSE GRADED ITEM 301.25

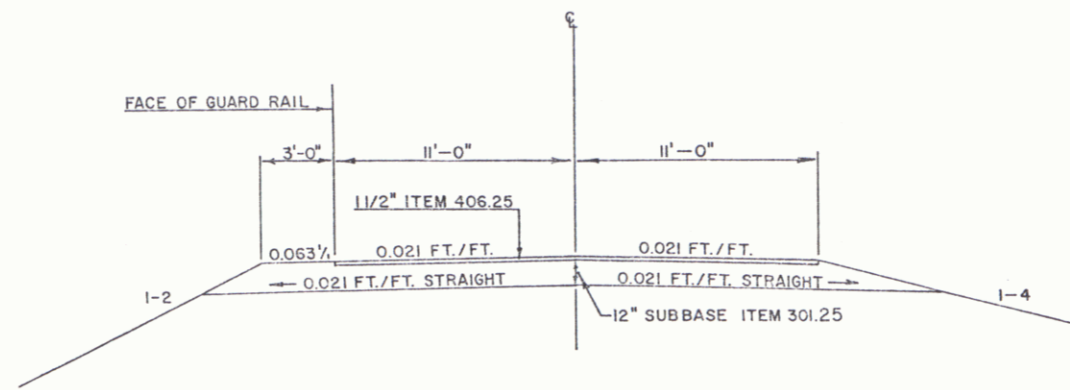

NORMAL SECTION  
 STA. 20+50

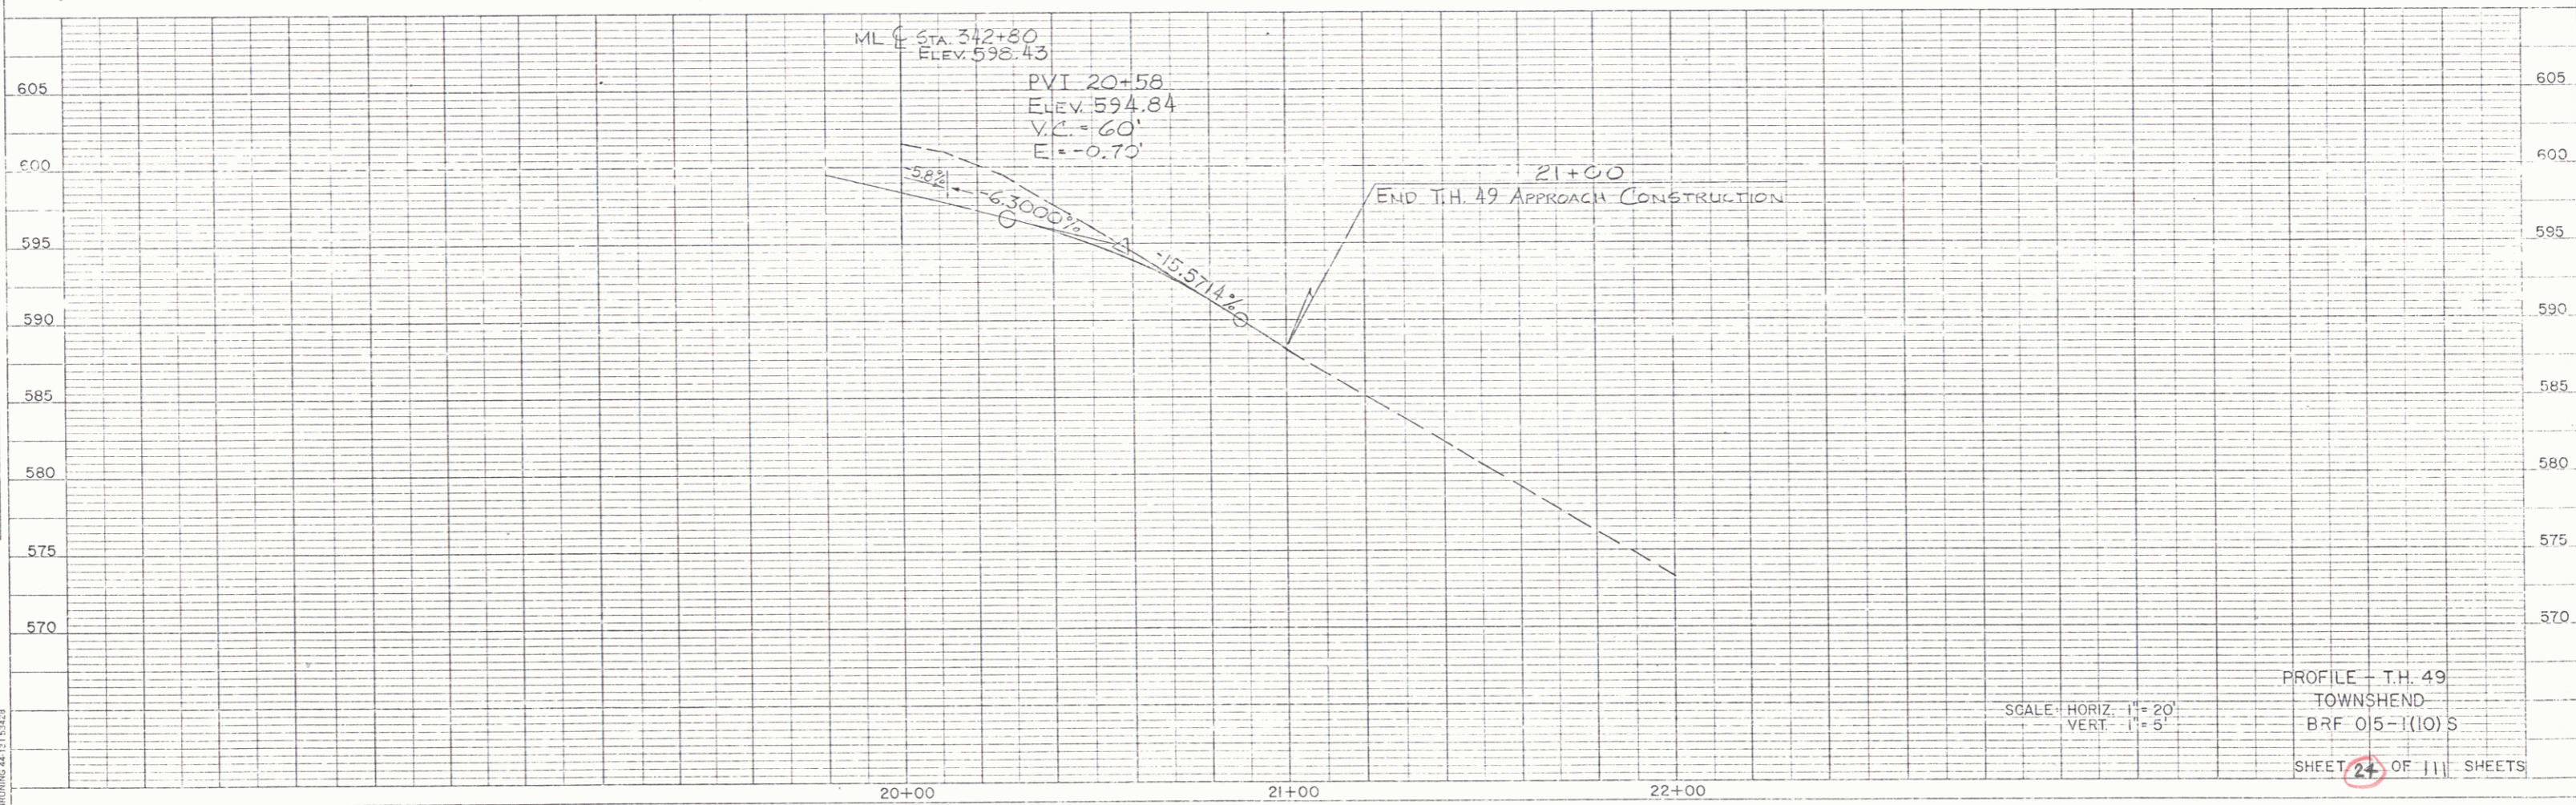


PLATE 1 SINGLE PLAN - PROFILE  
 CHARLES E. ERUNING CO.  
 MADE IN U.S.A.