


Scanned 11-13-01 H20 RESEARCH COPY

# STATE OF VERMONT AGENCY OF TRANSPORTATION




## PROPOSED IMPROVEMENT TOWN OF WOODSTOCK COUNTY OF WINDSOR VT. RTE. 106 (FAS)

BEGINNING AT A POINT APPROXIMATELY 3.72 MILES NORTH OF THE READING-WOODSTOCK TOWN LINE AND EXTENDING NORTHERLY 1250 FEET.  
LENGTH OF ROADWAY 1156.72 FEET= 0.219 MILES.  
LENGTH OF BRIDGES 93.28 FEET= 0.018 MILES.  
LENGTH OF PROJECT 1250 FEET= 0.237 MILES.  
WORK TO BE PERFORMED UNDER THIS PROJECT CONSISTS OF REHABILITATION OF BRIDGE NO. 27 AND 28 BY WIDENING AND ALSO WIDENING THE EXISTING HIGHWAY ON BOTH SIDES OF EACH BRIDGE.  
LENGTH OF R.O.W. PROJECT 1500.00 FEET= 0.284 MILES

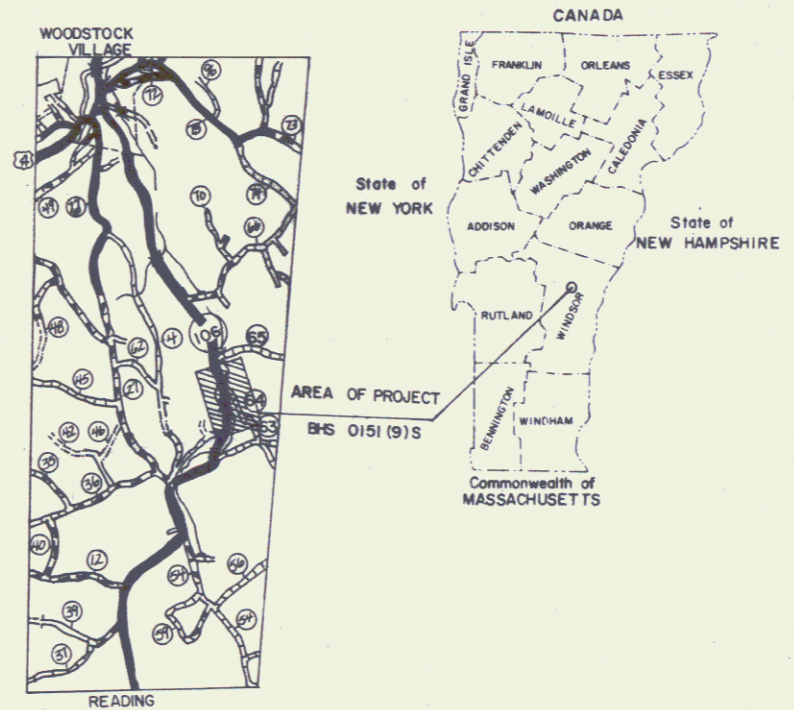

R.O.W. PLANS

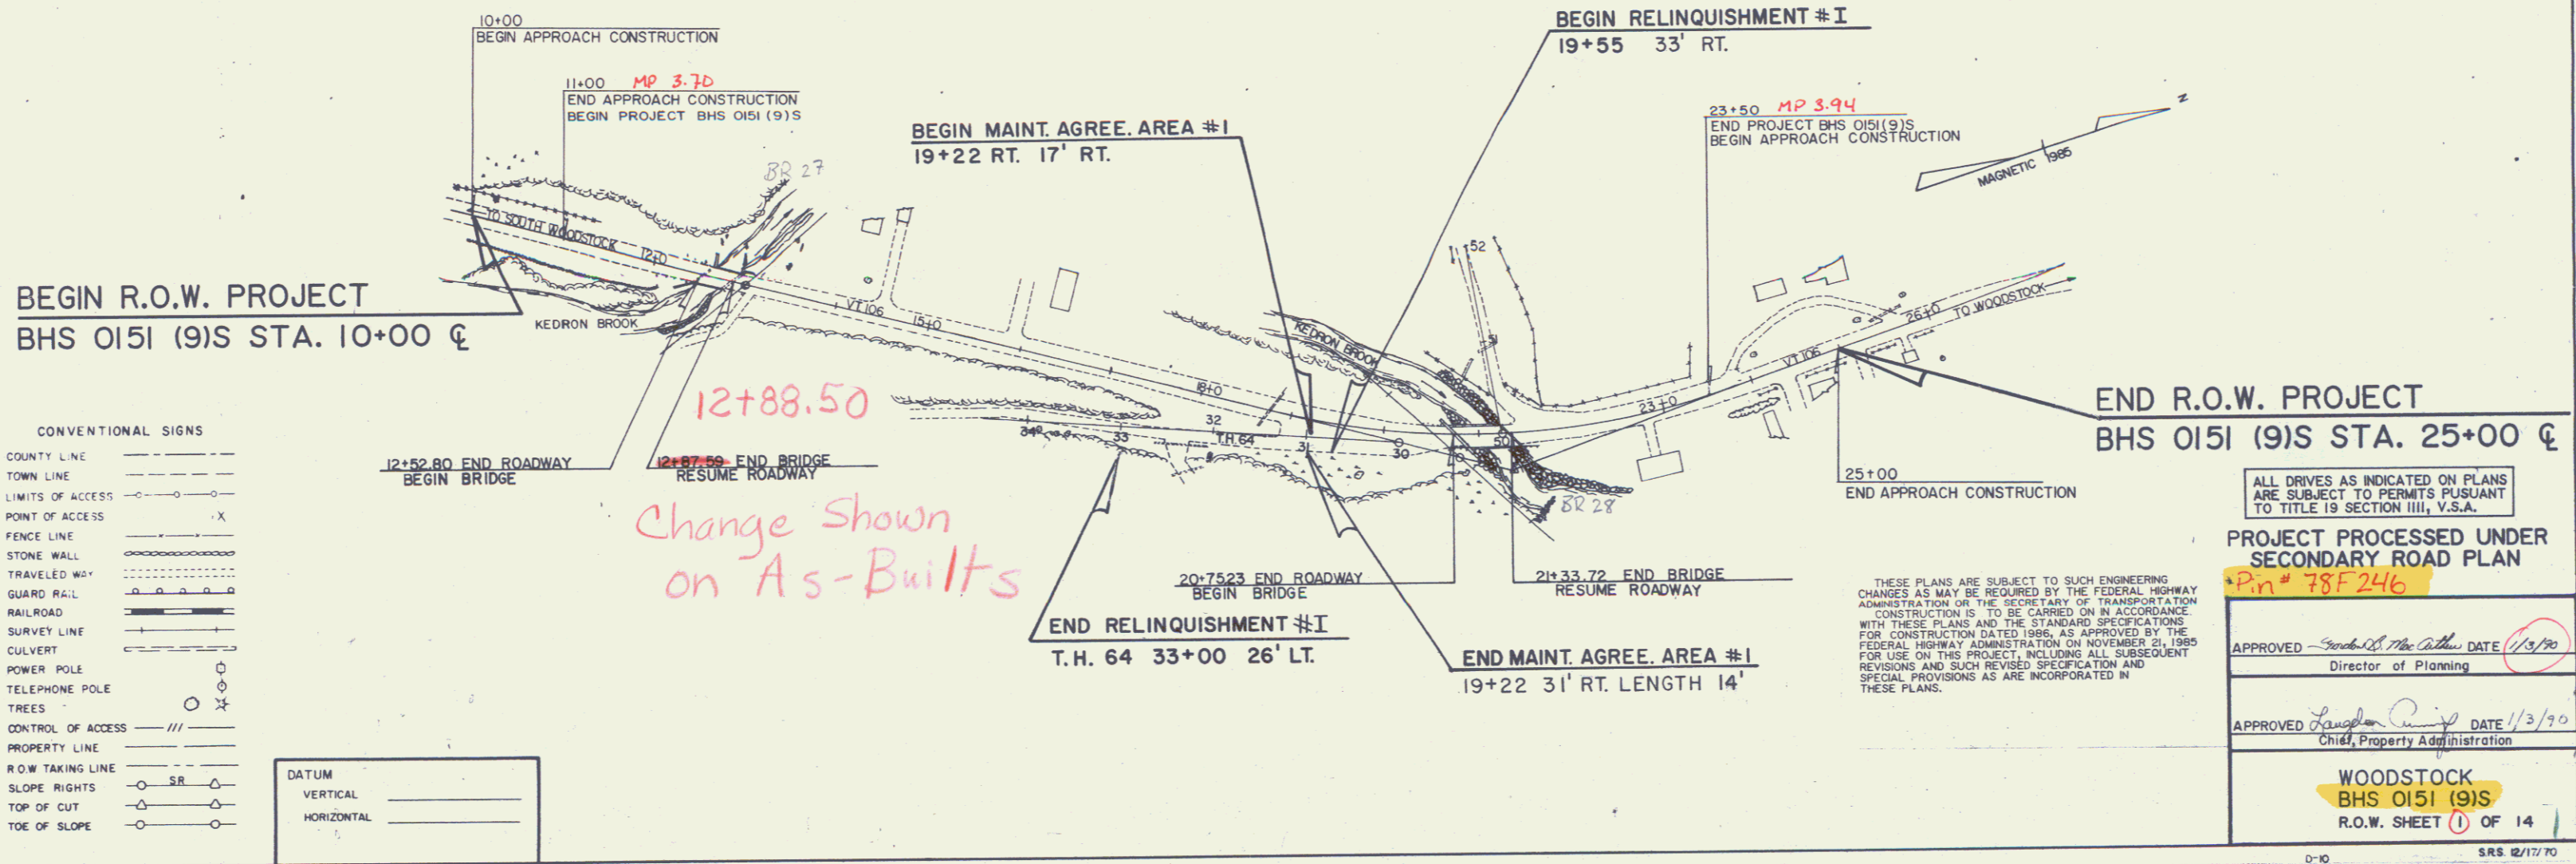

CONVENTIONAL SIGNS

COUNTY LINE	---
TOWN LINE	- - - -
LIMITS OF ACCESS	○—○
POINT OF ACCESS	X
FENCE LINE	— · — · —
STONE WALL	— · — · — · —
TRAVELED WAY	— · — · — · — · —
GUARD RAIL	— · — · — · — · — · —
RAILROAD	— · — · — · — · — · — · —
SURVEY LINE	— · — · — · — · — · — · — · —
CULVERT	— · — · — · — · — · — · — · — · —
POWER POLE	○
TELEPHONE POLE	○
TREES	○ X
CONTROL OF ACCESS	— · — · — · — · — · — · — · — · —
PROPERTY LINE	— · — · — · — · — · — · — · — · —
R.O.W. TAKING LINE	— · — · — · — · — · — · — · — · —
SLOPE RIGHTS	○ SR ○
TOP OF CUT	○
TOE OF SLOPE	○

DATUM

VERTICAL	_____
HORIZONTAL	_____

THESE PLANS ARE SUBJECT TO SUCH ENGINEERING CHANGES AS MAY BE REQUIRED BY THE FEDERAL HIGHWAY ADMINISTRATION OR THE SECRETARY OF TRANSPORTATION CONSTRUCTION IS TO BE CARRIED ON IN ACCORDANCE WITH THESE PLANS AND THE STANDARD SPECIFICATIONS FOR CONSTRUCTION DATED 1986, AS APPROVED BY THE FEDERAL HIGHWAY ADMINISTRATION ON NOVEMBER 21, 1985 FOR USE ON THIS PROJECT, INCLUDING ALL SUBSEQUENT REVISIONS AND SUCH REVISED SPECIFICATION AND SPECIAL PROVISIONS AS ARE INCORPORATED IN THESE PLANS.

ALL DRIVES AS INDICATED ON PLANS ARE SUBJECT TO PERMITS PUSUANT TO TITLE 19 SECTION III, V.S.A.

PROJECT PROCESSED UNDER SECONDARY ROAD PLAN  
\*P.n# 78F246

APPROVED *[Signature]* DATE 1/19/90  
Director of Planning

APPROVED *[Signature]* DATE 1/3/90  
Chief, Property Administration

WOODSTOCK  
BHS 0151 (9)S  
R.O.W. SHEET 1 OF 14

D-10 SRS 12/17/70