
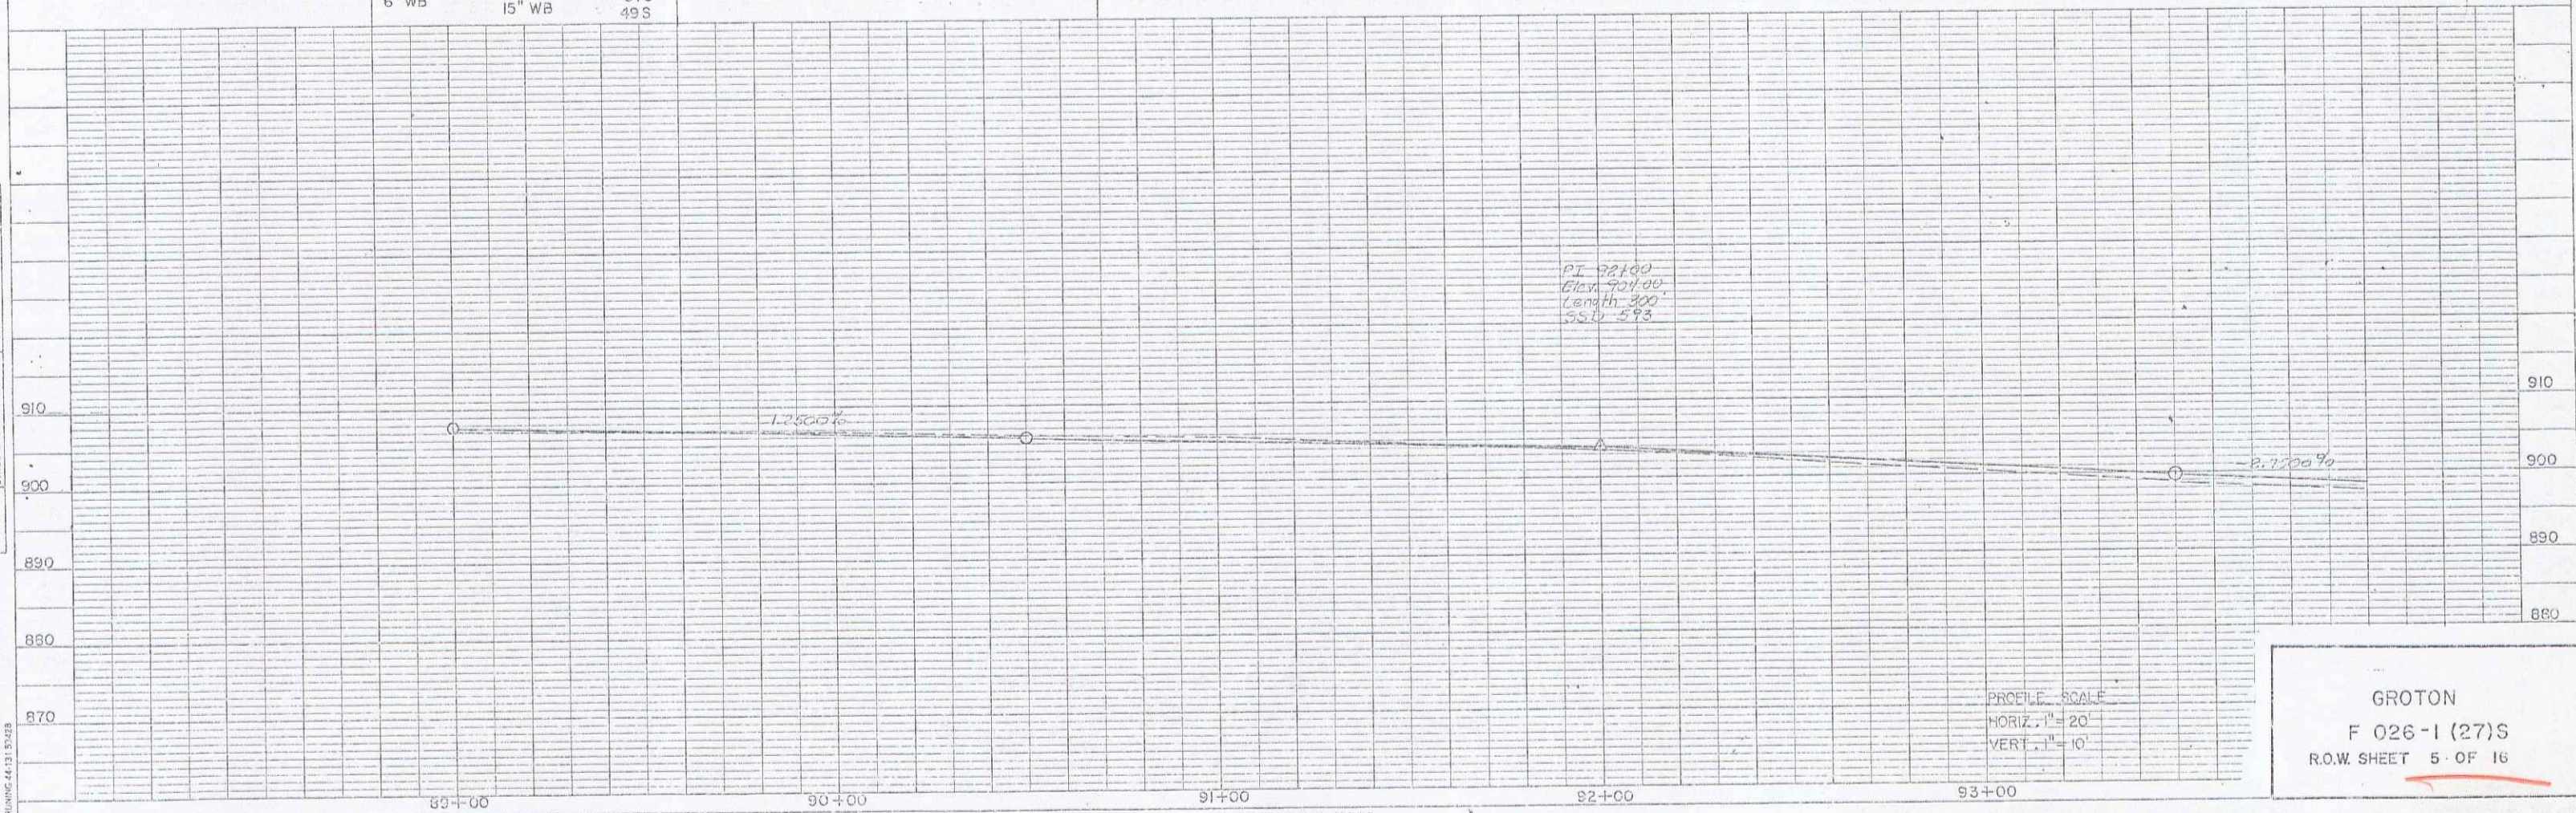


DATE	
SCALE	
PROJECT	
DATE	
SCALE	
PROJECT	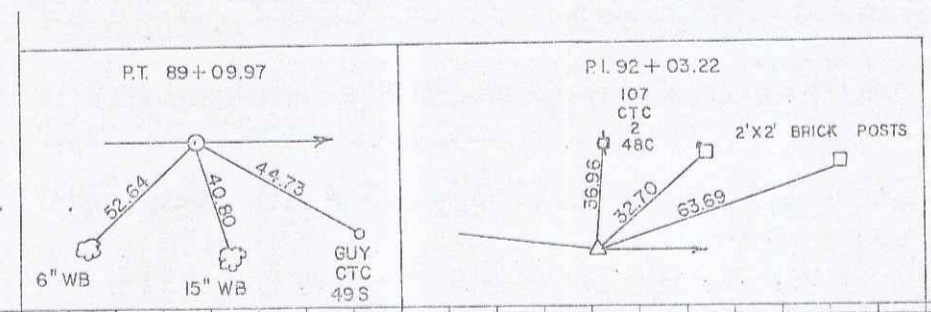
PROFILE SCALE
 HORIZ. 1" = 20'
 VERT. 1" = 10'

GROTON
 F 026-1 (27)S
 R.O.W. SHEET 5 OF 16

PLANNED ENGINEERING PROFILE
 CHARLES GRADING CO.
 BOSTON, MASS.

FEB 05 1992

5