

INDEX OF SHEETS
 1. TITLE SHEET
 2. INDEX OF SHEETS

RECORD PLANS

CONTRACTOR: EARTH CONSTRUCTION, INC.

RESIDENT ENGINEER: ARWALD D. GRAY

CONSTRUCTION BEGAN: MARCH 30, 1990
 CONSTRUCTION COMPLETED: MARCH 6, 1991

RECORD PLANS BY: RICHARD P. RUSSELL, JR.

I hereby certify that all the construction required by this set of drawings has been accomplished as indicated herein.

By: *Richard P. Russell, Jr.* Resident Engineer

Date: 10-25-91

NOTE: Any further information concerning final quantities, amounts or other details relative to this project may be found on microfilm in Central Files.

STATE OF VERMONT
 AGENCY OF TRANSPORTATION




PROPOSED IMPROVEMENT
 TOWN OF GROTON
 COUNTY OF CALEDONIA
 U.S. RTE 302 FAP
 BARRE - WELLS RIVER ROAD

BEGINNING AT A POINT APPROXIMATELY 4.657 MILES
 EASTERLY OF THE TOPSHAM-GROTON TOWN LINE AND
 EXTENDING 0.322 MILES EASTERLY.


WORK TO BE PERFORMED UNDER THIS PROJECT CONSISTS
 OF REPLACEMENT OF EXISTING BRIDGE AND
 RECONSTRUCTION OF ROADWAY.

LENGTH OF ROADWAY 1633.56 FEET 0.309 MILES
 LENGTH OF BRIDGE 64.44 FEET 0.013 MILES
 LENGTH OF PROJECT 1700.00 FEET 0.322 MILES

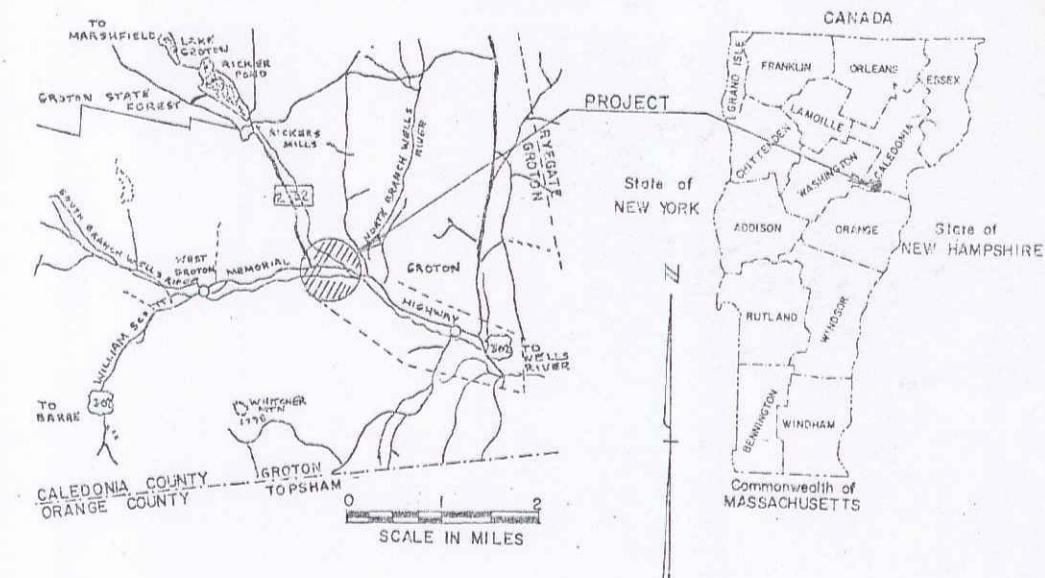

**CONSTRUCTION
 PLANS**

EST. 1989 ADT = 2100
 EST. 2009 ADT = 2980
 DHV = 420
 D = 5%
 T = 5% (OF DHV)
 V = 50 MPH

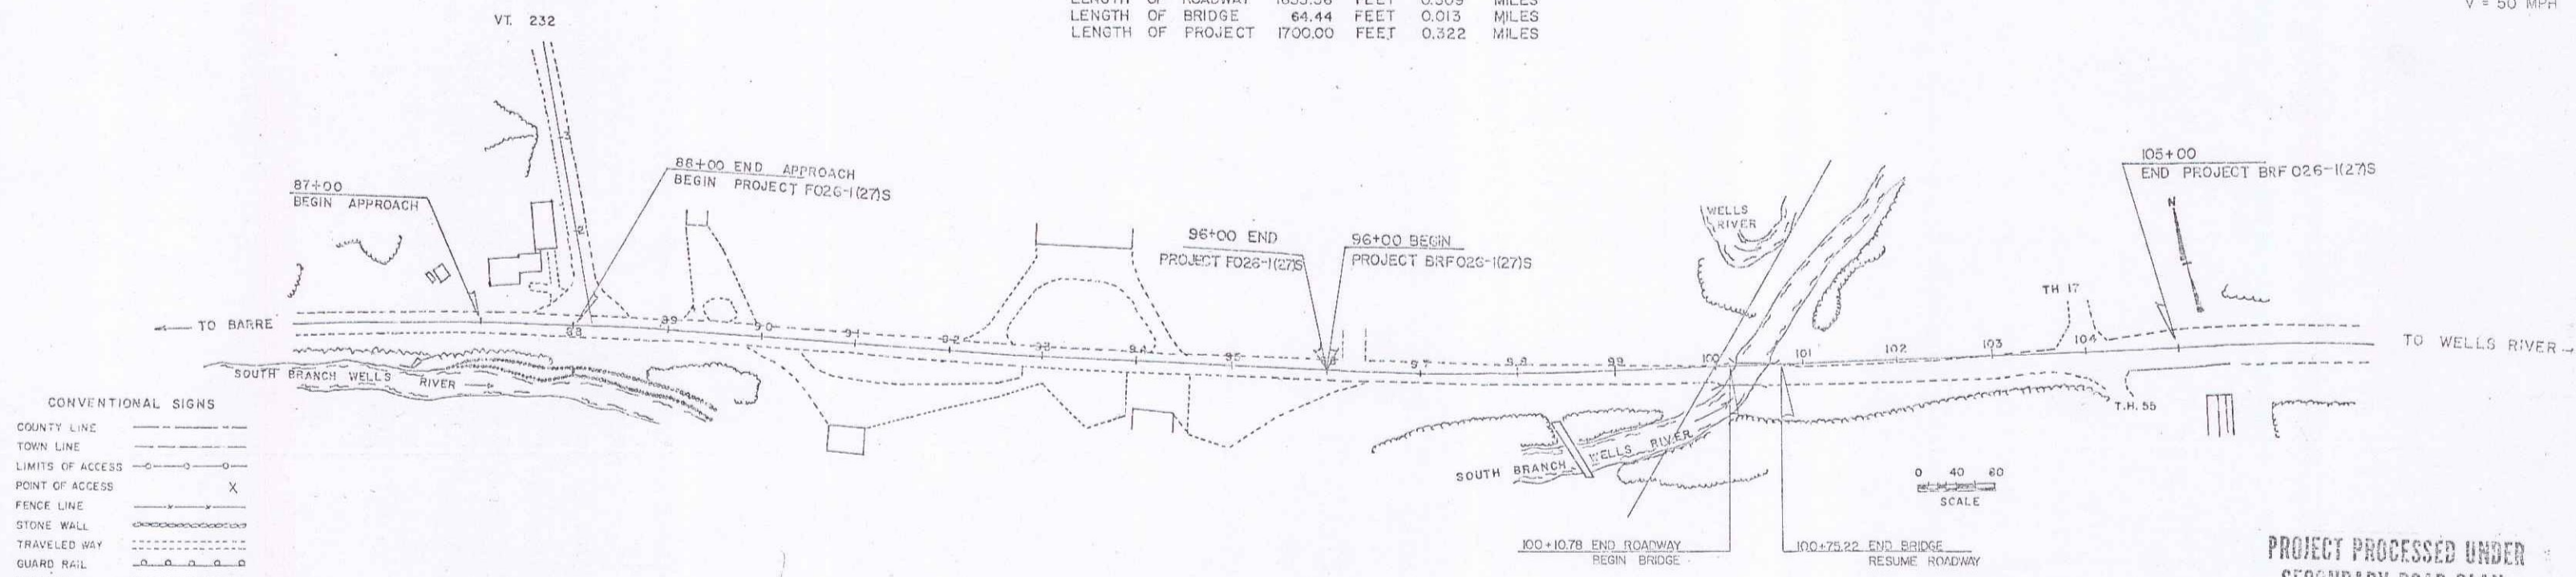

- CONVENTIONAL SIGNS
- COUNTY LINE
 - TOWN LINE
 - LIMITS OF ACCESS
 - POINT OF ACCESS
 - FENCE LINE
 - STONE WALL
 - TRAVELED WAY
 - GUARD RAIL
 - RAILROAD
 - SURVEY LINE
 - CULVERT
 - POWER POLE
 - TELEPHONE POLE
 - TREES
 - CONTROL OF ACCESS
 - ROW TAKING LINE
 - SLOPE RIGHTS
 - CUT
 - TOE OF SLOPE

DATUM
 VERTICAL: NGVD 1929
 HORIZONTAL: N/A

THESE PLANS ARE SUBJECT TO SUCH ENGINEERING
 CHANGES AS MAY BE REQUIRED BY THE FEDERAL
 HIGHWAY ADMINISTRATION OR THE CHIEF ENGINEER.
 CONSTRUCTION IS TO BE CARRIED ON IN ACCORDANCE
 WITH THESE PLANS AND THE STANDARD SPECIFICATIONS,
 FOR CONSTRUCTION DATED 1986, FOR USE ON THESE
 PROJECTS INCLUDING ALL SUBSEQUENT PROVISIONS AS
 ARE INCORPORATED IN THESE PLANS.

PROJECT PROCESSED UNDER
 SECONDARY ROAD PLAN

SUBMITTED BY ORDER OF THE STATE TRANSPORTATION BOARD

APPROVED: *David B. Kellen* DATE: 6/21/87
 CHIEF ENGINEER

DEPARTMENT OF TRANSPORTATION
 FEDERAL HIGHWAY ADMINISTRATION

APPROVED: _____ DATE: _____
 DIVISION ADMINISTRATOR

PROJECT: GROTON
 F# 026-1(27)S
 BR# 026-1(27)S
 SHEET 1 OF 131 SHEETS

D-10 SRS 12/17/70