

Construct Drive
87450 LT 12' wide

CONSTRUCT APPROACH VT 232 (24' PAVED)

CURVE DATA
 Δ 5°-34'-50" RT
 D 1°-45'
 R 3274.04
 T 159.57
 L 318.89
 E 3.89


Erosion Matting
 87450 - 87400 RT
 87450 - 87400 LT

TEMP 4" WHITE LINE
 87100 - 87110 (12' RT)
 87400 - 87405 (16' LT)
 87400 - 87410 (12' LT)

LOCAL 4" WHITE LINE
 RTE 302 87450 (12' LT) - RT 232 88150 (12' LT) (20')
 RTE 232 1450 (12' RT) - RT 302 88150 (12' LT) (40')

LOCAL 24" STOP BAR
 RT 232 1124 - 1126 E - 26' LT
 TEMP 24" STOP BAR
 RT 232 1124 - 1126 E - 26' LT
 DURABLE LETTER IN WORD MARKINGS
 RTE 232 1130 - 1132 LT (S, T, C, P)

Sign Legend
 Dashed = Existing
 Solid = New
 R = Remove

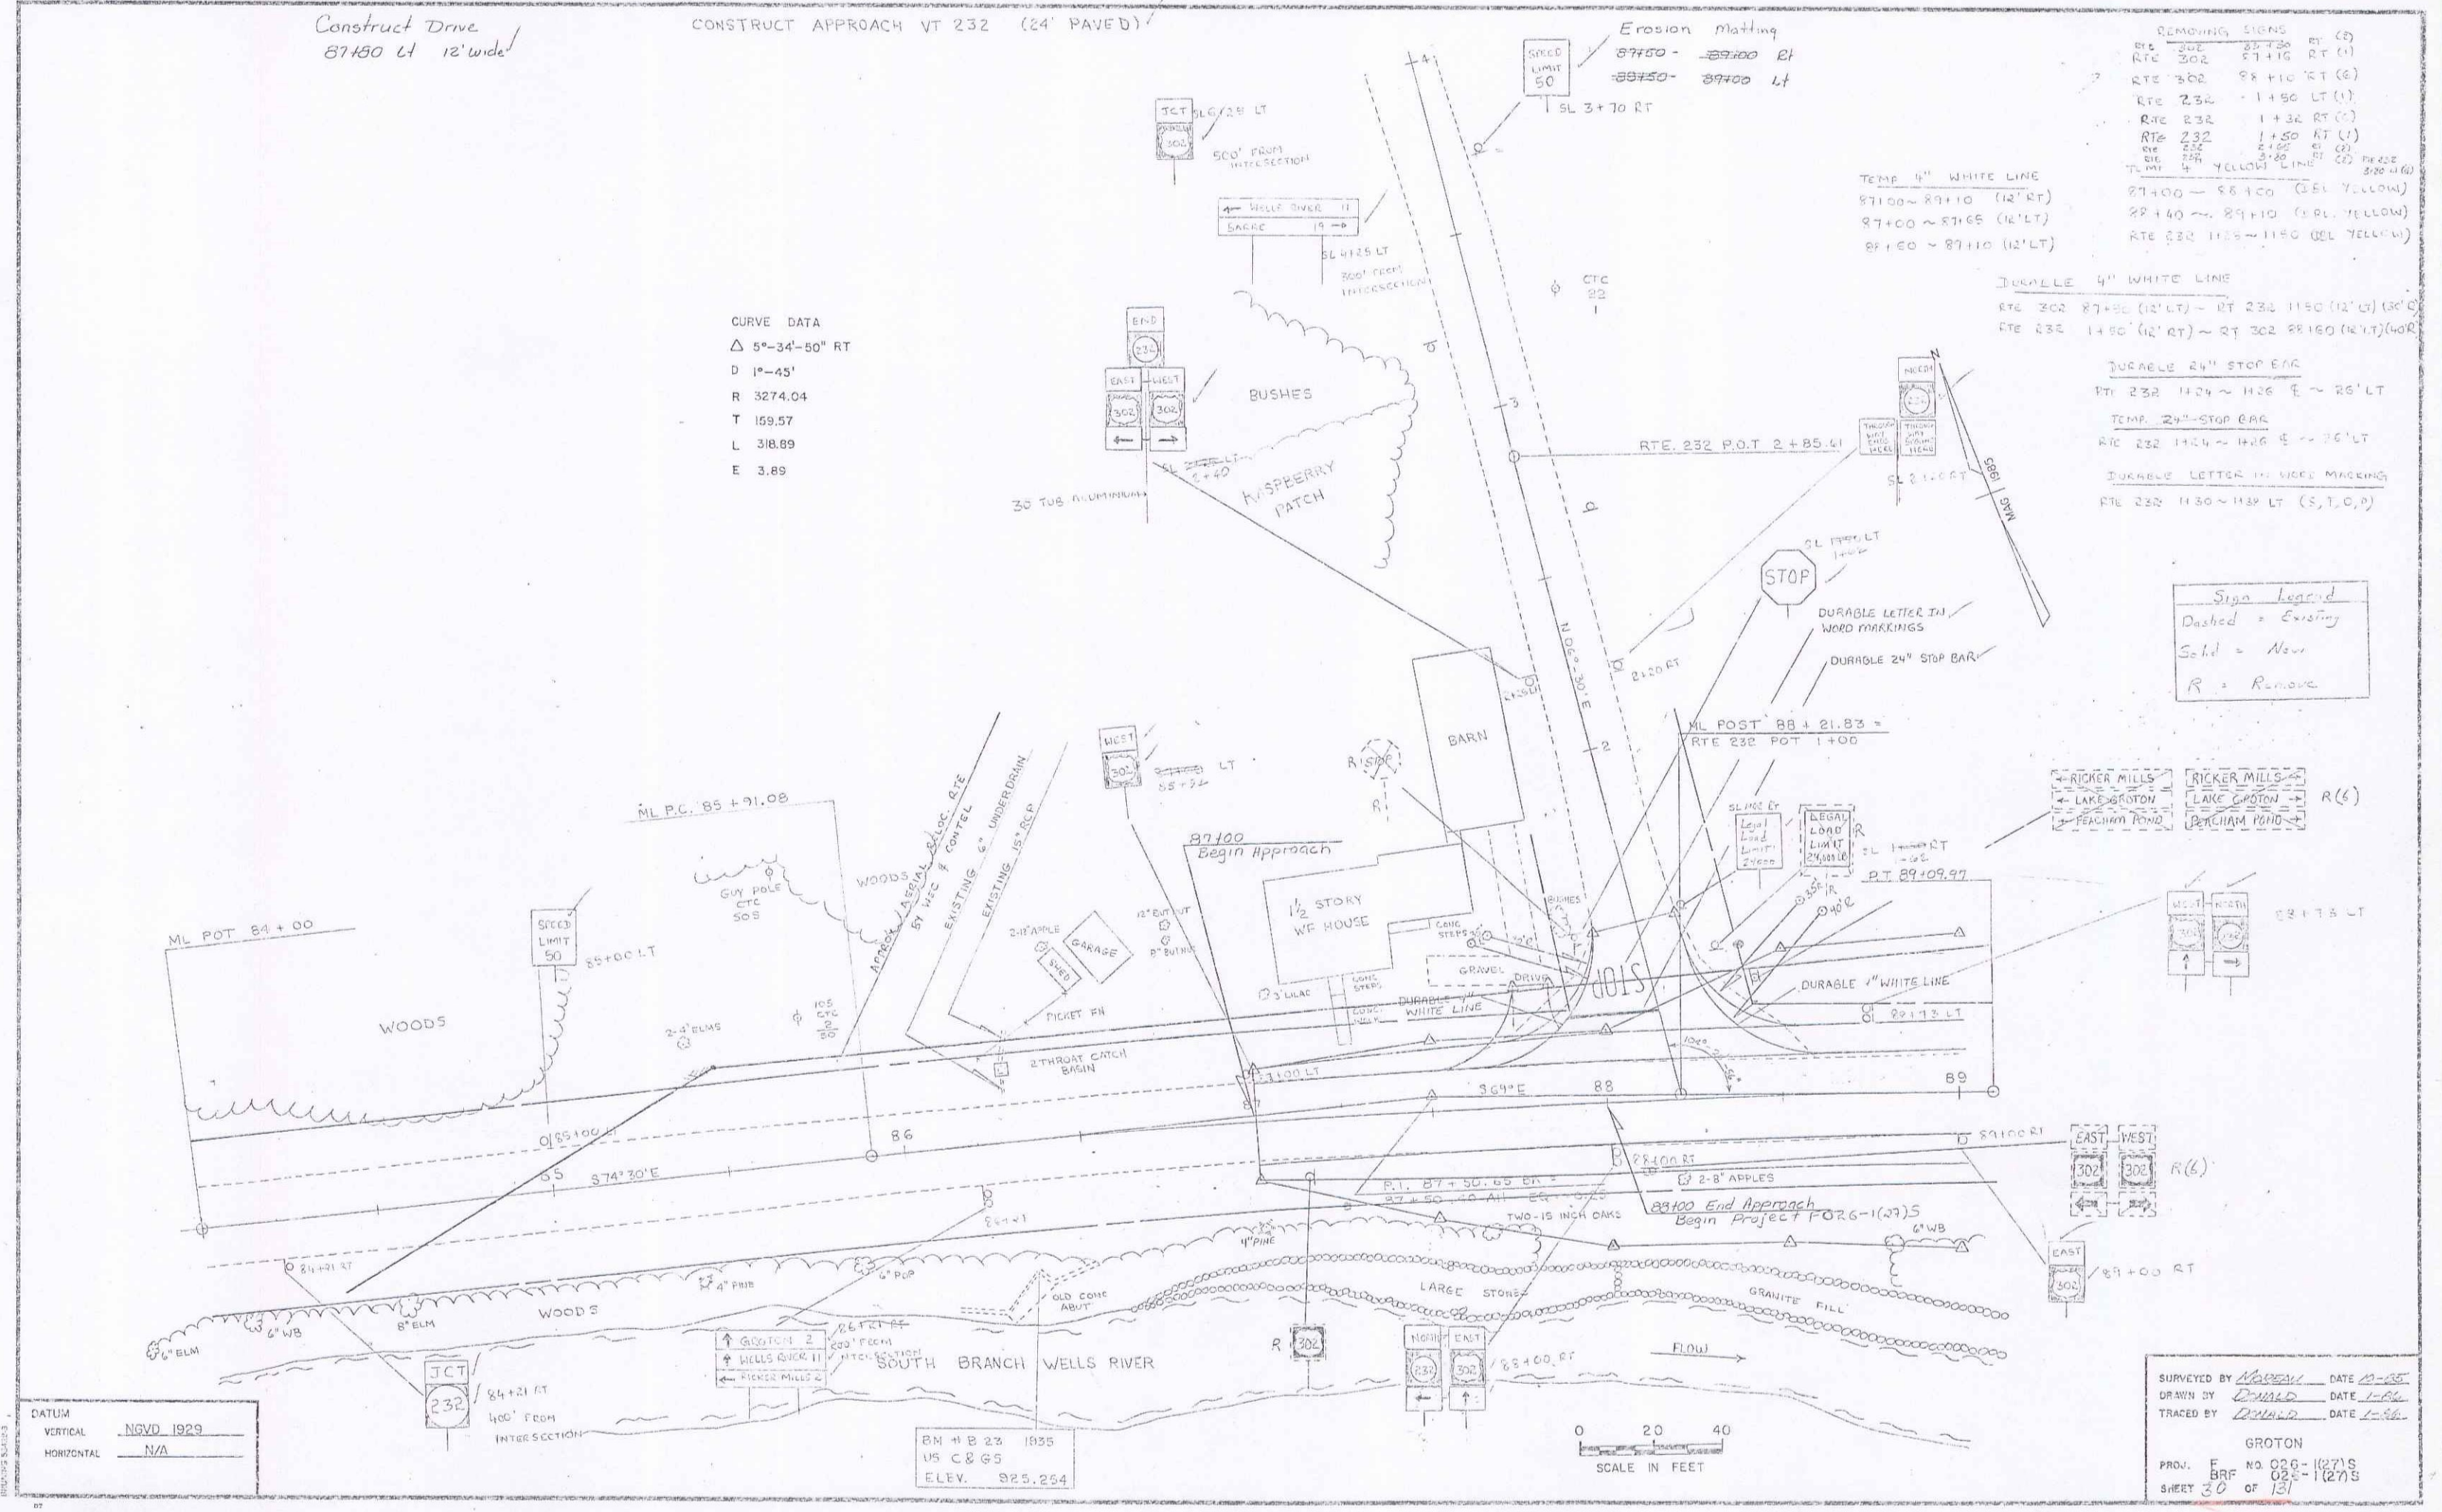

JAN 8 1993

18