

DATE CHECKED  
BY  
DATE OF PLAN CHECKED  
BY

DATE CHECKED  
BY  
DATE OF PLAN CHECKED  
BY

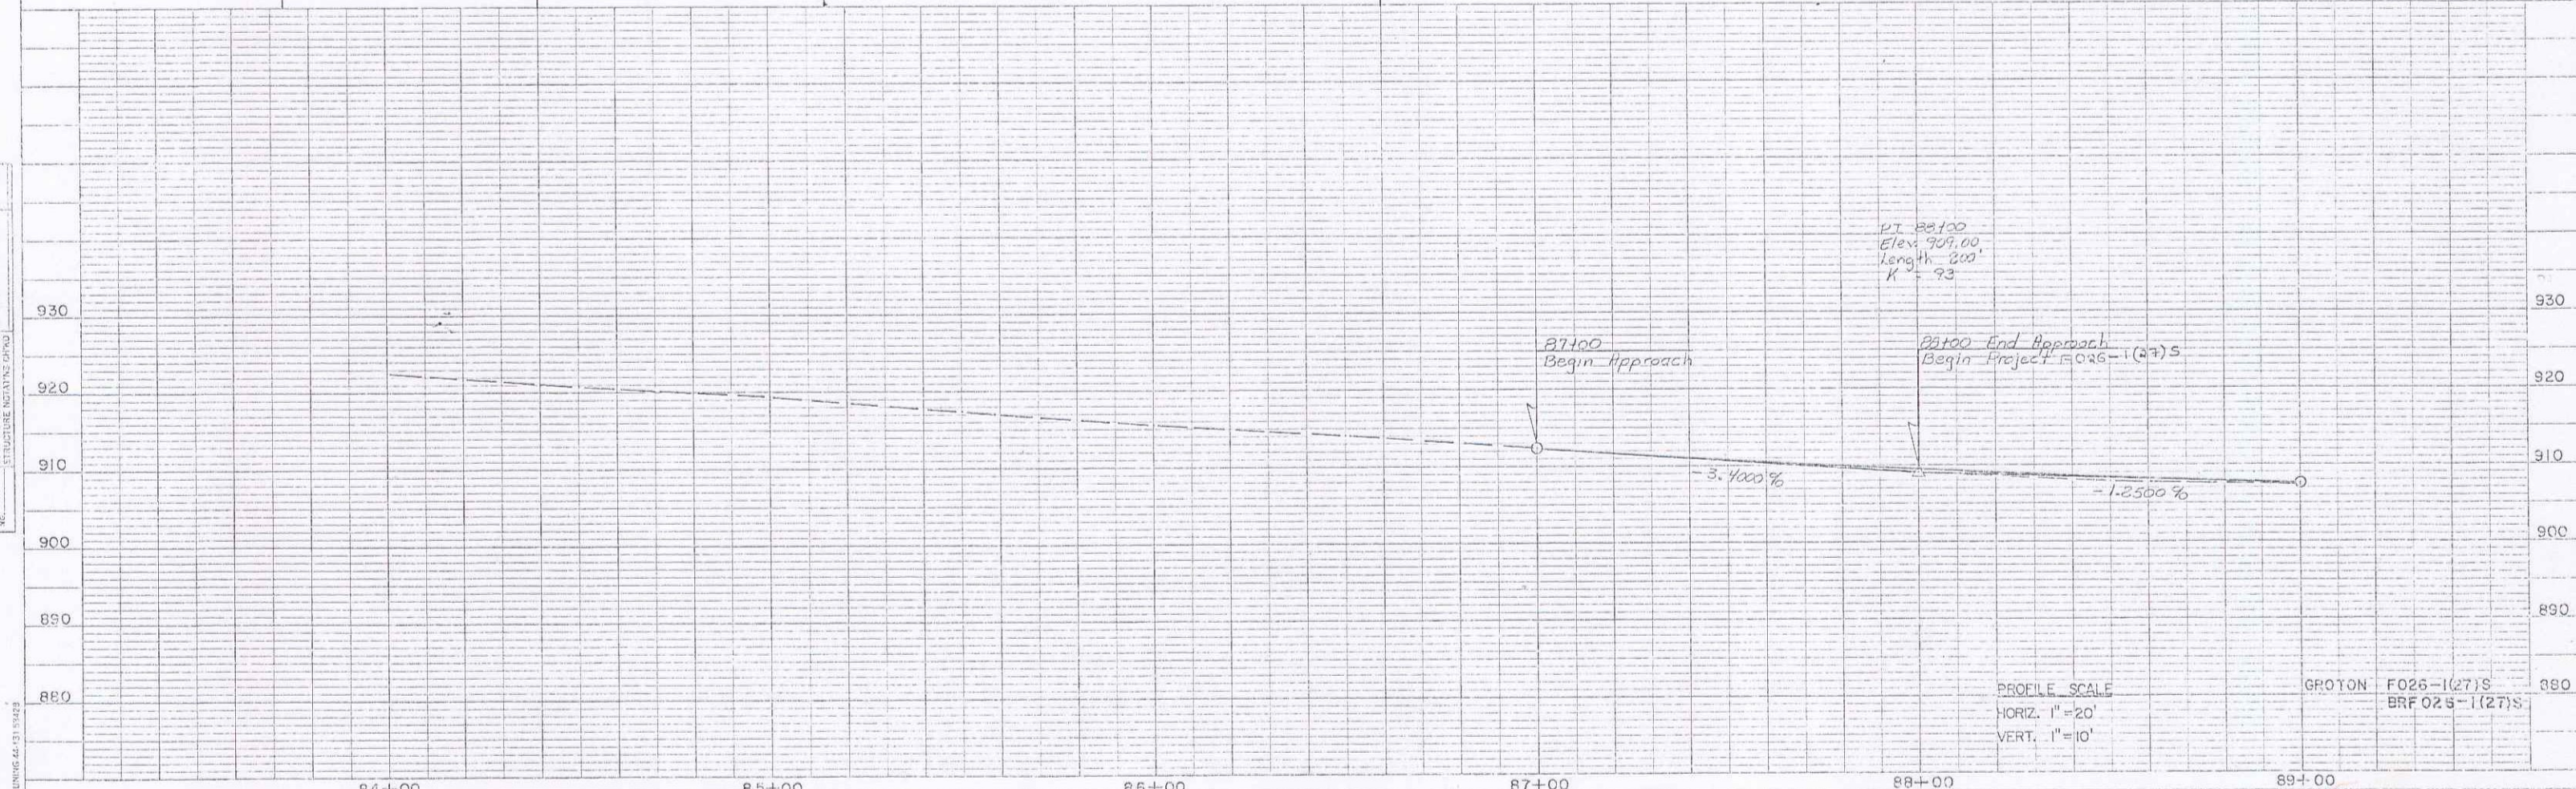
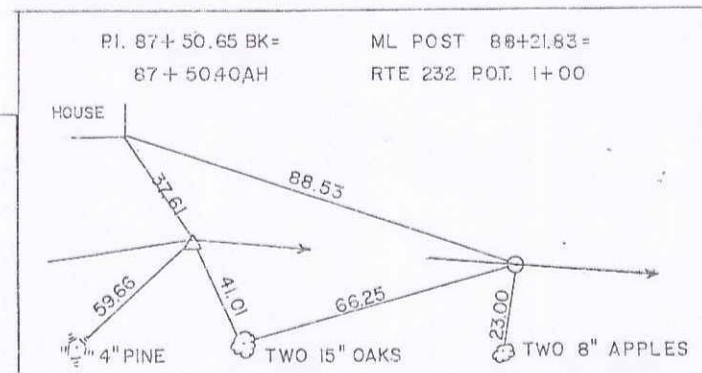
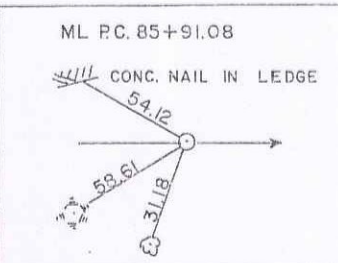
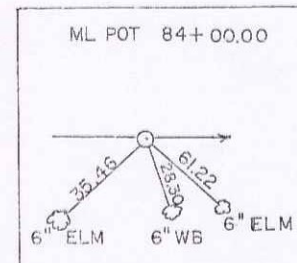


PLATE 1 SINGLE PLAN - PROFILE  
CHARLES B. WING CO.  
P.O. BOX 111

PROFILE SCALE  
HORIZ. 1"=20'  
VERT. 1"=10'

GROTON F026-1(27)S  
BRF 026-1(27)S

JAN 8 1993

Sheet 31 of 131  
19