


DATE: _____
 PROJECT: _____
 DRAWING NO.: _____
 SHEET NO.: _____

DATE: _____
 PROJECT: _____
 DRAWING NO.: _____
 SHEET NO.: _____

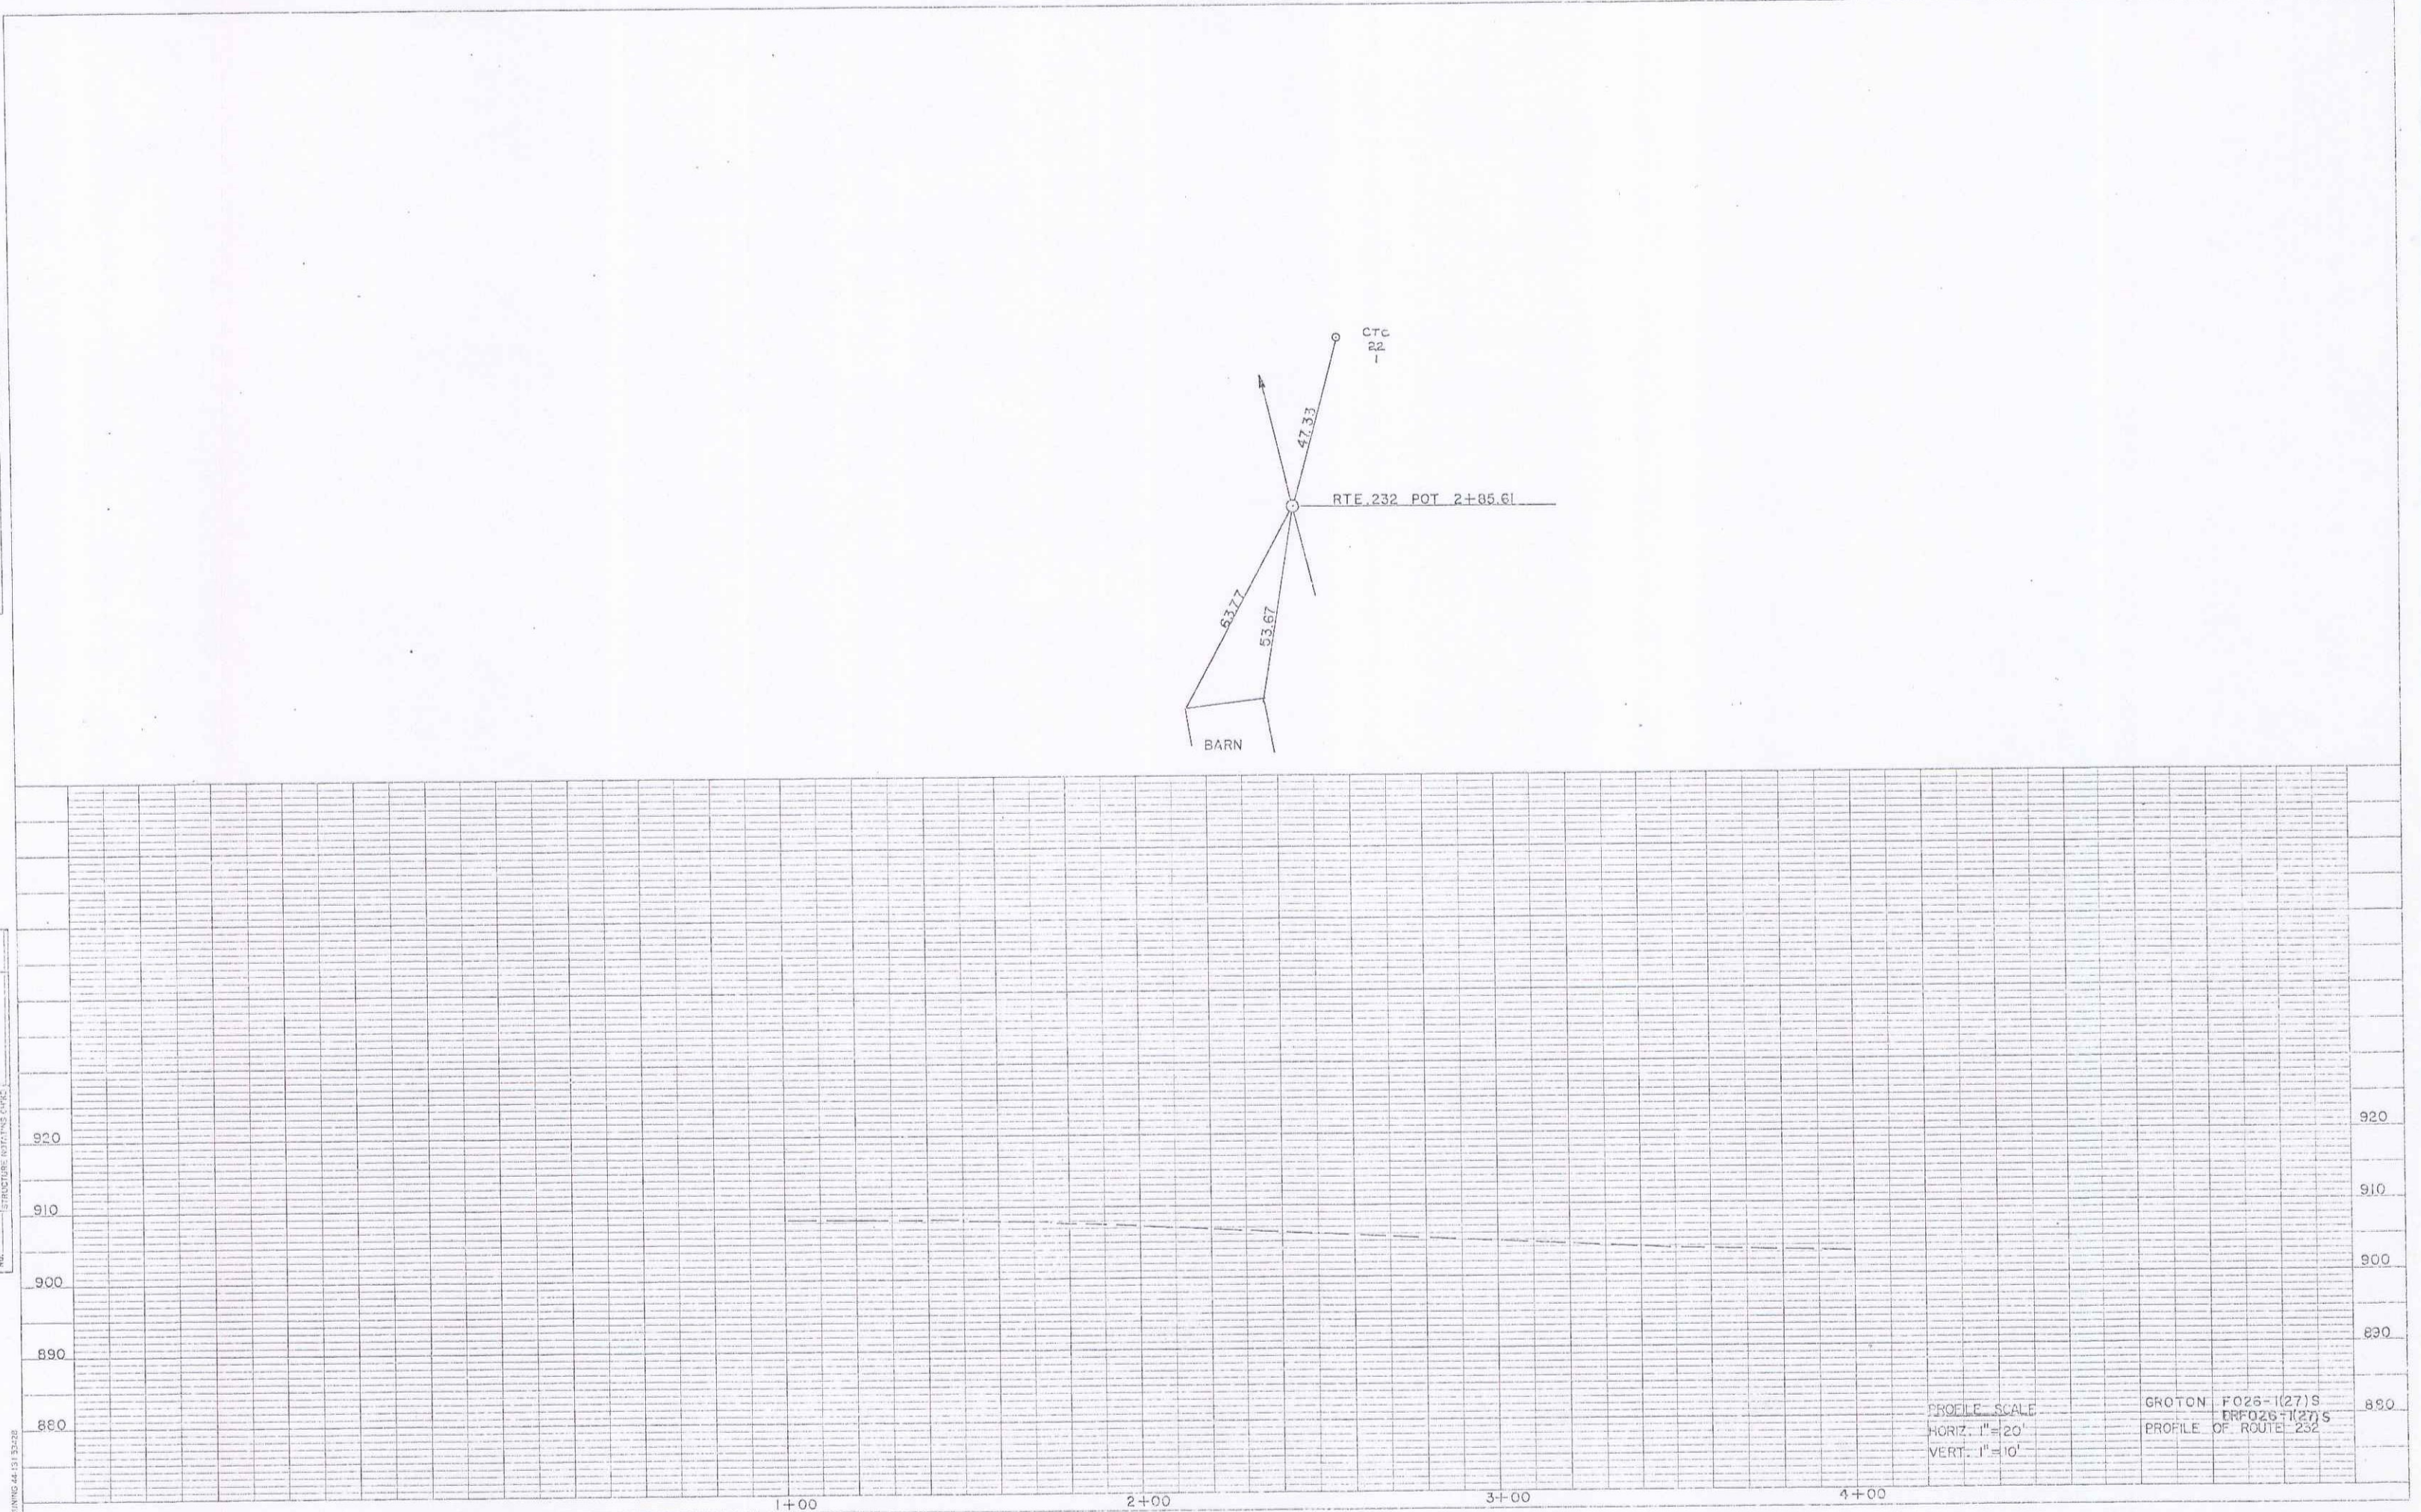

PROFILE SCALE
 HORIZ. 1"=20'
 VERT. 1"=10'
 GROTON F025-(27)S
 ERFO25-(27)S
 PROFILE OF ROUTE 232

PLATE 1 SINGLE PLAN & PROFILE
 CHARLES BURRIDGE CO.
 MADE IN U.S.A.

Sheet 32 of 131

JAN 8 1993

20