

CONSTRUCT DRIVE
 89+50 LT (36' GRAVEL)
 90+65 RT (18' GRAVEL)
 92+50 LT (18' PAVED)
 92+20 RT (18' GRAVEL)


4" Island w/ Granite Slope Edging
 93+50 ~ 94+00 RT
 Note: Slope Edging to be
 set with a 4" Reveal

Erosion Matting
 89+00-89+40 RT
 89+00-89+20 LT
 89+20-89+25 LT
 90+75 RT-92+75 RT
 92+75 LT-94+00 LT

Wood Machine Posts
 3x4x8

CURVE DATA
 Δ 1°-09'-20" LT
 D 1"
 R 5729.58
 T 57.78
 L 115.56
 E 0.29

TEMPORARY 4" WHITE LINE
 89+10 ~ 94+00 (12' LT)
 89+10 ~ 94+00 (12' RT)
 TEMPORARY 4" YELLOW LINE
 89+10 ~ 94+00 (12' YELLOW)

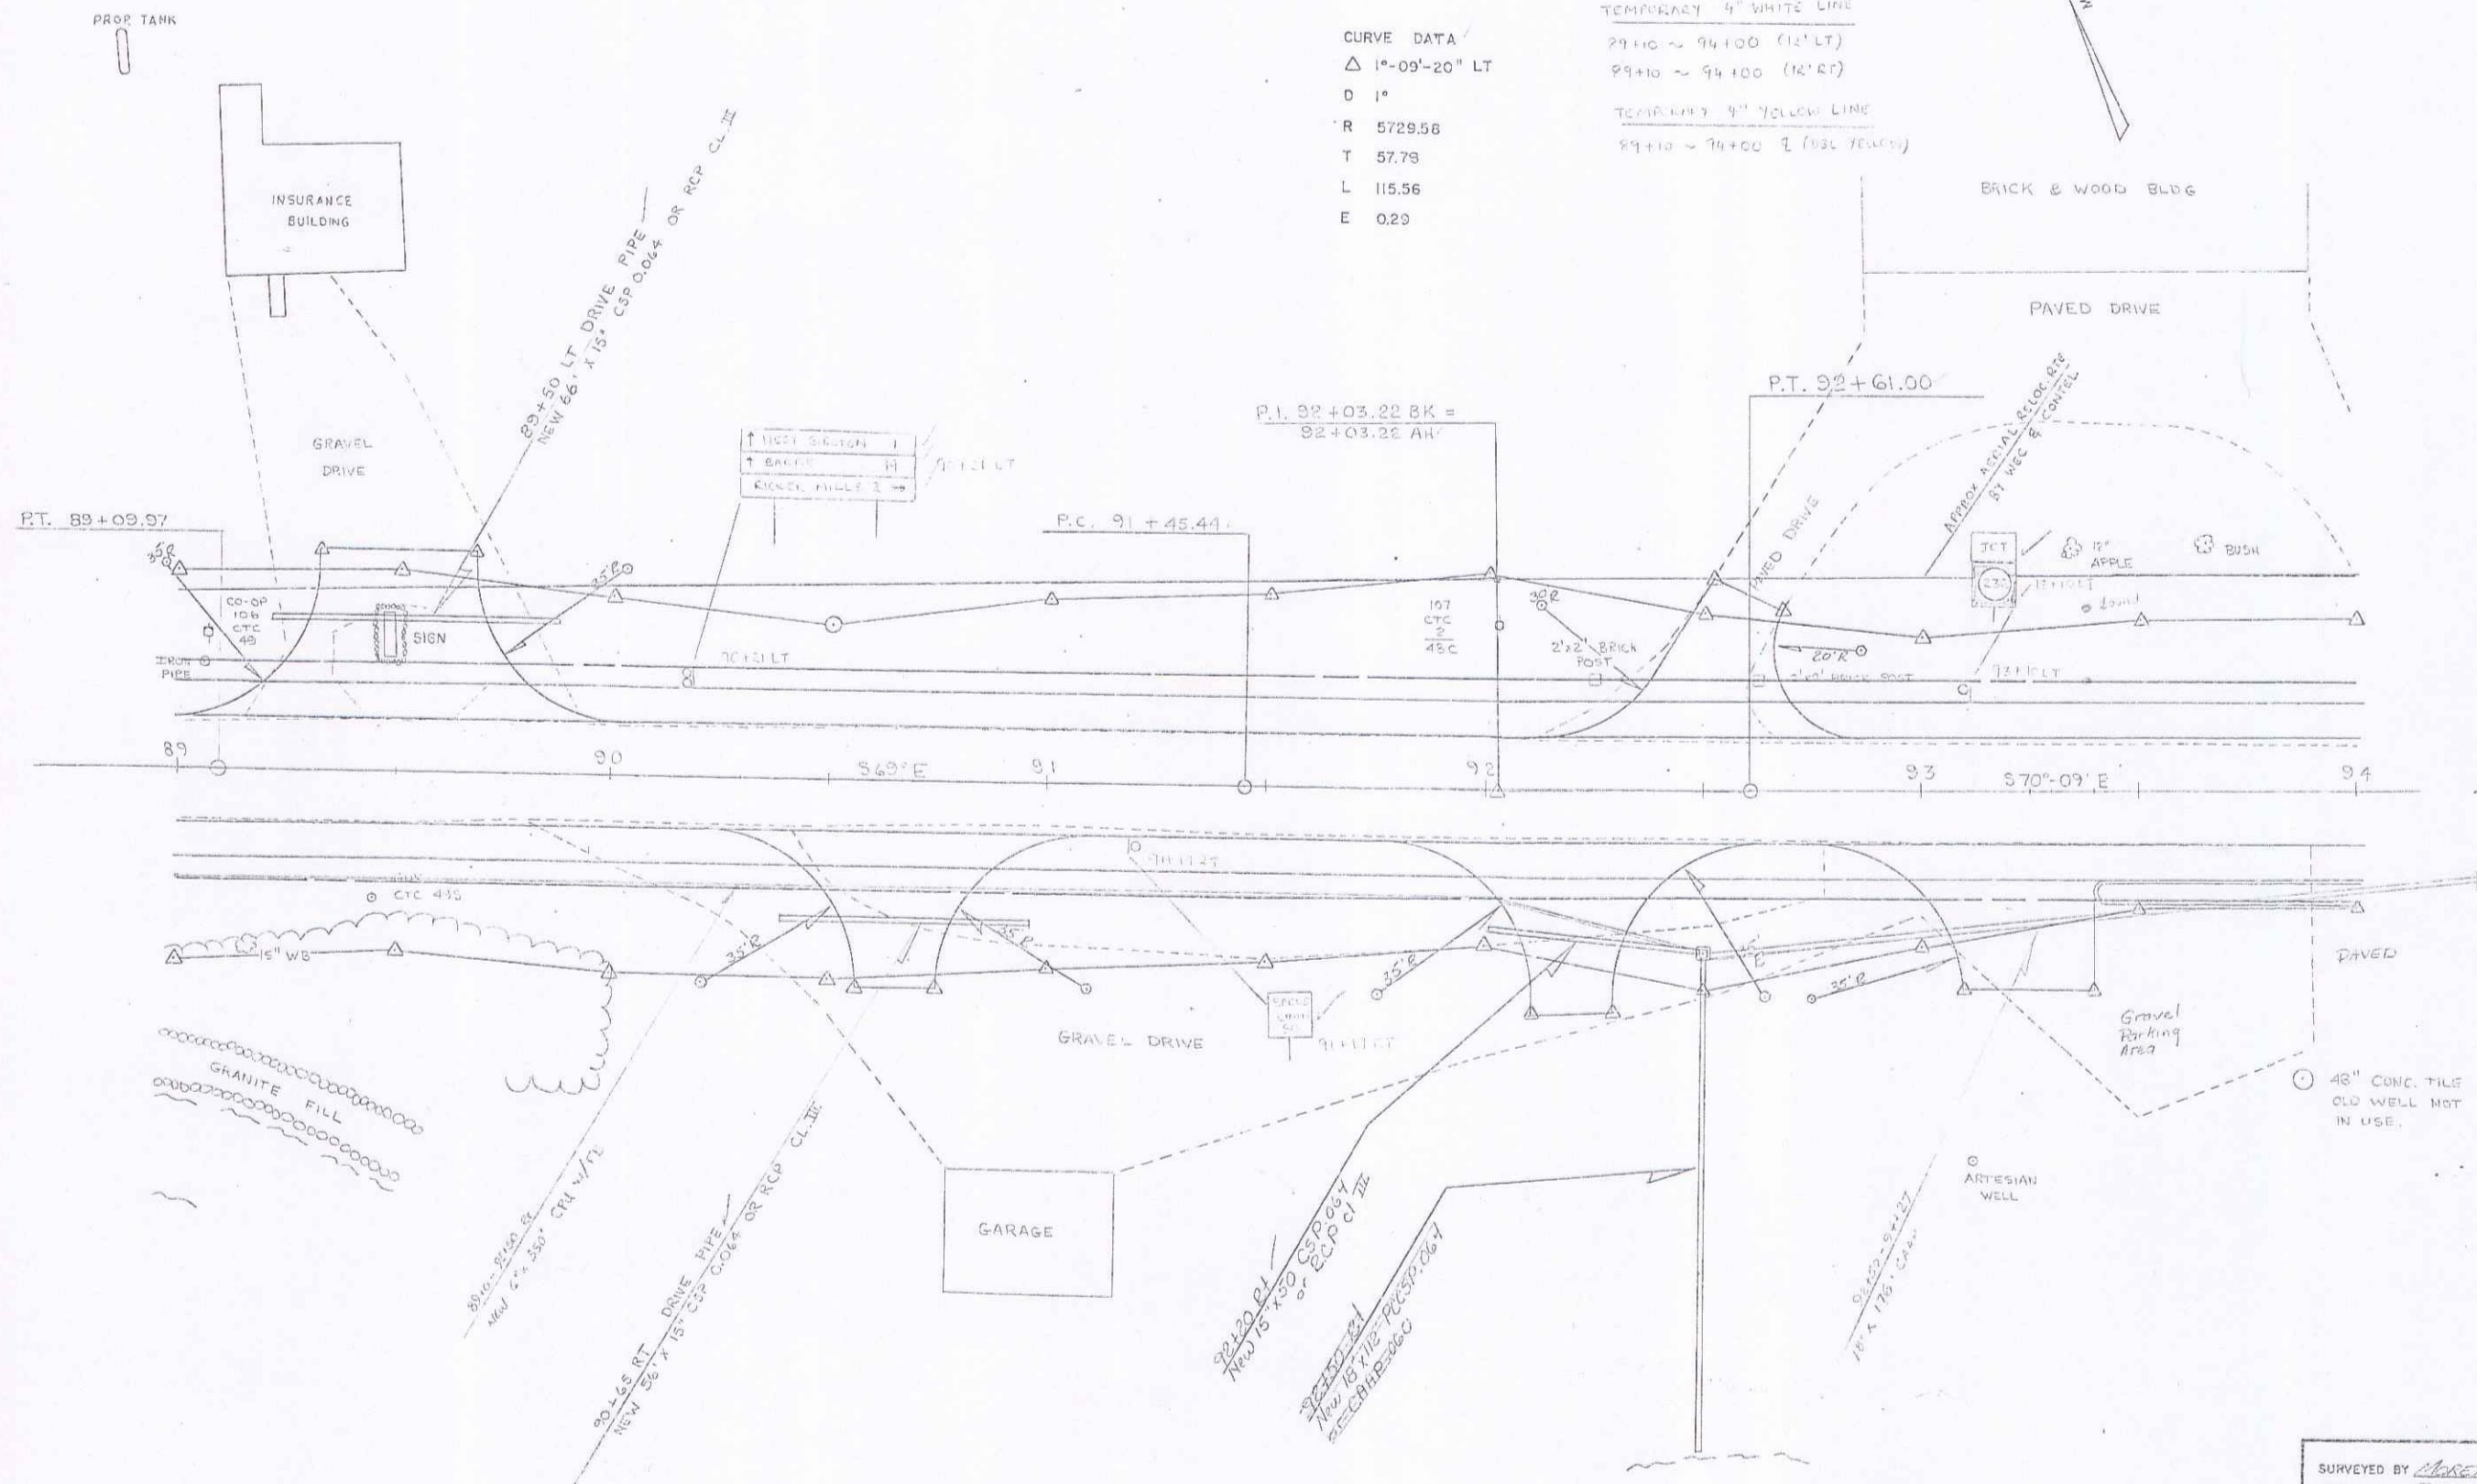

DATUM
 VERTICAL N.G.V.D. 1929
 HORIZONTAL N/A

0 20 40
 SCALE IN FEET

SURVEYED BY Cherry DATE 10-85
 DRAWN BY David DATE 1-86
 TRACED BY David DATE 1-86
 GROTON
 PROJ. F. NO. 026-(27)S
 RRF OF 026-(27)S
 SHEET 23 OF 137

JAN 8 1993

21