
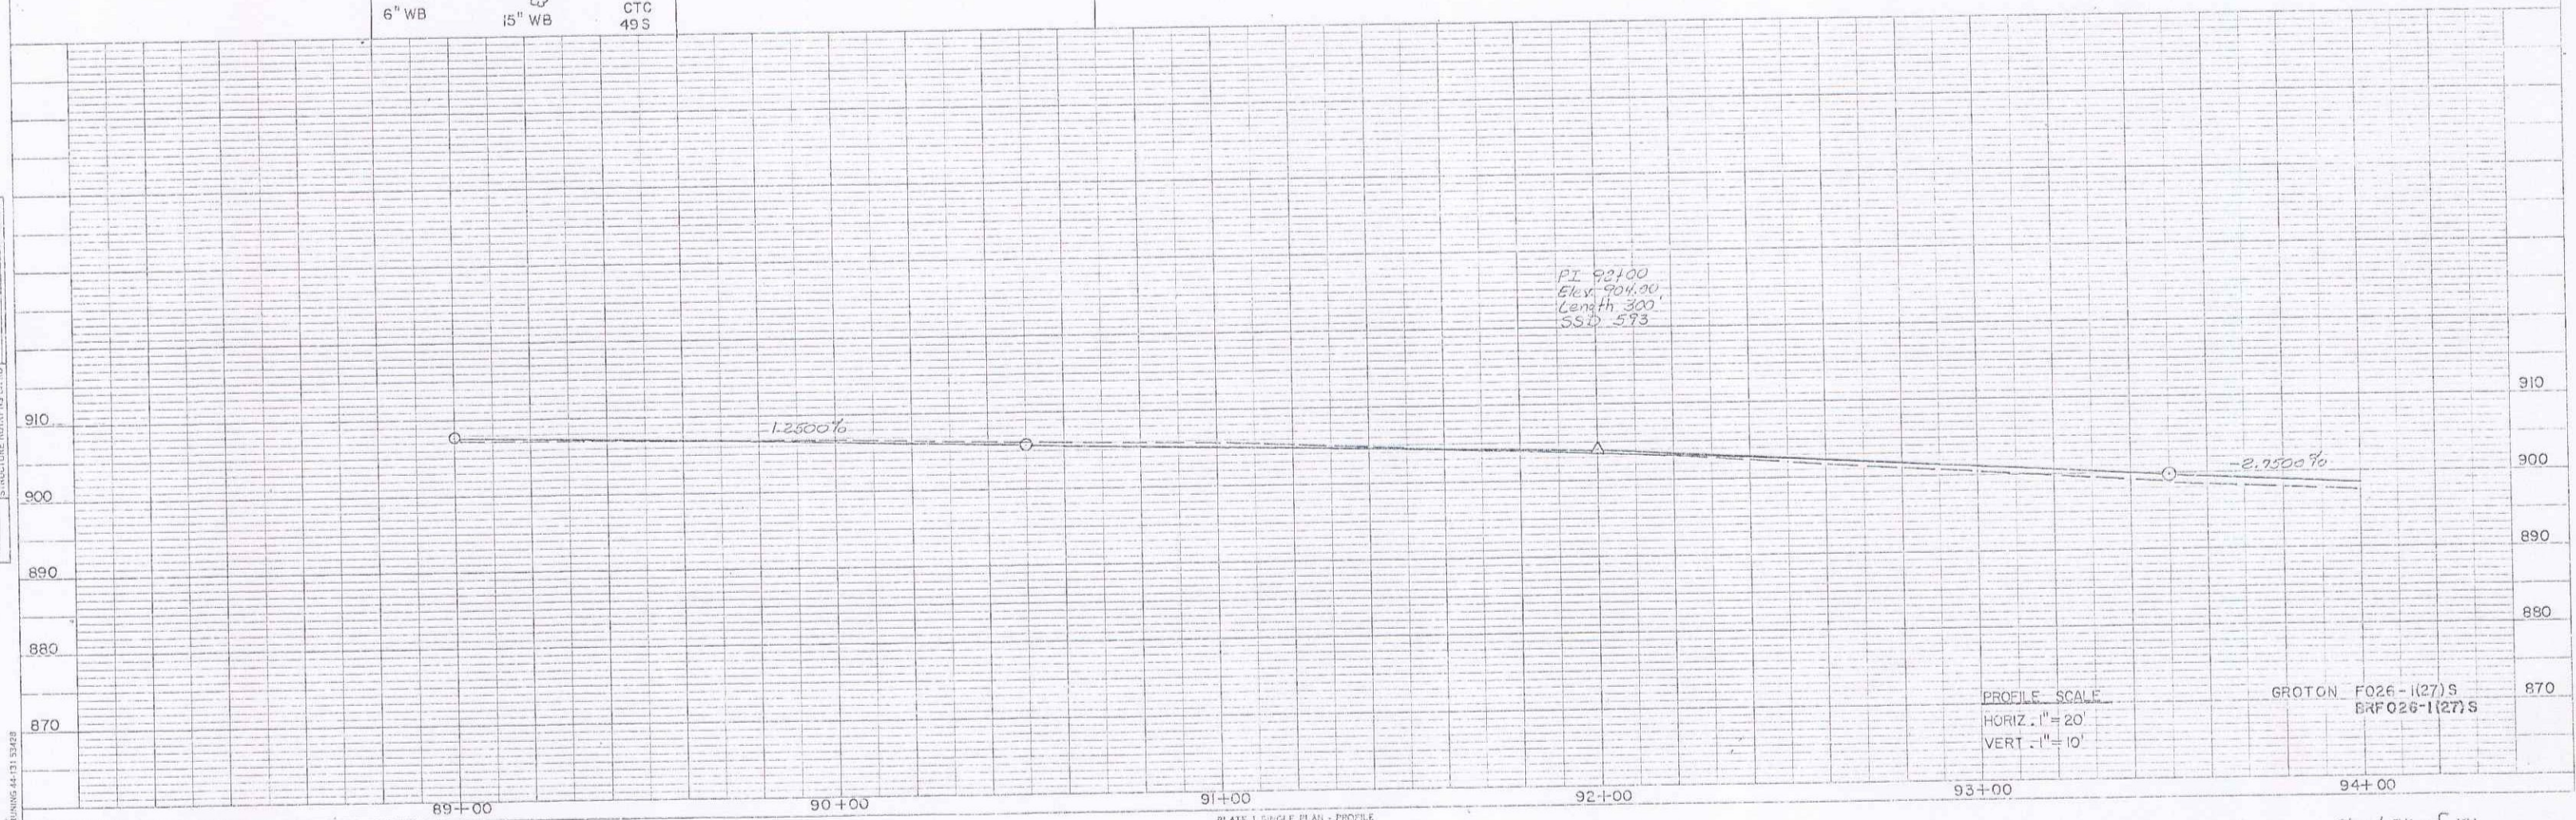


DATE	1/8/93
BY	...
PROJECT	...
DESCRIPTION	...
SCALE	...
REVISIONS	...

DATE	1/8/93
BY	...
PROJECT	...
DESCRIPTION	...
SCALE	...
REVISIONS	...

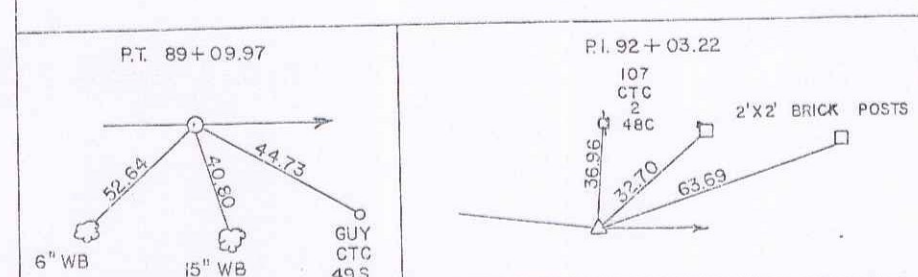

PROFILE SCALE
 HORIZ. 1" = 20'
 VERT. 1" = 10'

GROTON F026-1(27)S
 BRP026-1(27)S

PLATE 1 SINGLE PLAN - PROFILE
 CHARLES BRUNING CO.
 MADE IN U.S.A.

Sheet 34 of 131

JAN 8 1993

22