
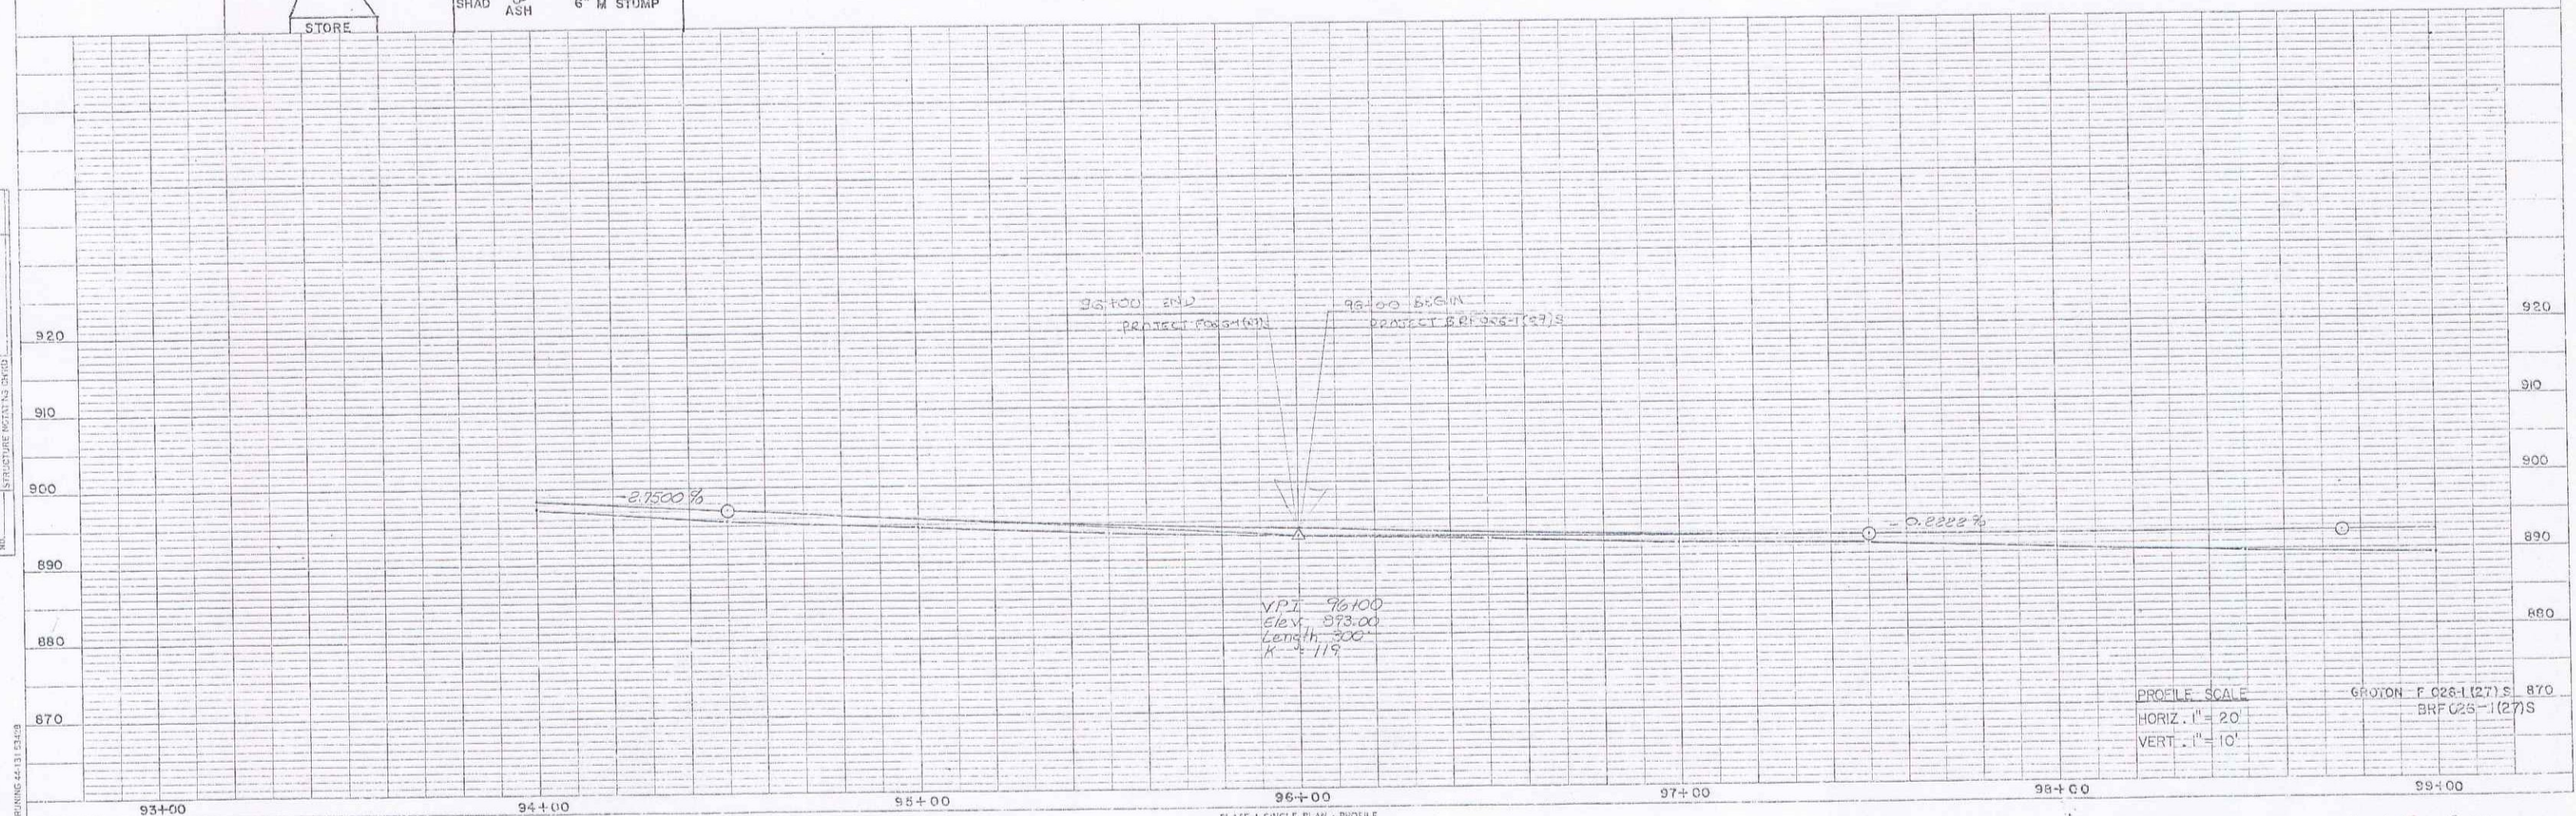


DATE: _____
 DRAWN BY: _____
 CHECKED BY: _____
 NO. _____

PROFILE
 DATE: _____
 CHECKED BY: _____
 NO. _____

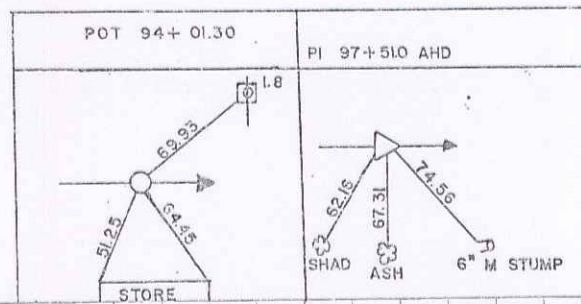

PROFILE SCALE
 HORIZ. 1" = 20'
 VERT. 1" = 10'

GROTON F 028-1 (27) S
 BRP (25-1) (27) S

96+00
 FLATE 1 SINGLE PLAN - PROFILE
 CHARLES BRUNING CO.
 MADE IN U.S.A.

Sheet 36 of 131

JAN 8 1993

24