

DATE: _____
 CHECKED: _____
 IN CHARGE: _____
 NOTE BOOK NO. _____
 RT. OF WAY CHECKED: _____
 NO. _____

DATE: _____
 CHECKED: _____
 IN CHARGE: _____
 NOTE BOOK NO. _____
 RT. OF WAY CHECKED: _____
 NO. _____

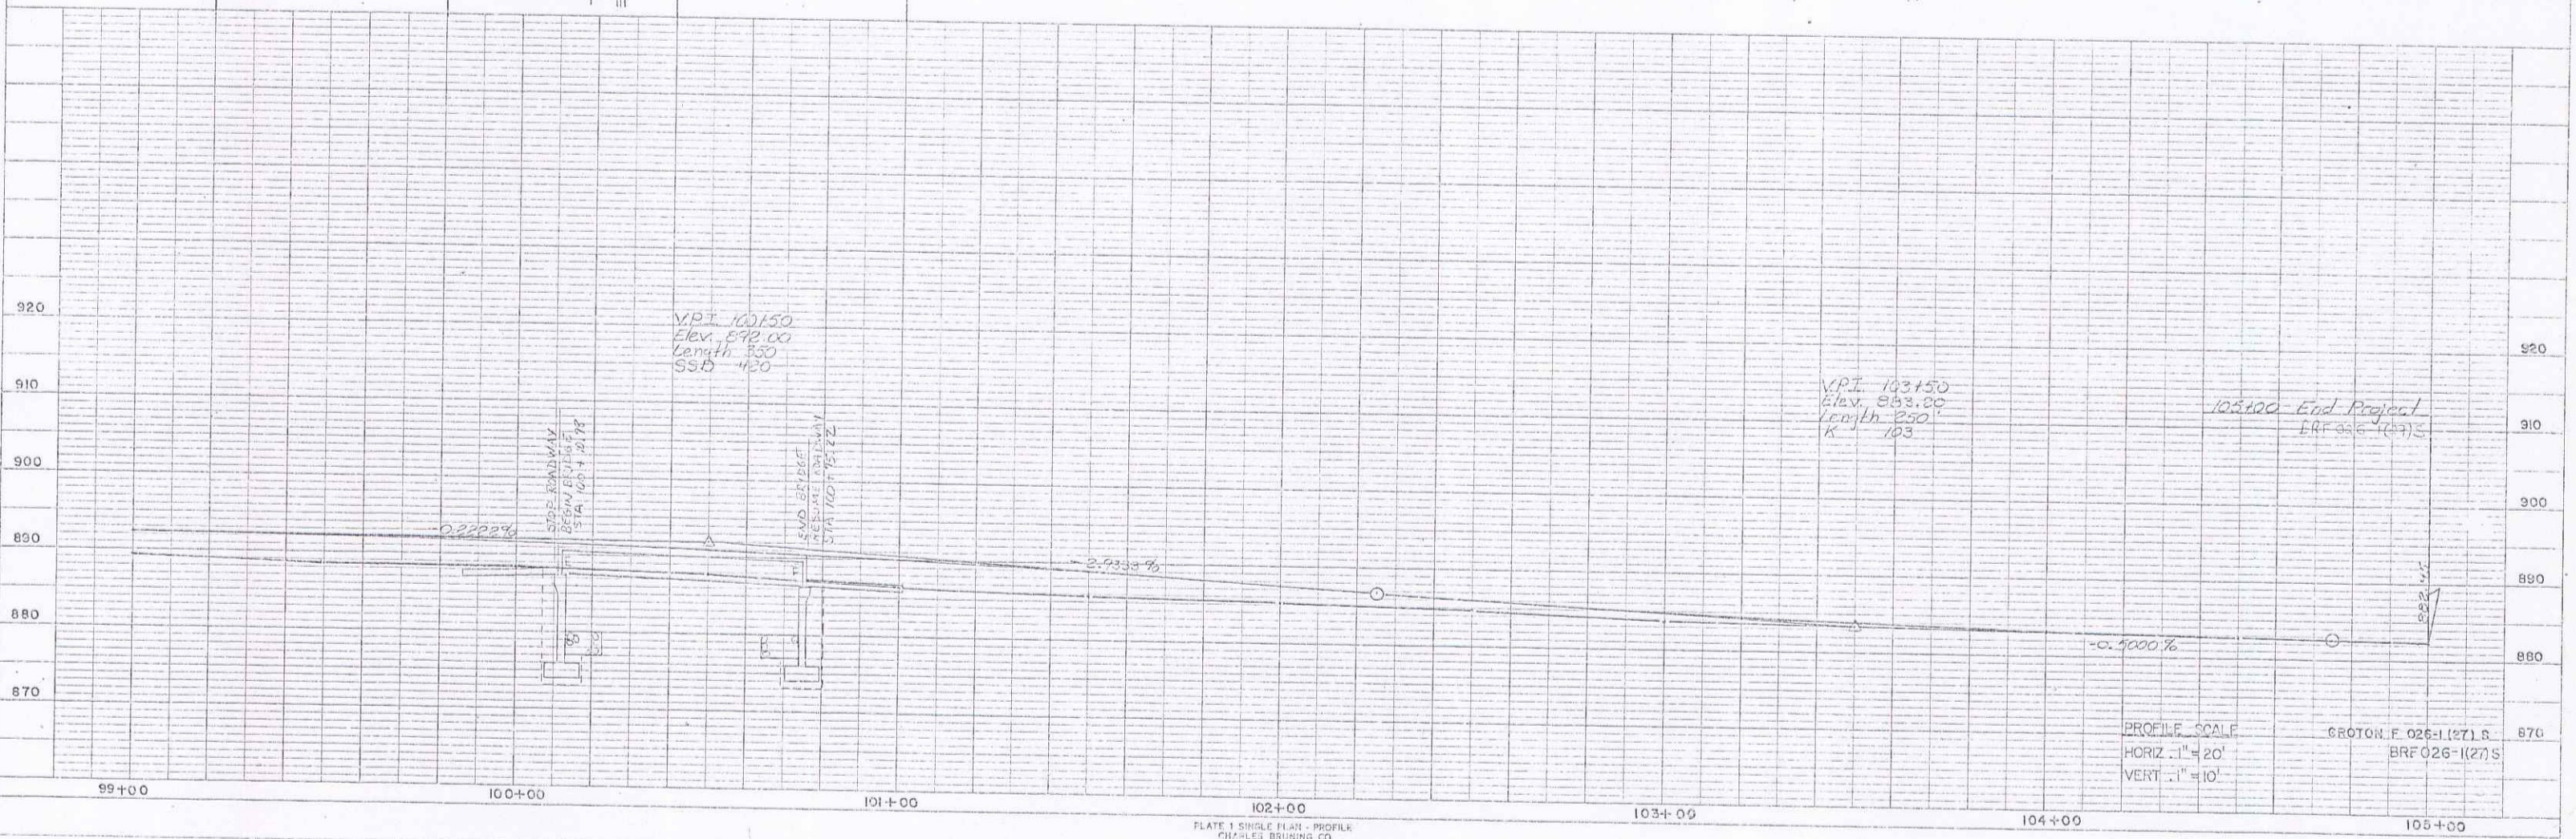
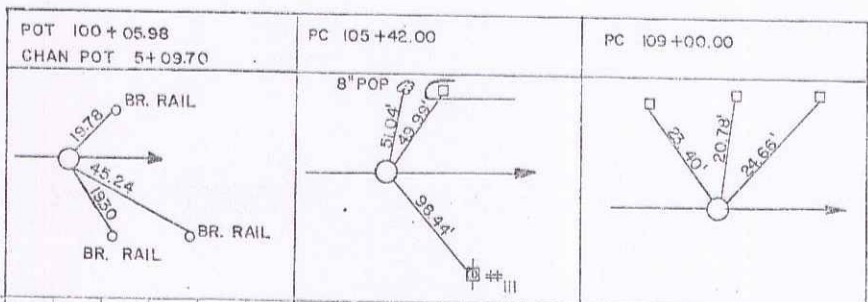


PLATE 1 SINGLE PLAN - PROFILE
 PHOENIX BRIDGE CO.
 MADE IN U.S.A.

PROFILE SCALE
 HORIZ. 1" = 20'
 VERT. 1" = 10'

Sheet 38 of 131

JAN 8 1993

26