



Erosion Matting
 -105+00=105+20=RT
 -105+16=106+75=RT

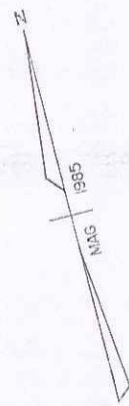

CURVE DATA
 Δ 46° 15' RT.
 D 2° 45'
 R 2083.48'
 T 890.83'
 L 1683.54'
 E 182.45'
 BANK 0.05 FT./FT.

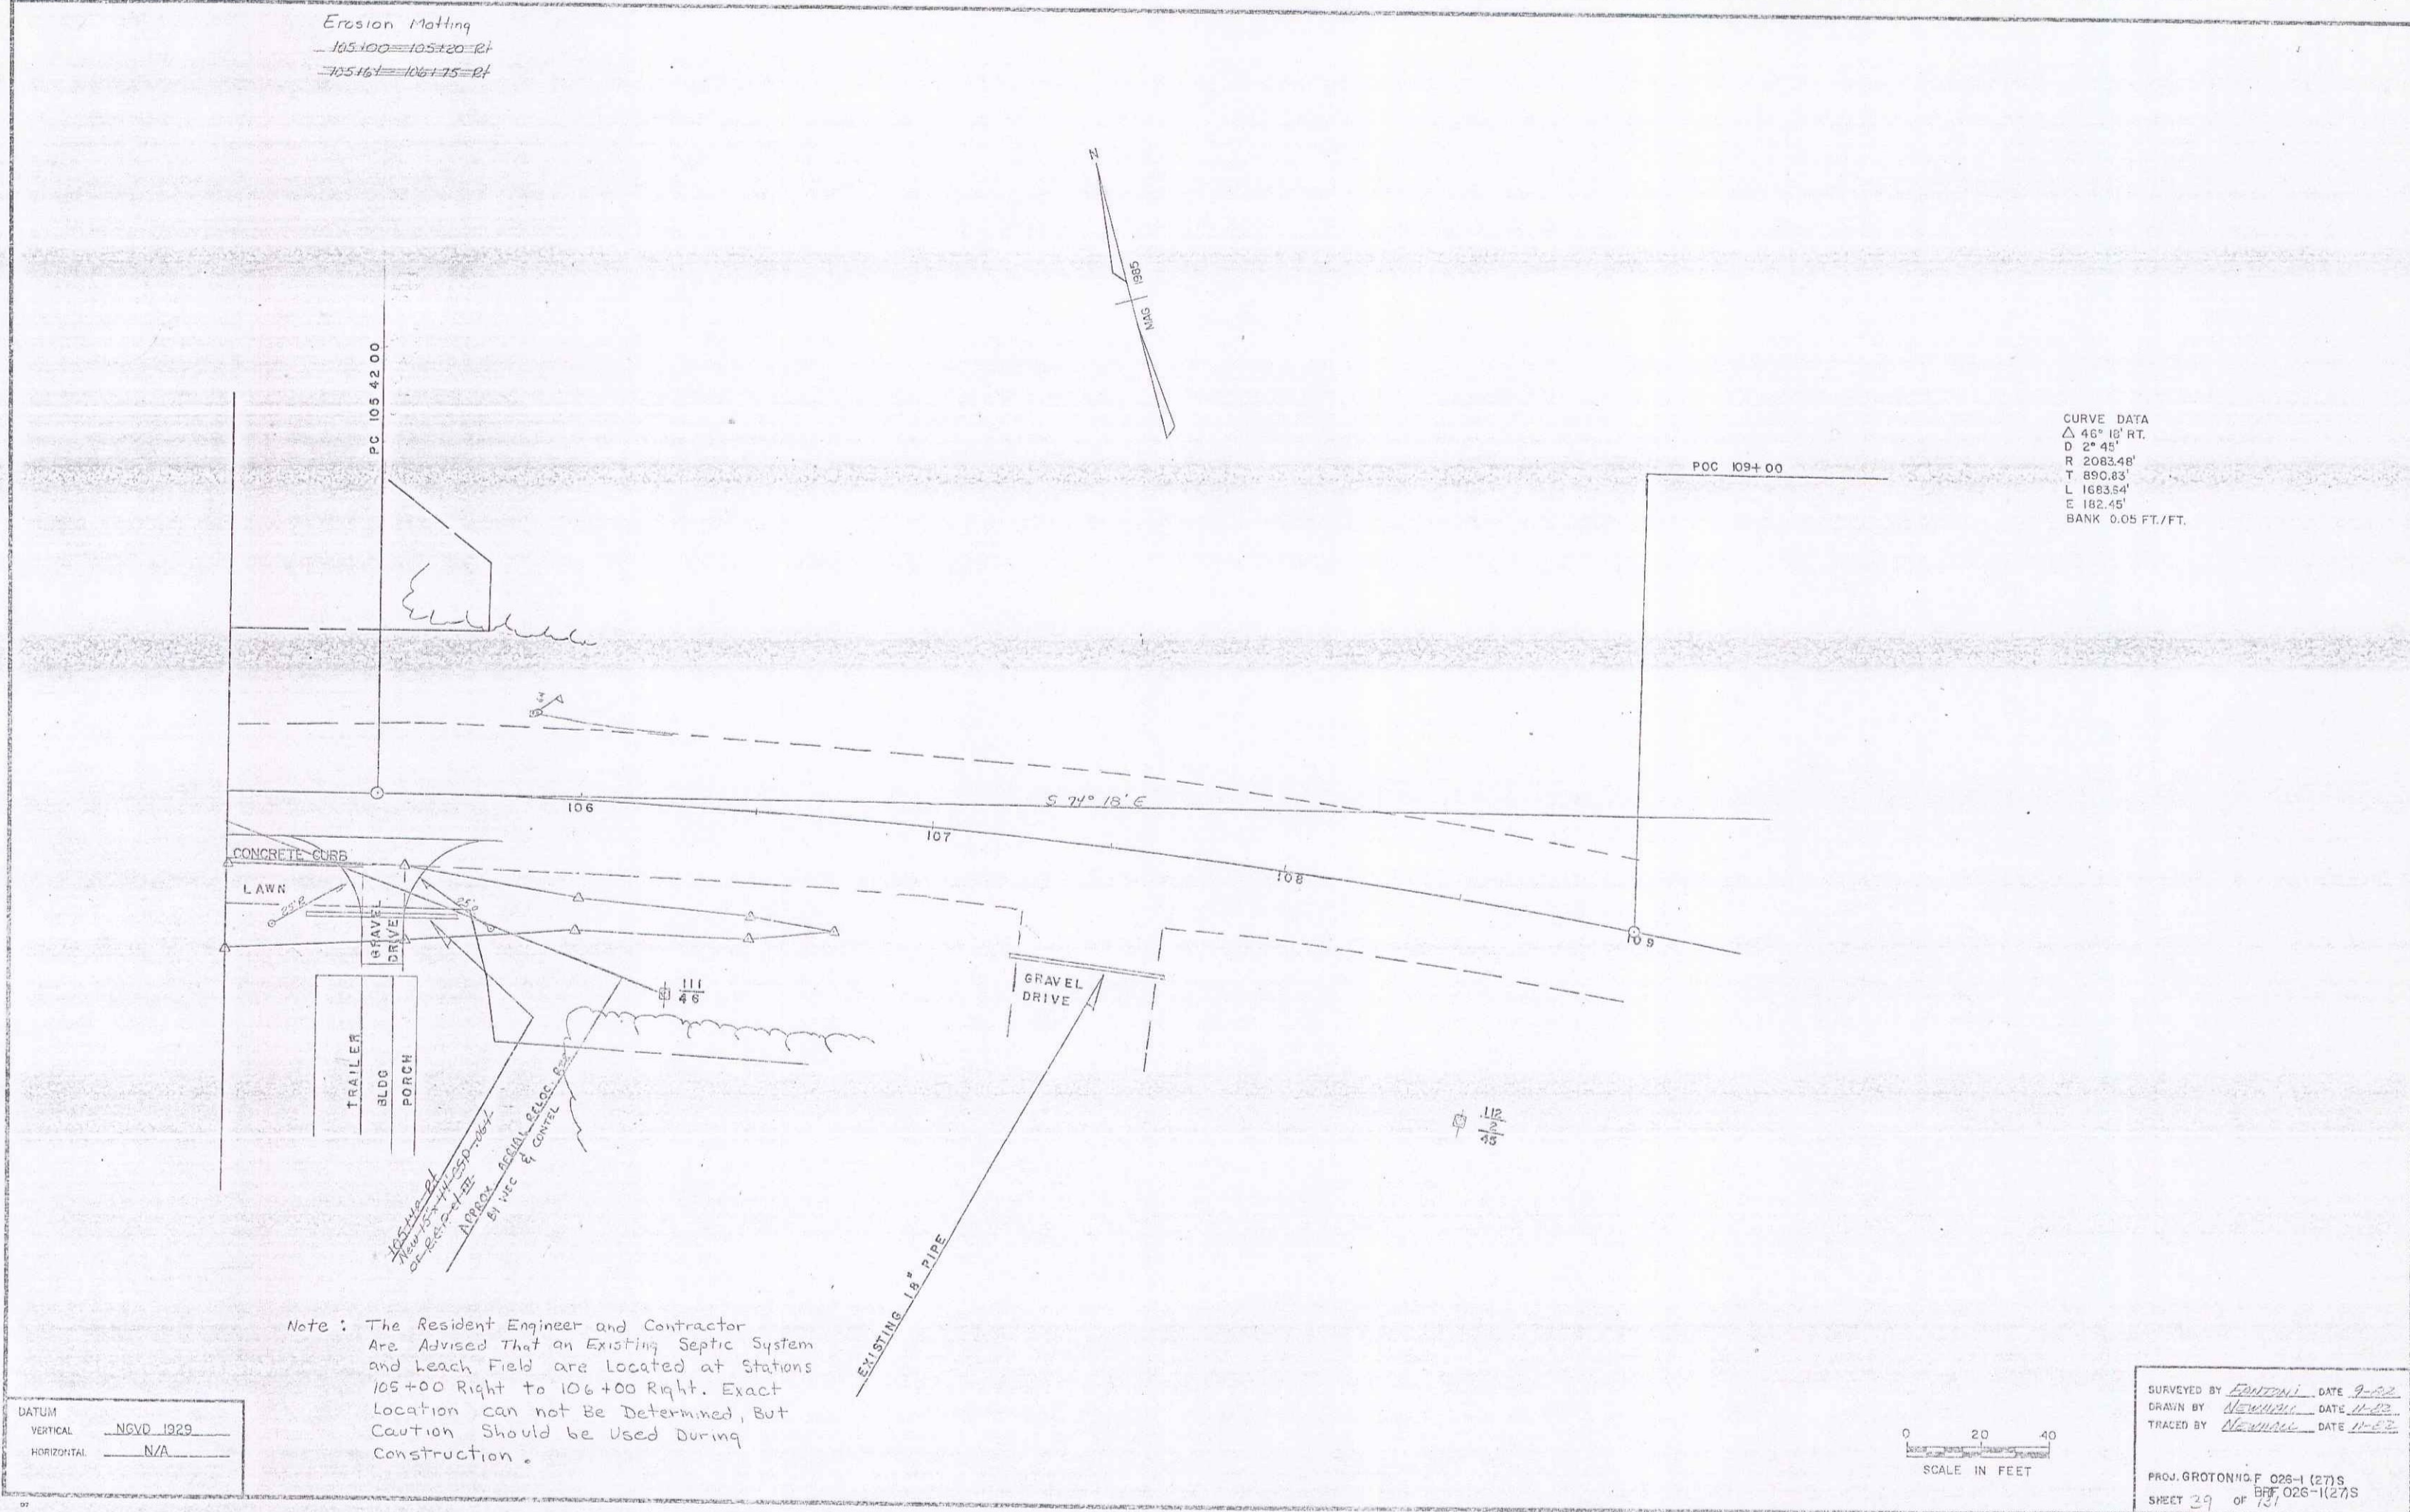

Note: The Resident Engineer and Contractor
 Are Advised That an Existing Septic System
 and Leach Field are Located at Stations
 105+00 Right to 106+00 Right. Exact
 Location can not Be Determined, But
 Caution Should be Used During
 Construction.

DATUM
 VERTICAL NGVD 1929
 HORIZONTAL N/A

SURVEYED BY Epstein DATE 9-82
 DRAWN BY Neuman DATE 11-82
 TRACED BY Neuman DATE 11-82
 PROJ. GROTON NO. F 026-1 (27) S
 SHEET 29 of 131

JAN 8 1993 27