


INDEX OF SHEETS

STATE OF VERMONT AGENCY OF TRANSPORTATION



PROPOSED IMPROVEMENT TOWN OF HARTFORD COUNTY OF WINDSOR U.S. RTE. 4

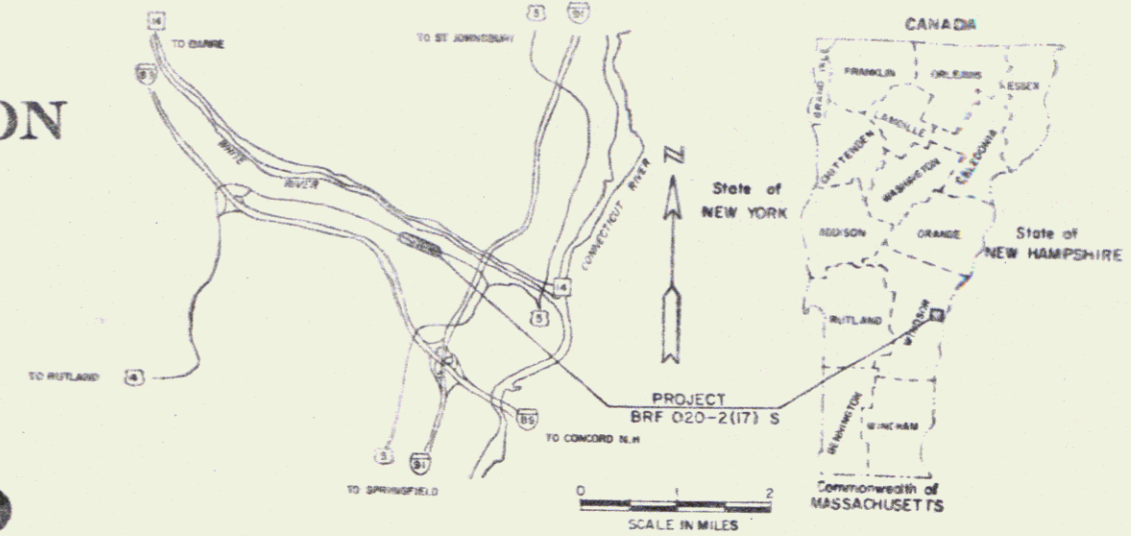


BEGINNING AT A POINT APPROXIMATELY 8.491 MILES
EAST OF THE HARTLAND/HARTFORD TOWN LINES
AND EXTENDING EASTERLY 0.095 MILES

WORK TO BE PERFORMED UNDER THIS PROJECT INCLUDES-
REPLACEMENT OF AN EXISTING BRIDGE AS WELL AS
GRADING, DRAINAGE, SUBBASE AND PAVEMENT OF US 4,
TH 6 AND TH 132.

LENGTH OF ROADWAY 385.07 FEET = 0.073 MILES
LENGTH OF BRIDGE 114.93 FEET = 0.022 MILES
LENGTH OF PROJECT 500.00 FEET = 0.095 MILES
LENGTH OF R.O.W. PROJECT 740.00 FEET = 0.140 MILES

R.O.W. PLANS

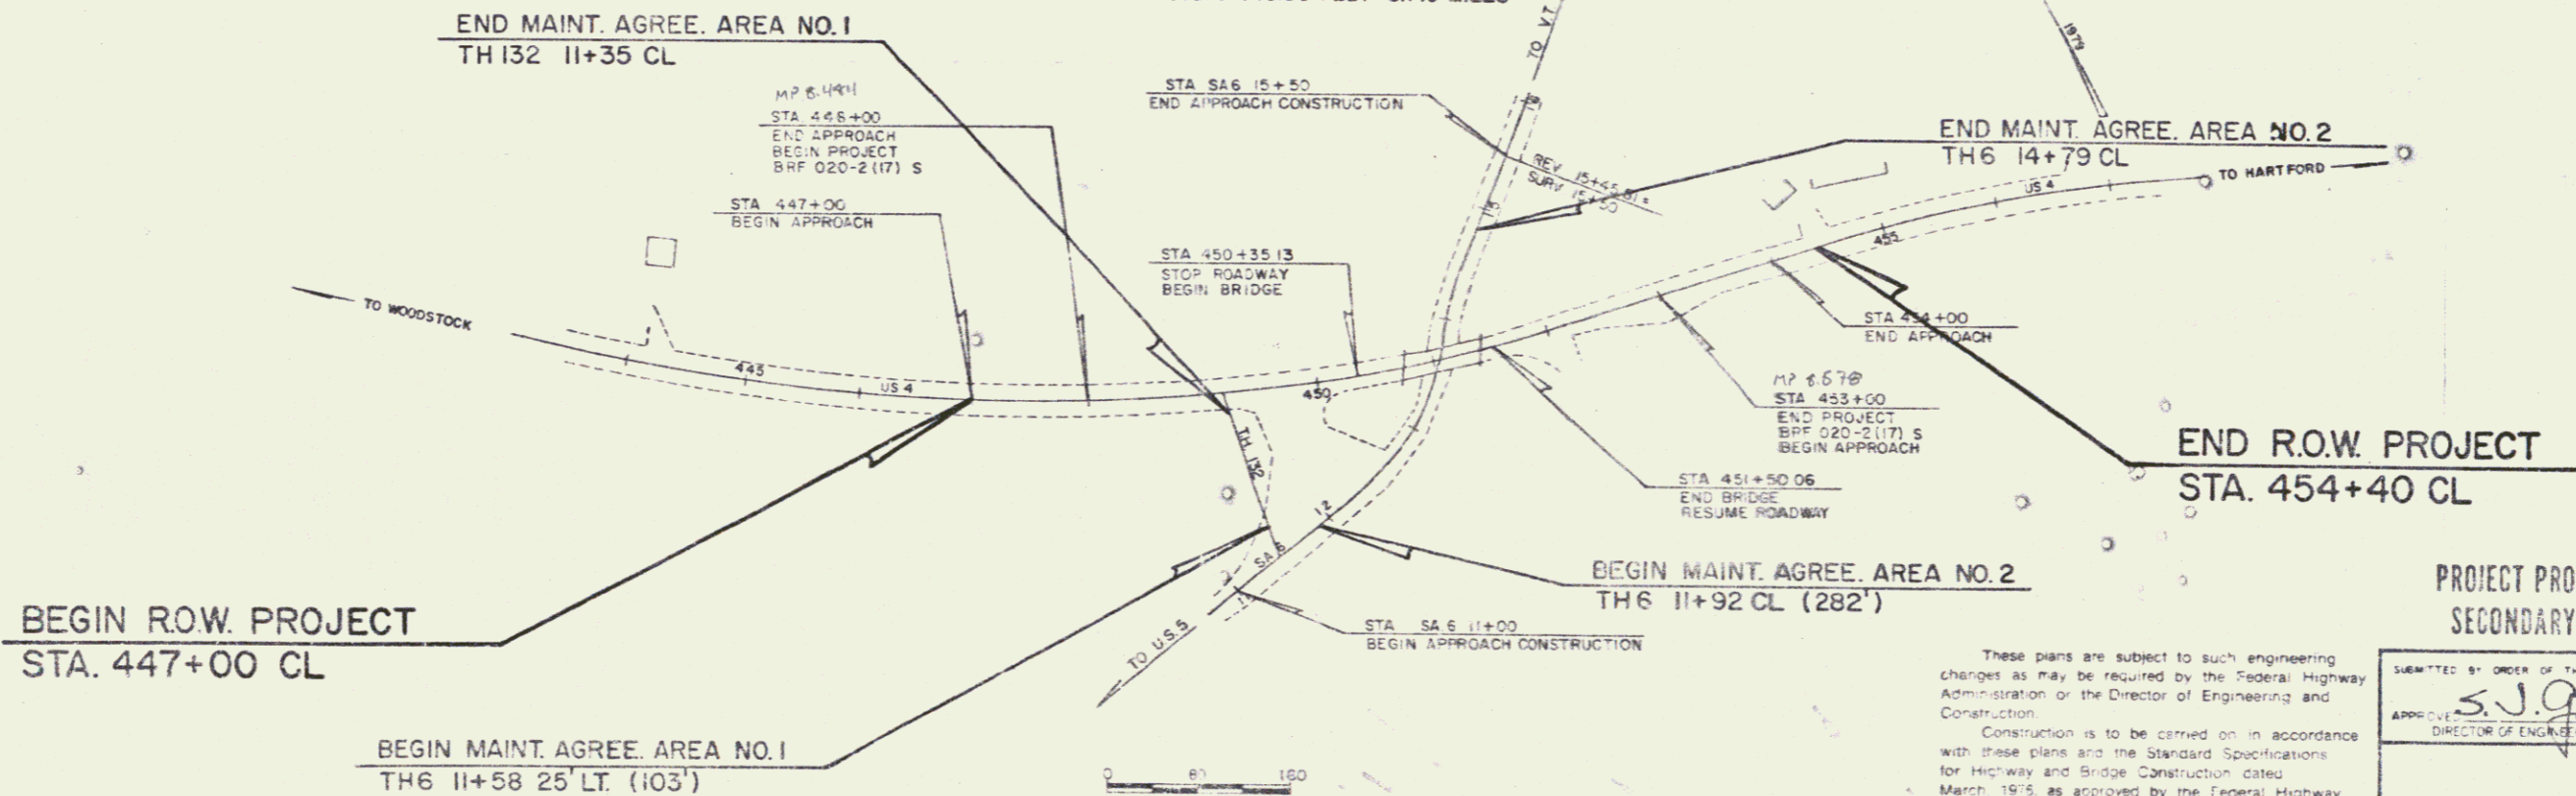


CONVENTIONAL SIGNS

COUNTY LINE	---
TOWN LINE	----
LIMITS OF ACCESS	-----
POINT OF ACCESS	X
FENCE LINE	=====
STONE WALL	-----
TRAVELED 40'	-----
RAILROAD	-----
RAILROAD	-----
SURVEY LINE	-----
CULVERT	-----
POWER POLE	○
TELEPHONE POLE	○
TREES	○
CONTROL OF ACCESS	///
PROPERTY LINE	-----
R.O.W. TAKING LINE	○ SR ○
SLOPE RIGHTS	○
TOP OF CUT	○
TOE OF SLOPE	○

DATUM

VERTICAL	ASSUMED
HORIZONTAL	N/A

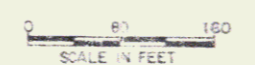

These plans are subject to such engineering changes as may be required by the Federal Highway Administration or the Director of Engineering and Construction.
Construction is to be carried on in accordance with these plans and the Standard Specifications for Highway and Bridge Construction dated March 1975, as approved by the Federal Highway Administration on October 27, 1976 for use on this project, including all subsequent revisions and such revised specifications and special provisions as are incorporated in these plans.

PROJECT PROCESSED UNDER
SECONDARY ROAD PLAN

SUBMITTED BY ORDER OF THE STATE TRANSPORTATION BOARD
APPROVED: *S.J.P.* DATE 11-1-84
DIRECTOR OF ENGINEERING AND CONSTRUCTION

APPROVED: *R. J. ...* DATE 10-27-84
CHIEF, PROPERTY ADMINISTRATION

PROJECT HARTFORD BRF 020-2 (17) S
SHEET 1 OF 8 SHEETS

JUN 6 1986 4