


Trench Trench Sump
 444+00 - 444+00 LT
 444+00 - 444+00 LT
 444+00 - 444+00 LT
 444+00 - 444+00 LT

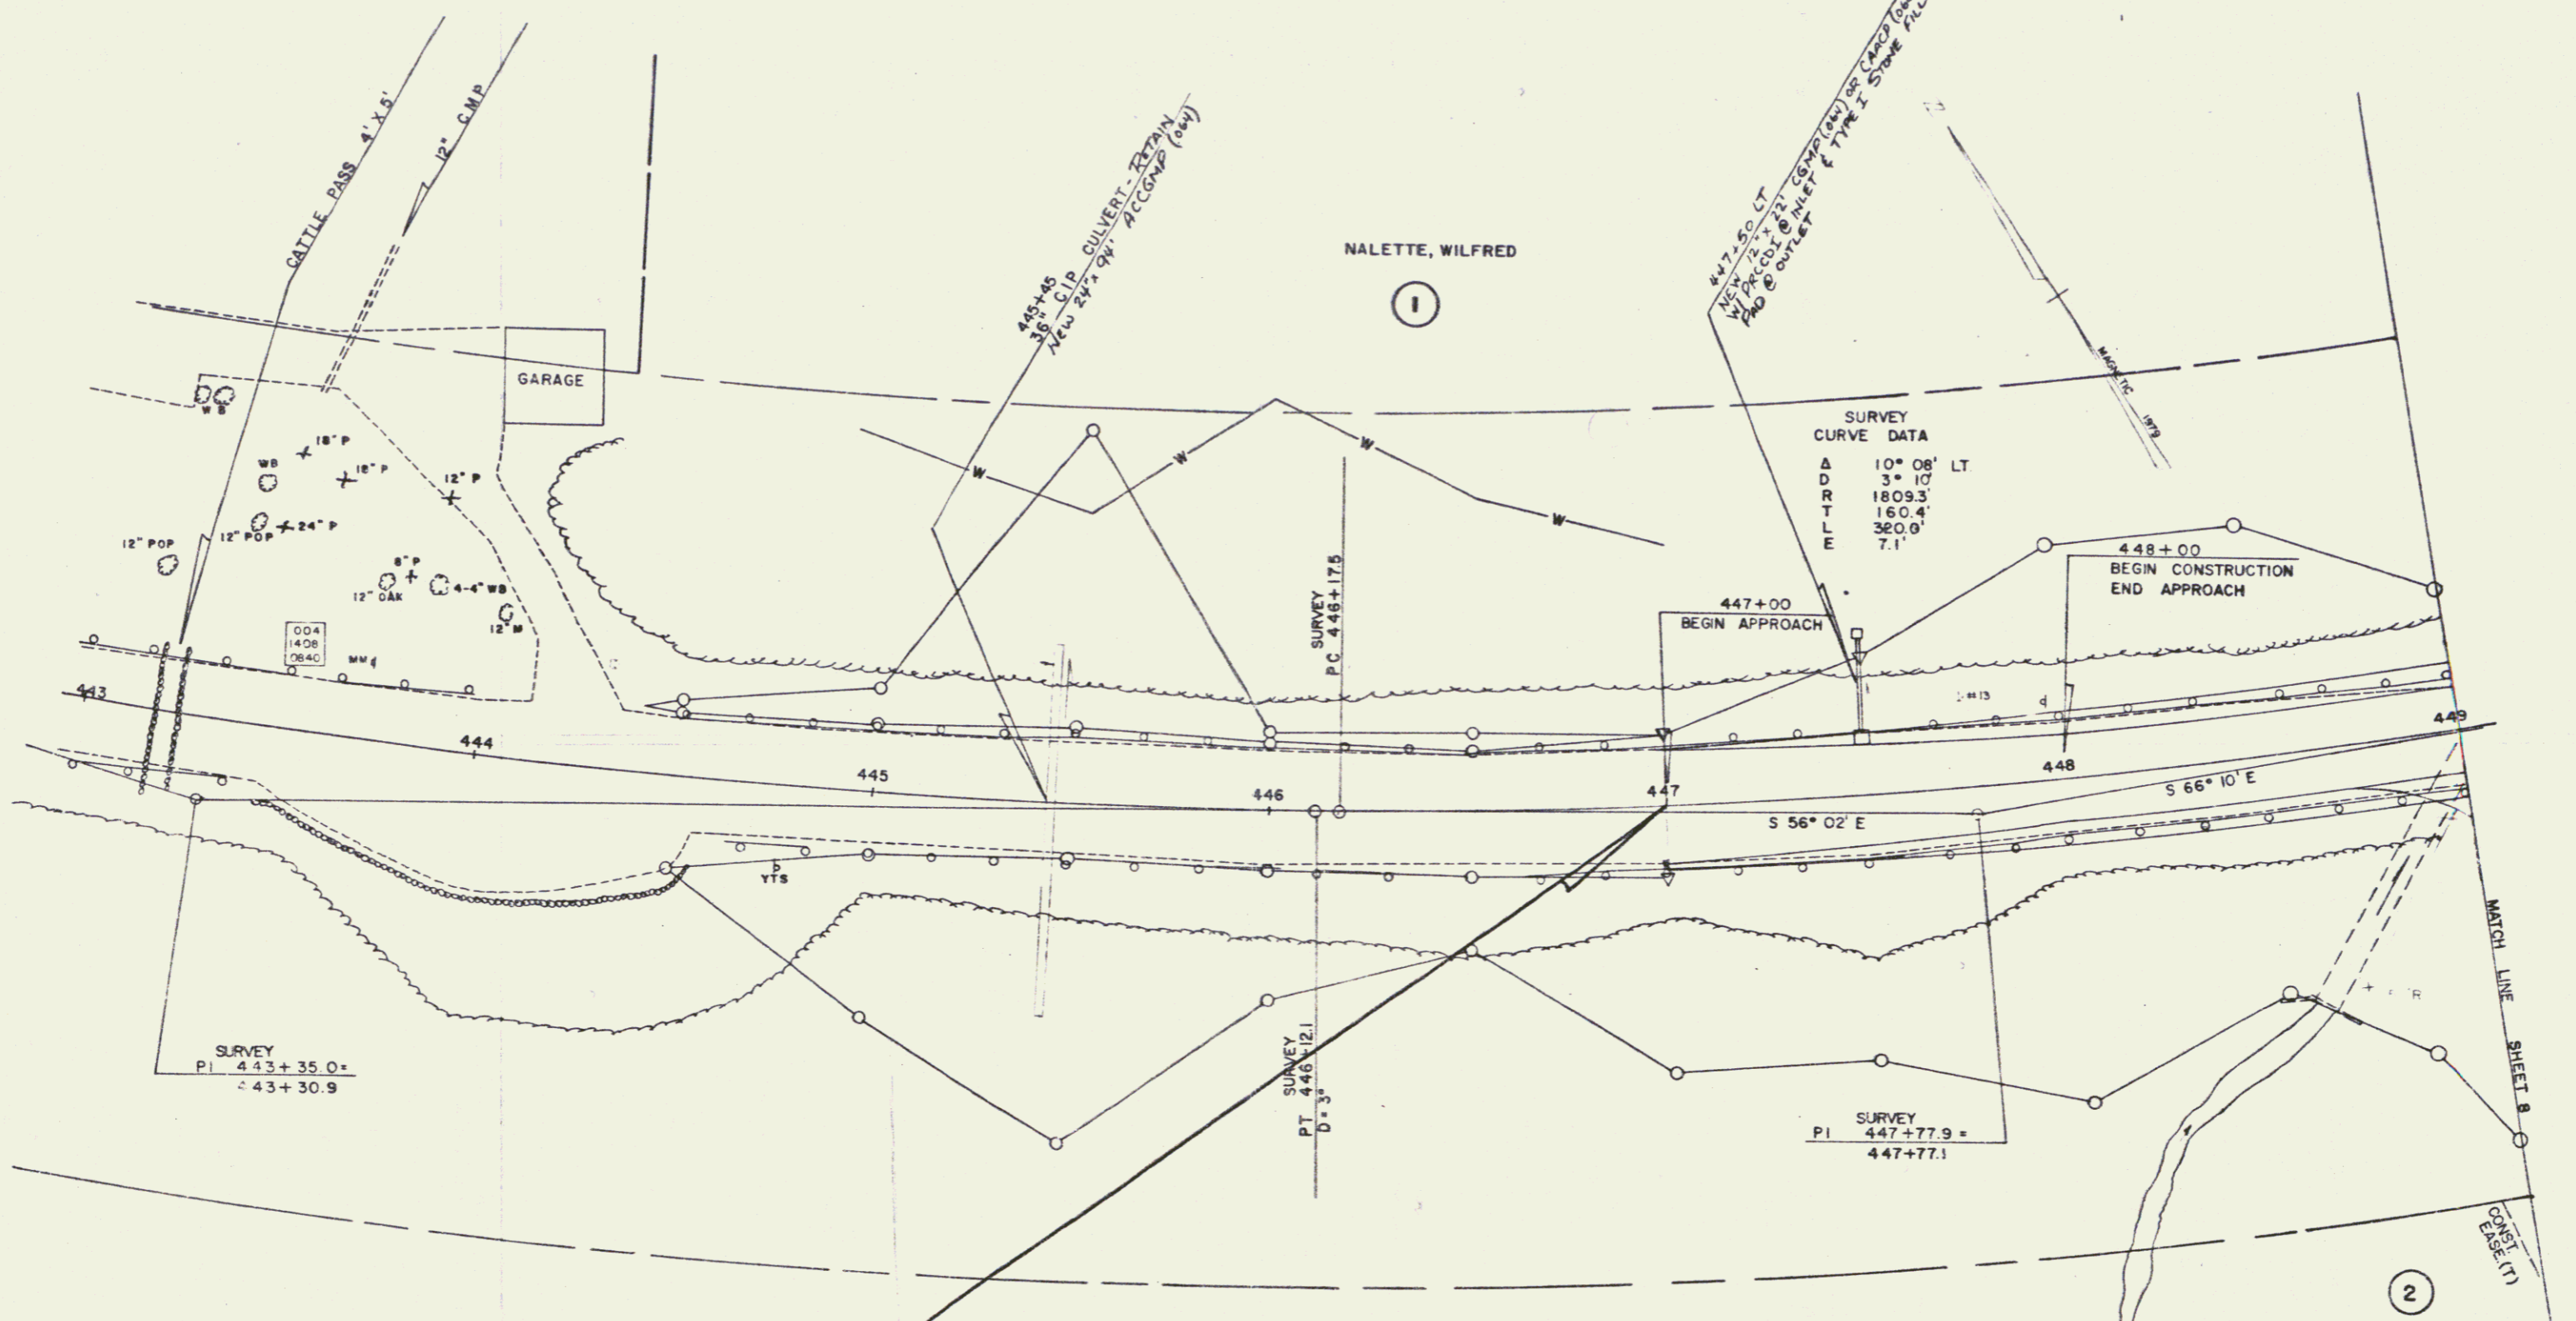


SURVEY CURVE DATA

A	10° 08' LT
D	3° 10'
R	1809.3'
T	160.4'
L	260.0'
E	7.1'

BEGIN R.O.W. PROJECT
 STA. 447+00 CL

MCINTYRE, NORMAN H.
 & SHIRLEY R.

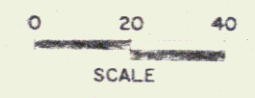

STAGE II CONSTRUCTION

SURVEYED BY	FANTONI	DATE	8-79
DRAWN BY	NEWMAN	DATE	10-79
TRACED BY	NEWMAN	DATE	10-79

HARTFORD
 PROJ. BR# NO. 020-2(17) S
 SHEET 7 OF 8

JUN 6 1986

5